





SCALE BAR 1:100



© FSL GROUP Property & Copyright. Use of drawings is not permitted nor can they be copied, duplicated or distributed without the consent of FSL Group. All designs are the sole property of FSL Group, and may not be used, transferred, or disclosed to a third party without the express permission of FSL Group. Electronic copies of this drawing are supplied for convenience only. No dimensions or other information should be used from the electronic copy.

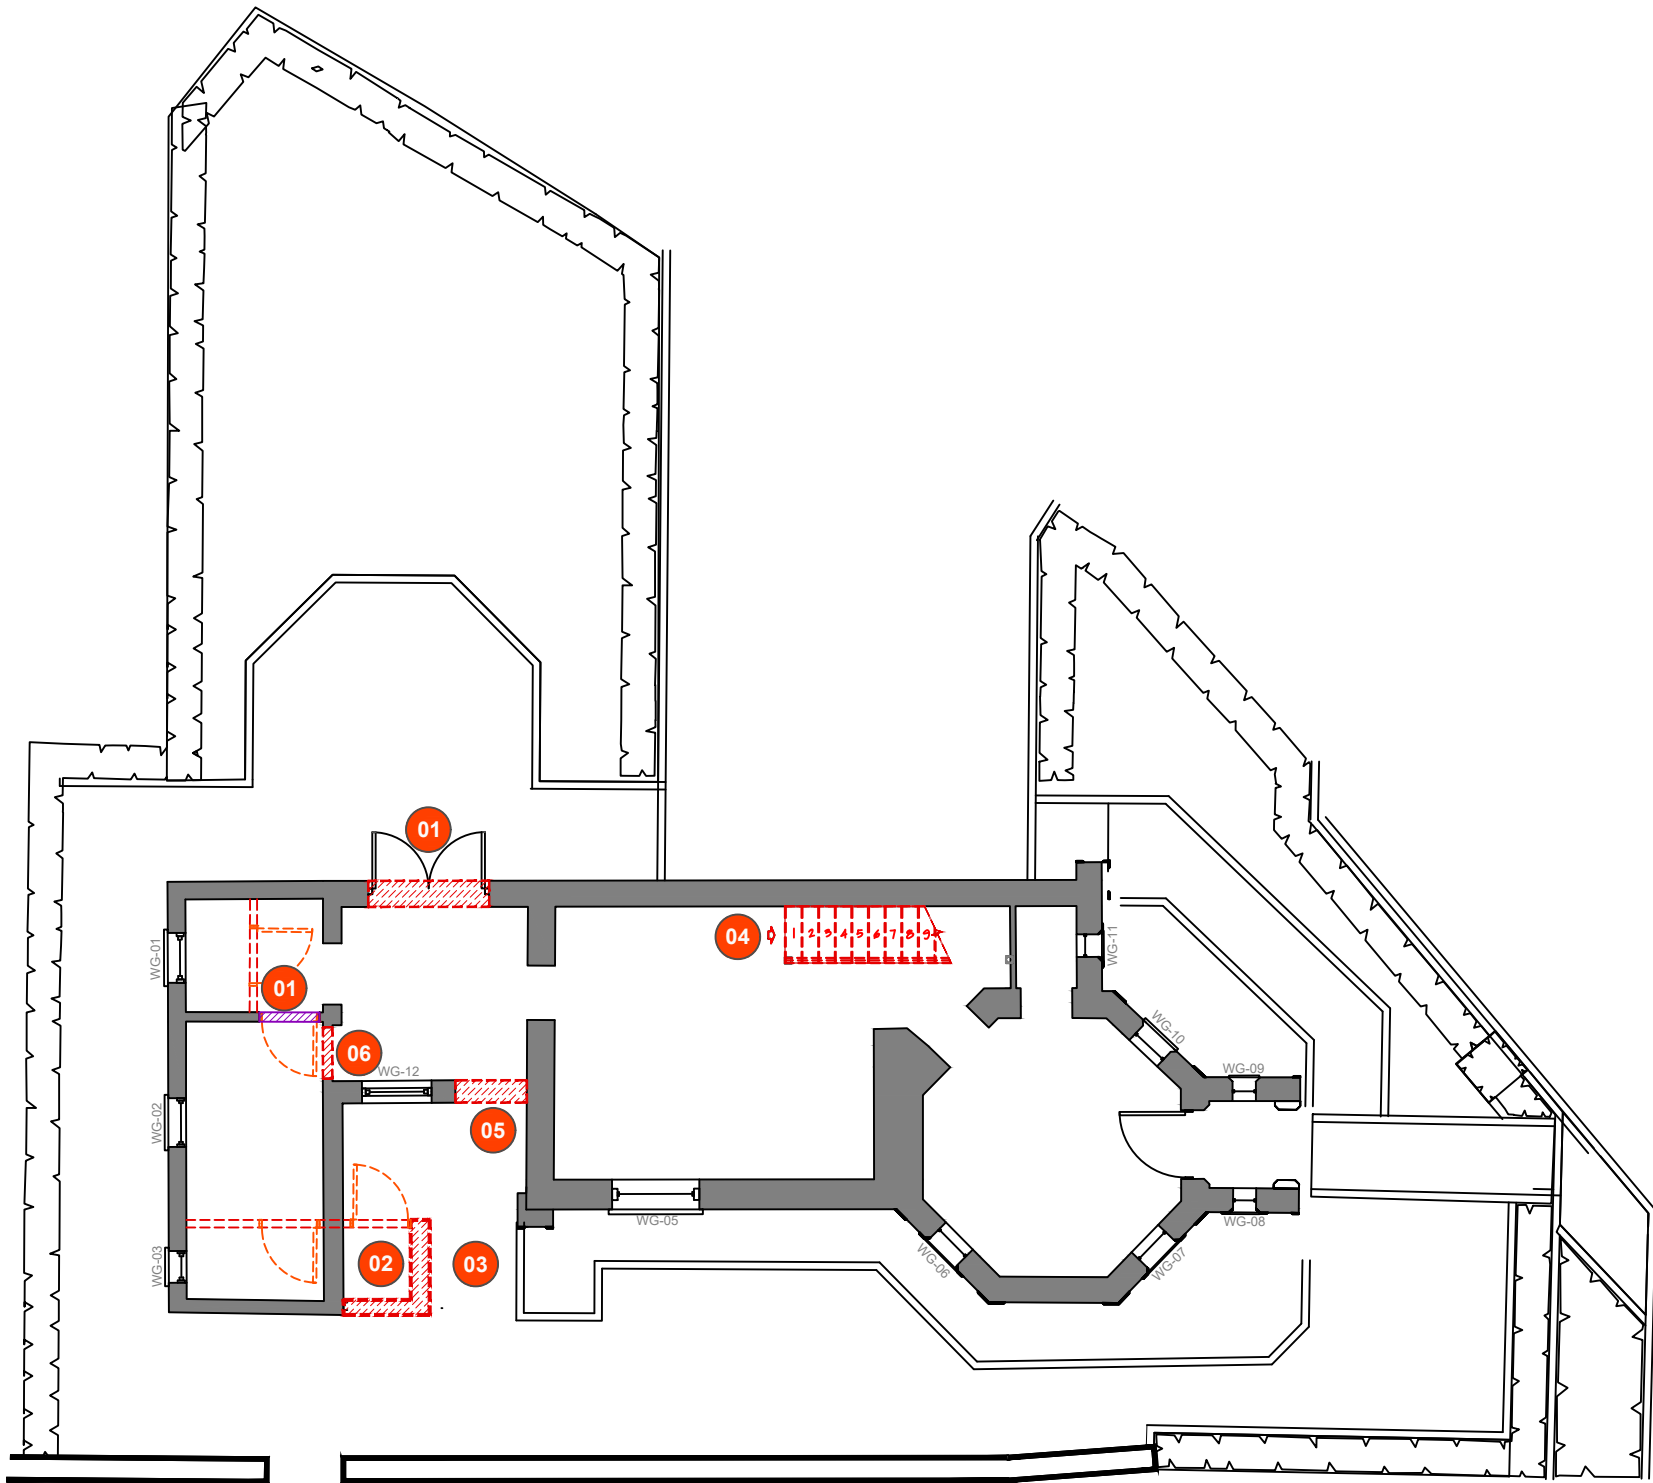

Lodge - Ground Floor
[Proposed alterations to existing]
Scale 1:100@A1

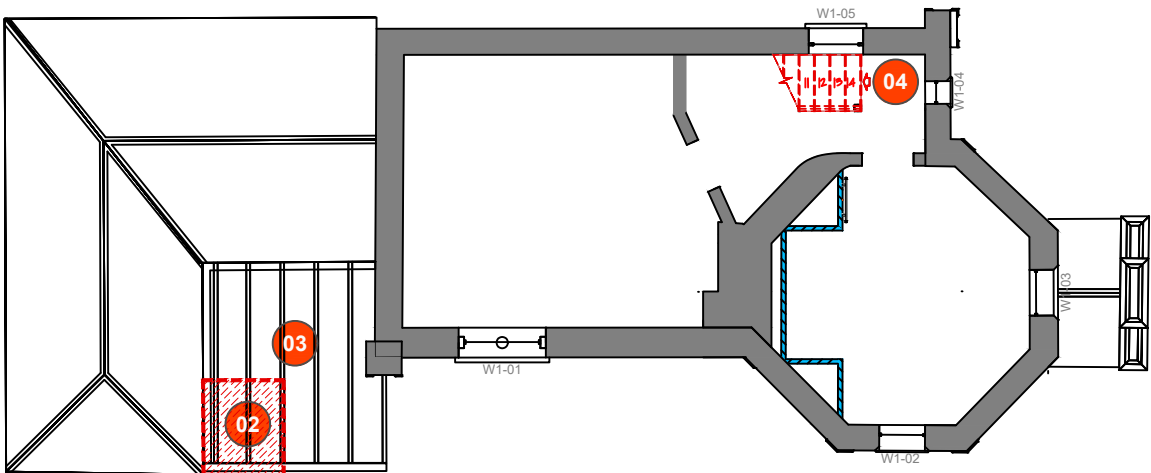

Lodge - First Floor
[Proposed alterations to existing]
Scale 1:100@A1

Existing / Demo / Infill Legend	
	Demo existing door
	Demo existing partition
	Demo Structural Wall
	New Door
	Existing Door
	Existing Structural Wall
	Infill Structural Wall

LEGEND	
Gate Lodge	Refer key for further detail of proposed alterations to existing building fabric
01	New opening in wall for entrance doors & internal door
02	Outdoor store to be demolished
03	New flat roof kitchen extension to be constructed
04	Existing staircase, balustrade & handrails to be removed and replaced for new.
05	Door to be removed with opening retained
06	Create new opening for new door.

C	Minor amendments	HC	CMH	22.08.23
B	Planning Drawing Up Issue	HC	CMH	14.08.23
A	Planning Drawing Up Issue	HJC	CMH	19/11/20
Rev.	Description:	Drawn:	Checked:	Date:

Drawing Status:

FOR PLANNING APPROVAL

CONCEPT - TENDER - APPROVAL - CONTRACT - CONSTRUCTION - AS BUILT

M4, The Millennium Centre,
Crosby Way, Farnham
Surrey GU9 7XX
+44 (0)1252 745200
info@fsl-group.co.uk
www.fsl-group.co.uk

Client:	Site Address:
Bargate Homes	Southleigh Park House Havant PO9 2PE

Floor & Drawing:
**Gate Lodge Ground & First Floor
Conservations Alterations GA**

Drawing Number:
28473 — LODGE — GA-C — C

Produced By: HJC
Creation Date: 18/11/20
Scale: SCALE 1:100@A1

Drawing Notes: Figured dimensions only are to be taken from this drawing - DO NOT SCALE. Contractors must verify all dimensions prior to construction and any discrepancies are to be reported.Design © FSL Group