



SECTION
Fire/acoustic treatment to floors (first floor only)
Scale 1:5

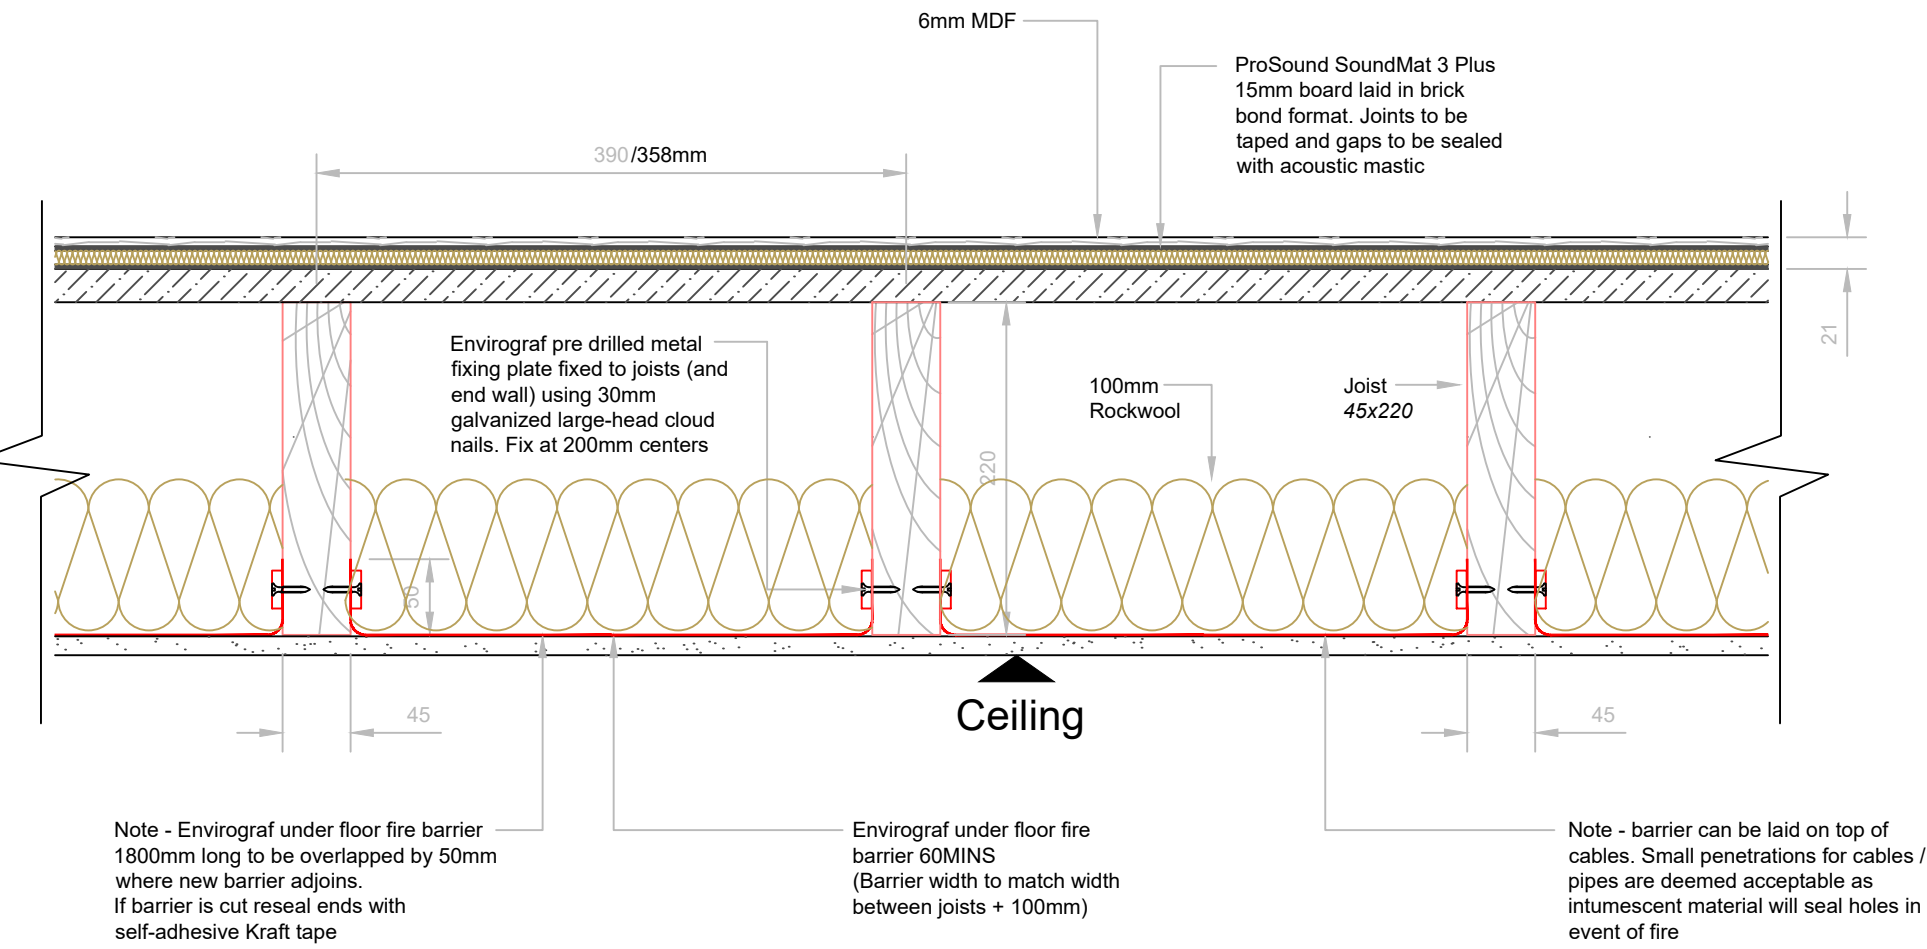


SECTION
Carpet gripper detail
Scale 1:2

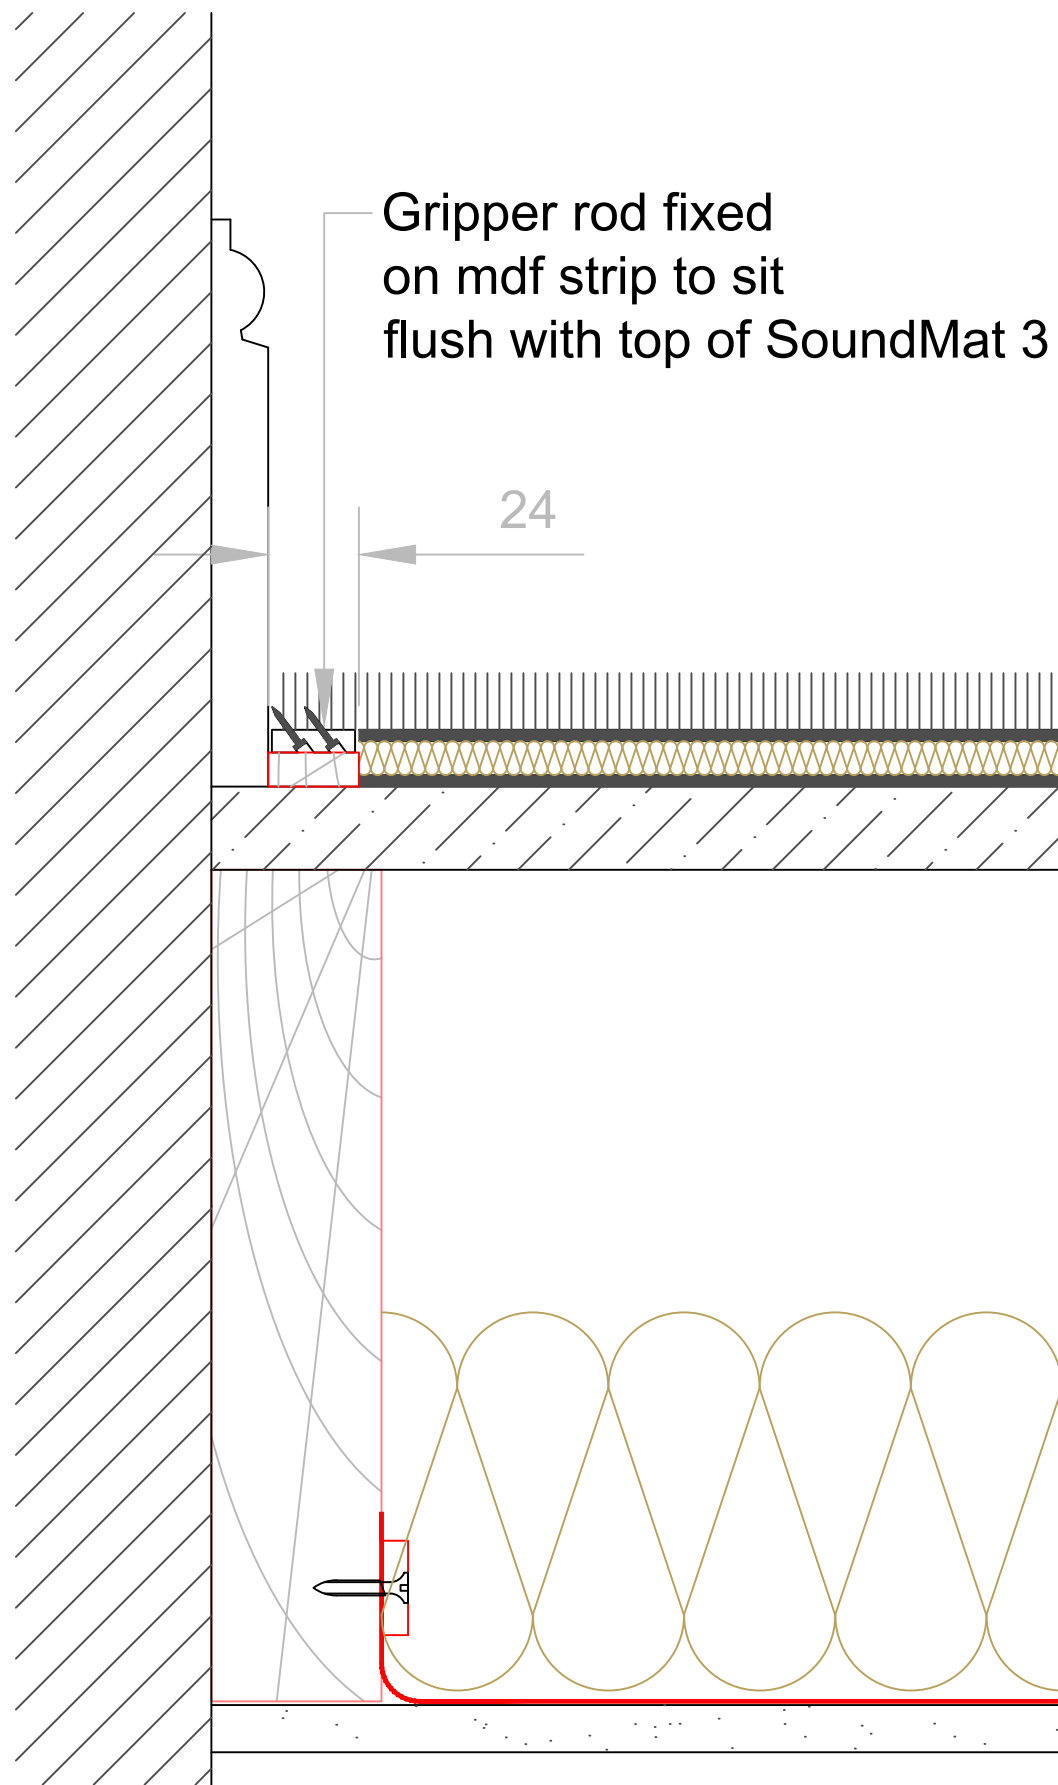

CONSERVATION
DETAIL 02
DETAIL FOR COMMENT / APPROVAL

NOTE:
All partitions, dry lining and ceilings to be built in accordance with the material and installation method referenced in the latest edition of the white book. Any details not described in the white book or on these drawings should be discussed with the office first for approval before build commencement.

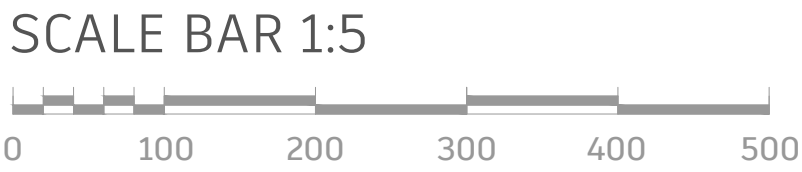

Minor amendments		HC	CMH	22.08.23
B	Conservation alteration Up Issue	HC	CMH	21.08.23
Rev:	Description:	Drawn:	Checked:	Date:
Drawing Status:				
PLANNING				
CONCEPT - TENDER - APPROVAL - CONTRACT - CONSTRUCTION - AS BUILT				
		M4, The Millennium Centre, Crosby Way, Farnham Surrey GU9 7XX +44 (0)1252 745200 info@fsl-group.co.uk www.fsl-group.co.uk		
Client:		Site Address:		
Bargate Homes		Southleigh Park House Havant PO9 2PE		
Floor & Drawing:				
Acoustic Floor Upgrade Detail				
Drawing Number:				
28473		Gen	DT02	C
Project Number		Building	Drawing Code	Revision
Produced By:		HJC		
Creation Date:		14/12/20		
Scale:		SCALE 1:5@A1		
Drawing Notes: Figured dimensions only are to be taken from this drawing - DO NOT SCALE. Contractors must verify all dimensions prior to construction and any discrepancies are to be reported.Design © FSL Group				