
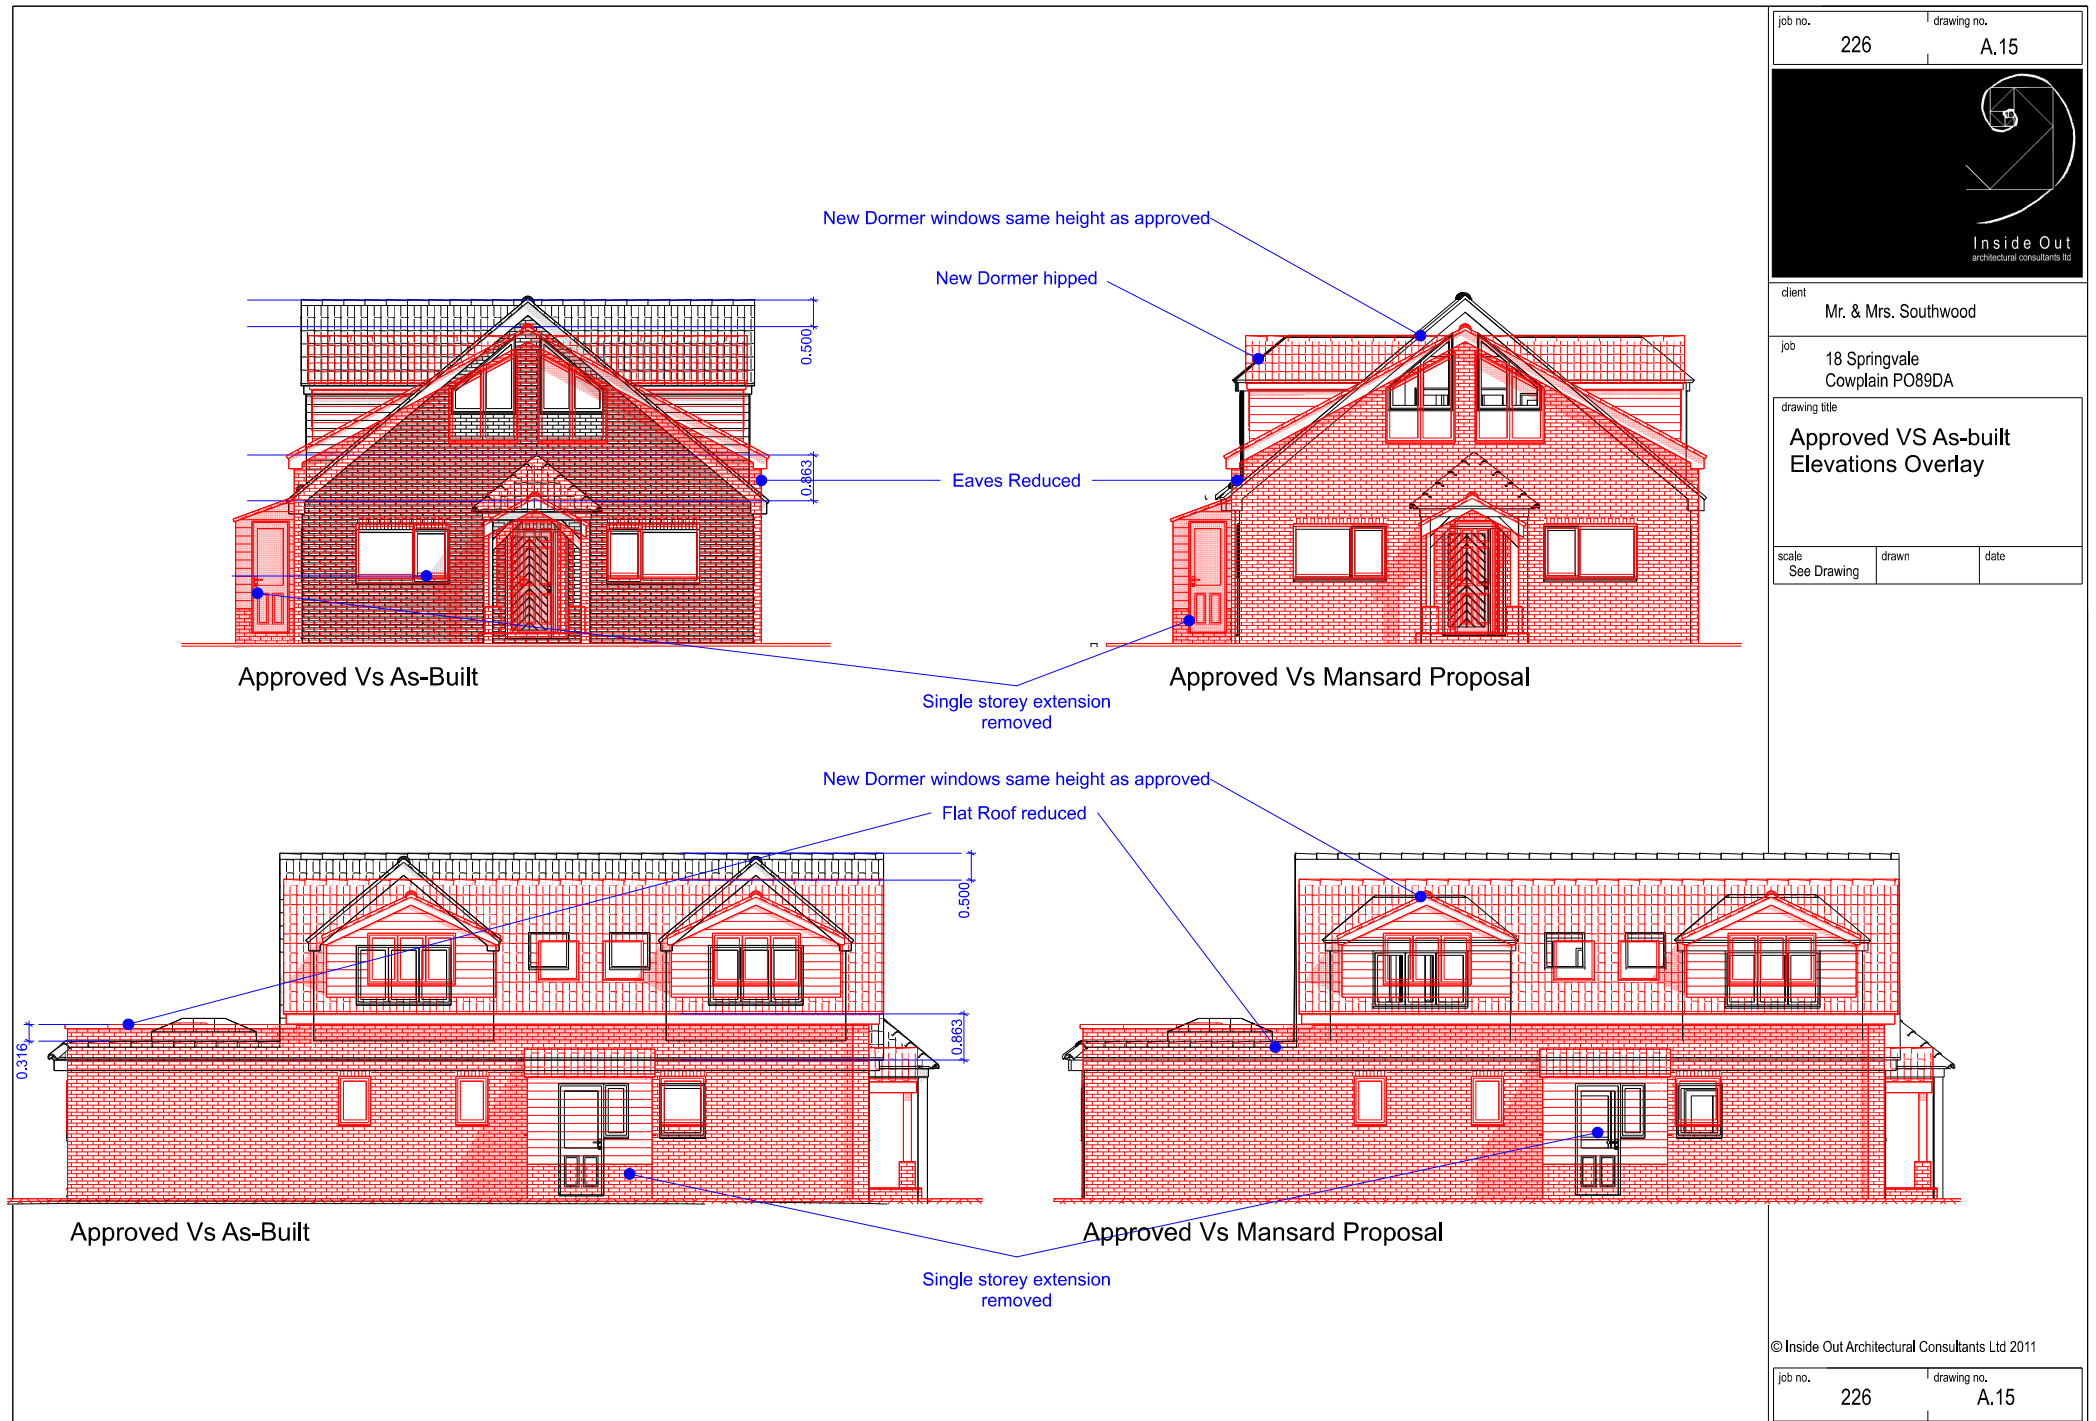


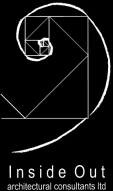

job no.	226	drawing no.	A.15
			
client	Mr. & Mrs. Southwood		
job	18 Springvale Cowplain PO89DA		
drawing title	Approved VS As-built Elevations Overlay		
scale	See Drawing	drawn	date
© Inside Out Architectural Consultants Ltd 2011			
job no.	226	drawing no.	A.15