



Dimensions to be checked on site before commencing work. Any discrepancies shall be reported to the architect immediately. Do not scale from these drawings except for planning purposes. Use figured dimensions only. Where applicable this drawing is to be read in conjunction with other consultants' drawings. Ordnance Survey Licence Number: 100045485.

This drawing is the copyright of Architectural and Associated Services
Existing beams, lintols and foundations carrying additional loads are to be exposed and local authority approved as requested
All walls to be demolished are to be checked for loadings prior to removal.

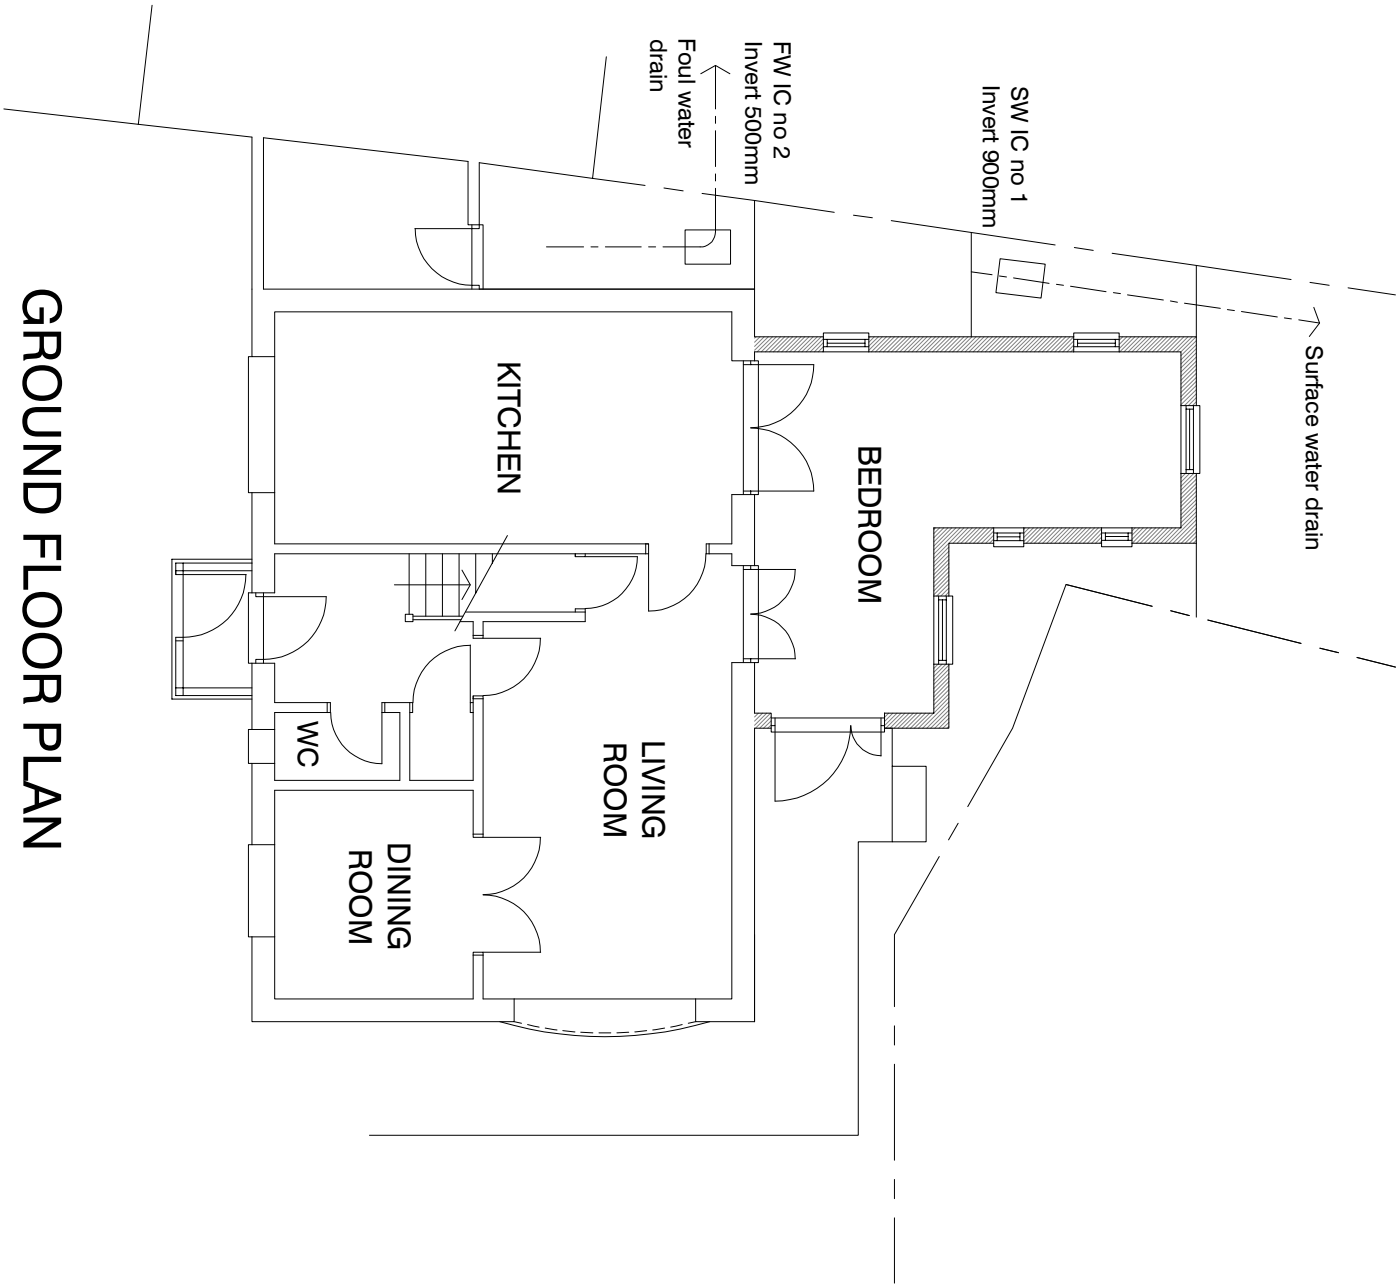

GROUND FLOOR PLAN

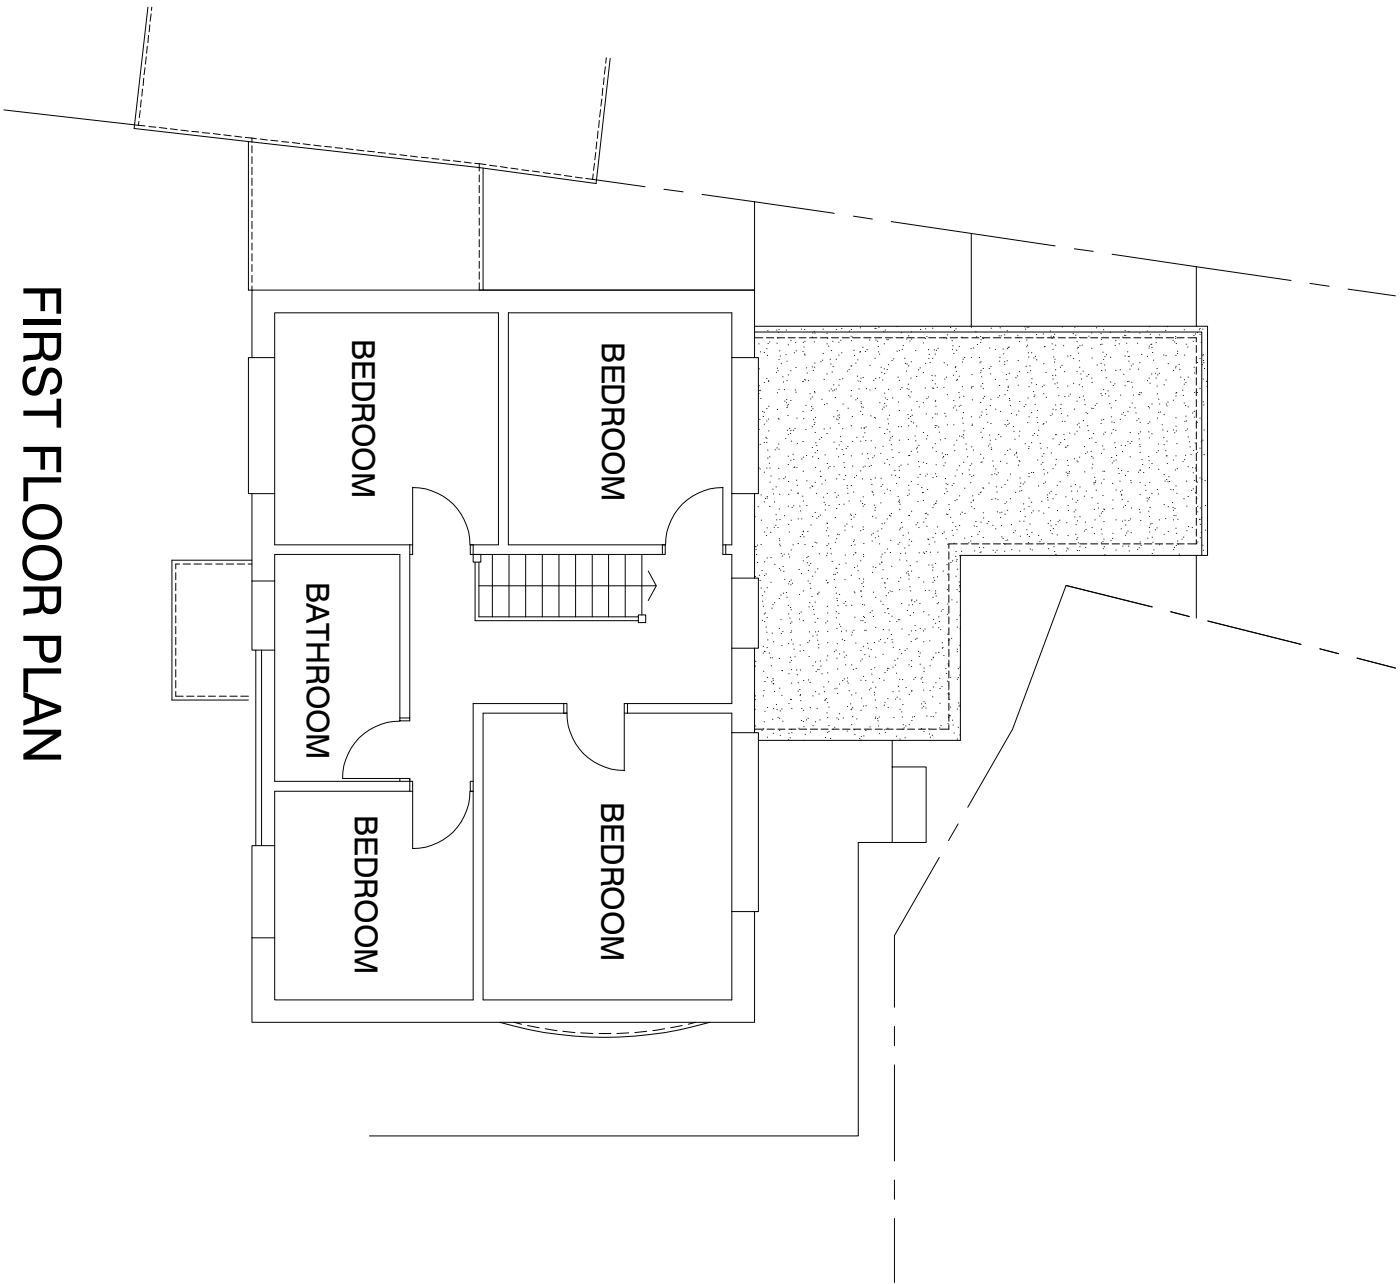

FIRST FLOOR PLAN

AAS

Ltd

ARCHITECTURAL and ASSOCIATED SERVICES Ltd

• PHILWEL • BEPTON ROAD

• BEPTON • MIDHURST

• WEST SUSSEX • GU29 9NB

• 07771 535021

• e-mail: chris@remmison.co.uk

Title

AS BUILT FLOOR PLANS

Rev	Date	Amendment		Project 33 ALAMEDA WAY, PURBROOK WATERLOOVILLE, HANTS, PO7 5HA
Date		Drawn	Scale	
May 2023		CPR	1:100 @ A3	
Job Number	Prefix	Drawing Number	Revision	
2023	PA	02	A	For MR AMJID YASIN