



SCALE BAR 1:100



© FSL GROUP Property & Copyright. Use of drawings is not permitted nor can they be copied, duplicated or distributed without the consent of FSL Group. All designs are the sole property of FSL Group, and may not be used, transferred, or disclosed to a third party without the express permission of FSL Group. Electronic copies of this drawing are supplied for convenience only. No dimensions or other information should be used from the electronic copy.

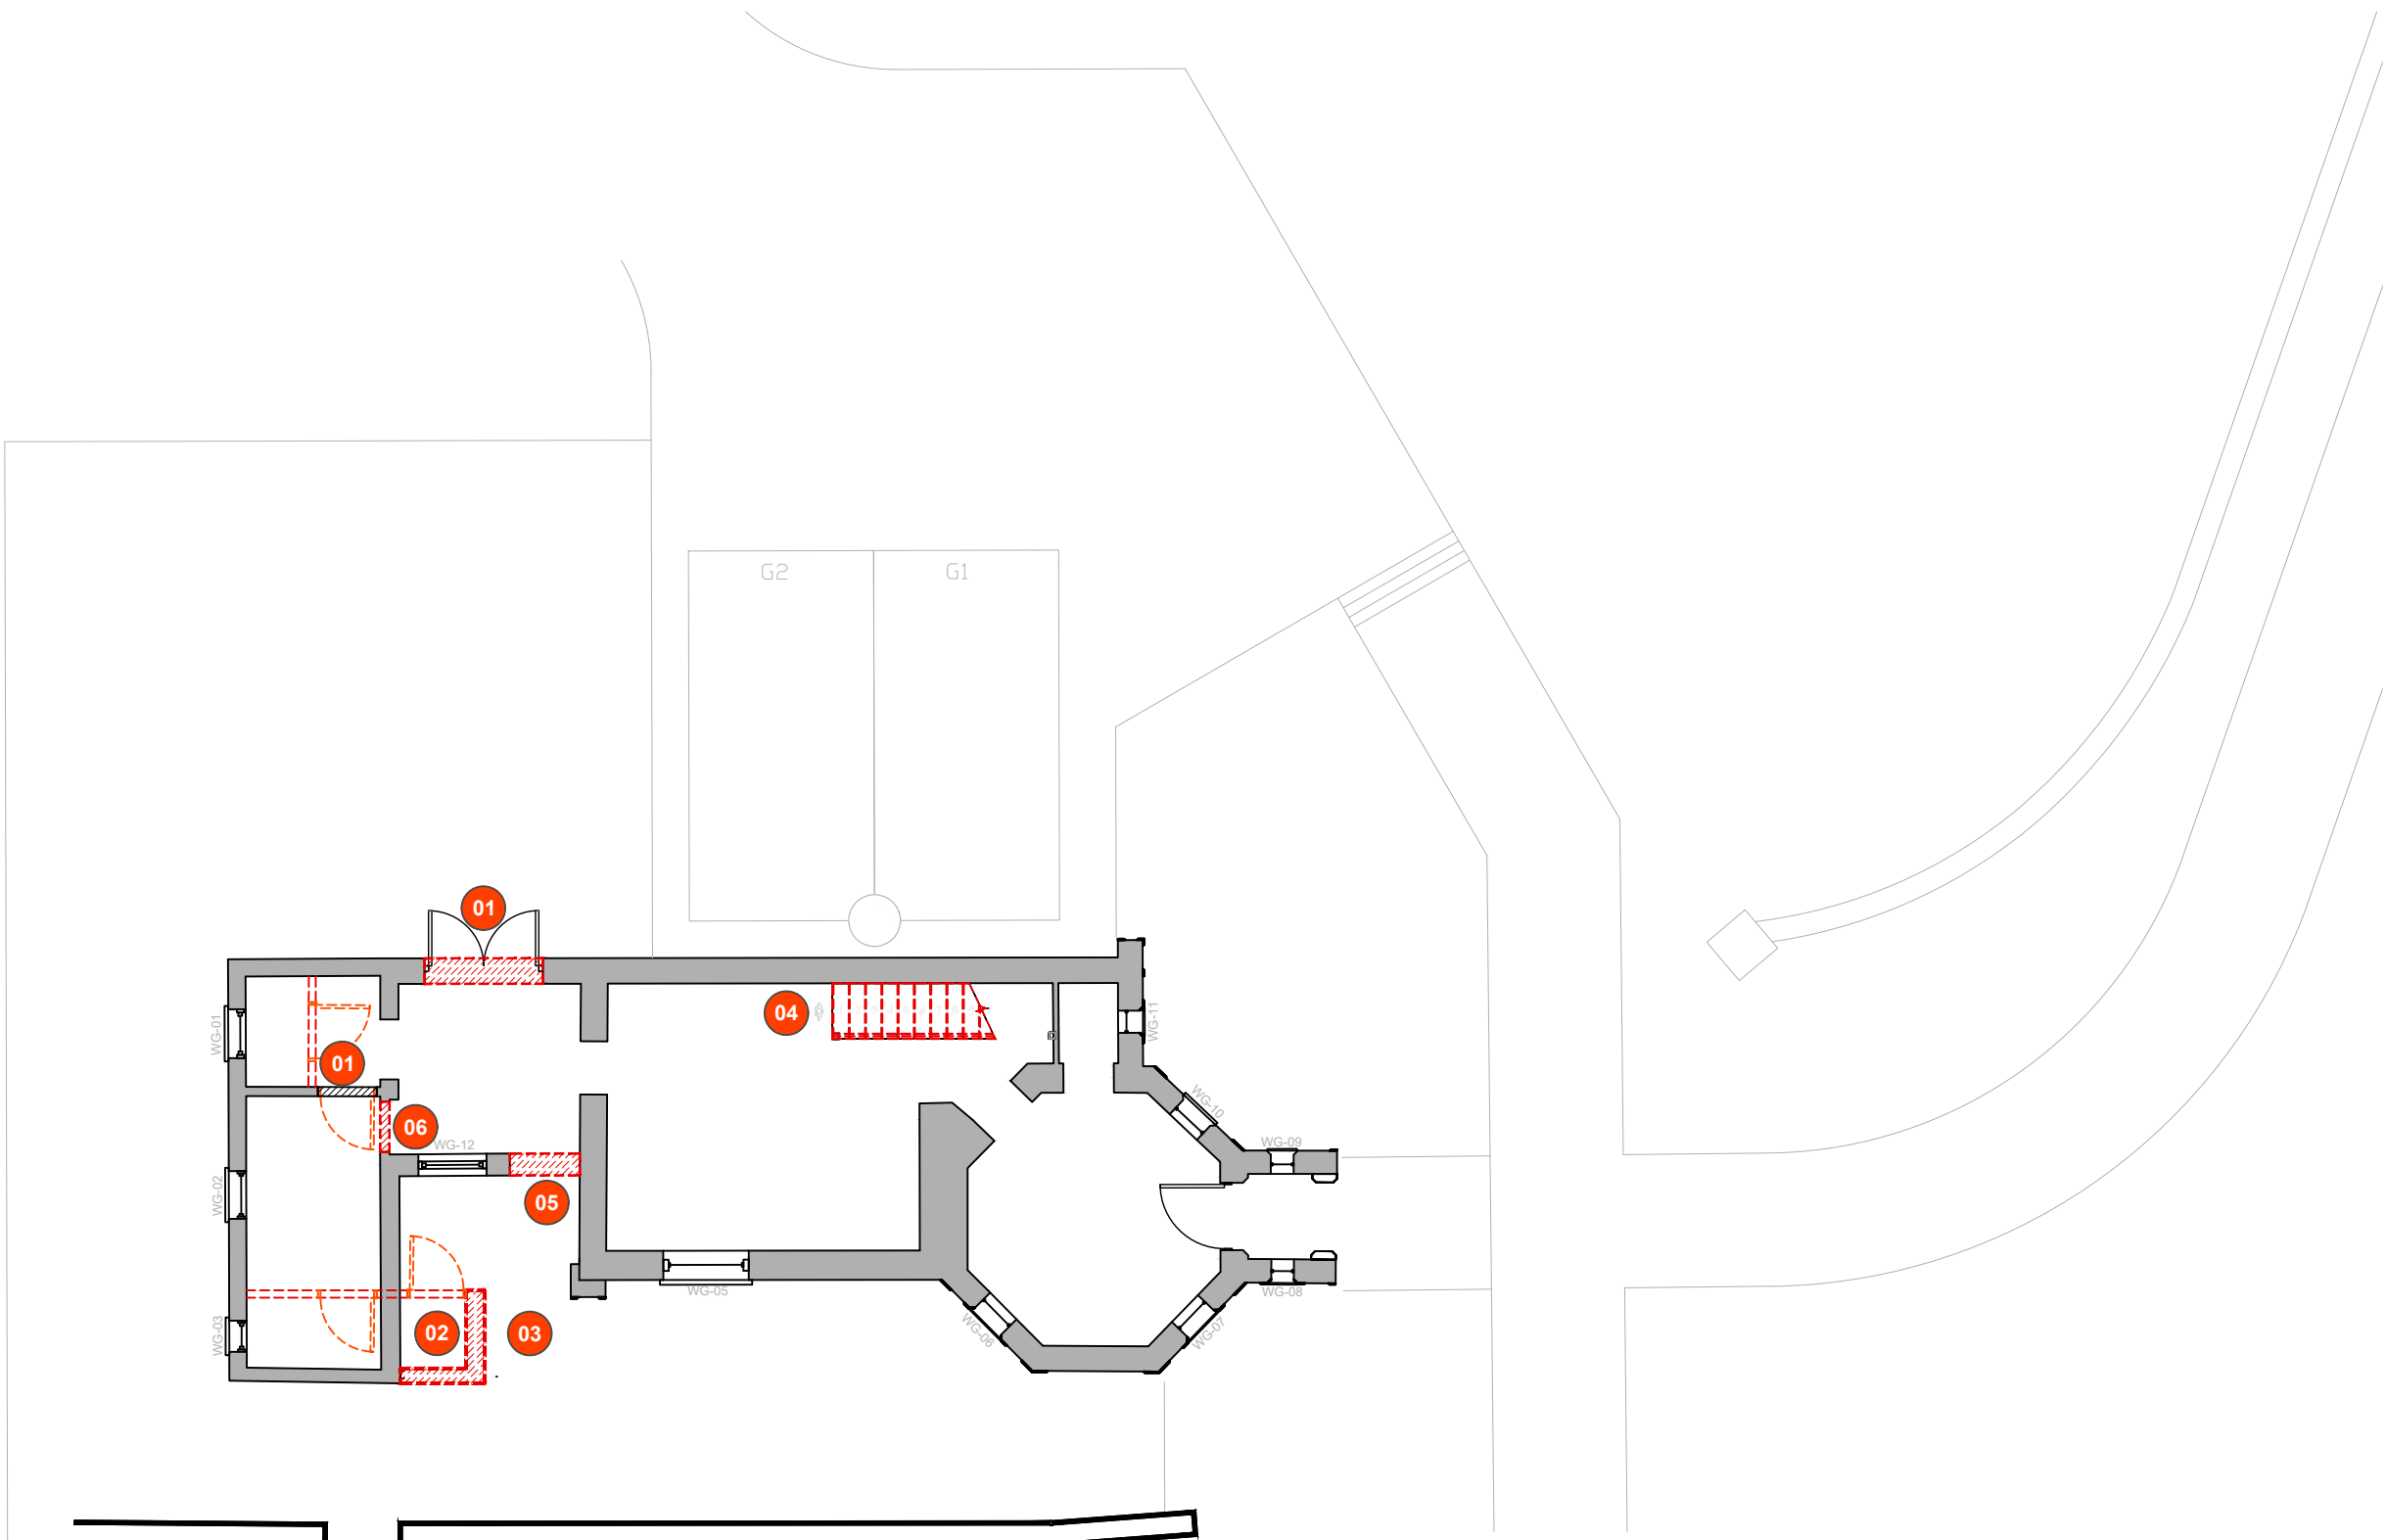

Lodge - Ground Floor
[Proposed alterations to existing]
Scale 1:100@A1

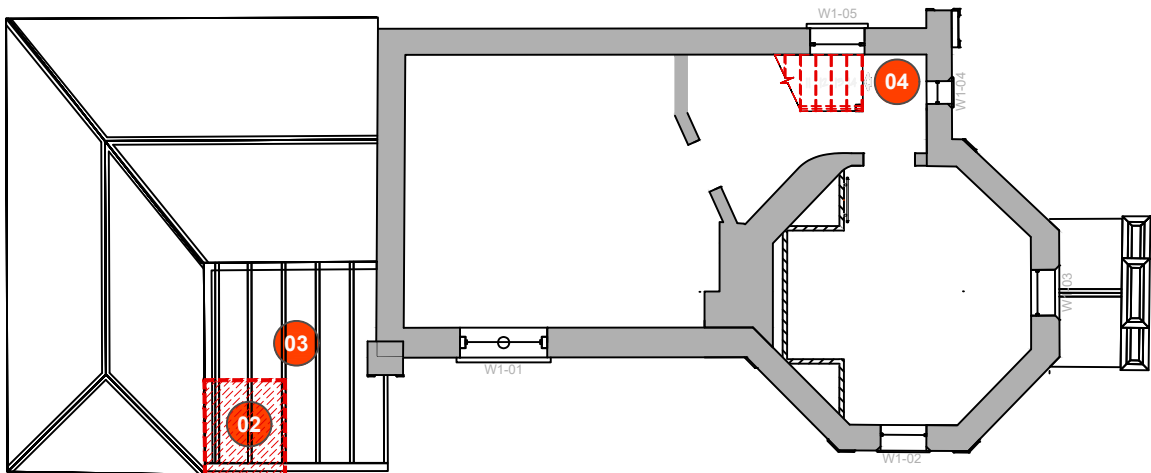

Lodge - First Floor
[Proposed alterations to existing]
Scale 1:100@A1

Existing / Demo / Infill Legend

Demo existing door

Demo existing partition

Demo Structural Wall

Existing Door

Existing Structural Wall

Infill Structural Wall

LEGEND

Gate Lodge

00

Refer key for further detail of proposed alterations to existing building fabric

01

New opening in wall for entrance doors & internal door

02

Outdoor store to be demolished

03

New flat roof kitchen extension to be constructed


04

Existing staircase, balustrade & handrails to be removed and replaced for new.

05

Door to be removed with opening retained

06

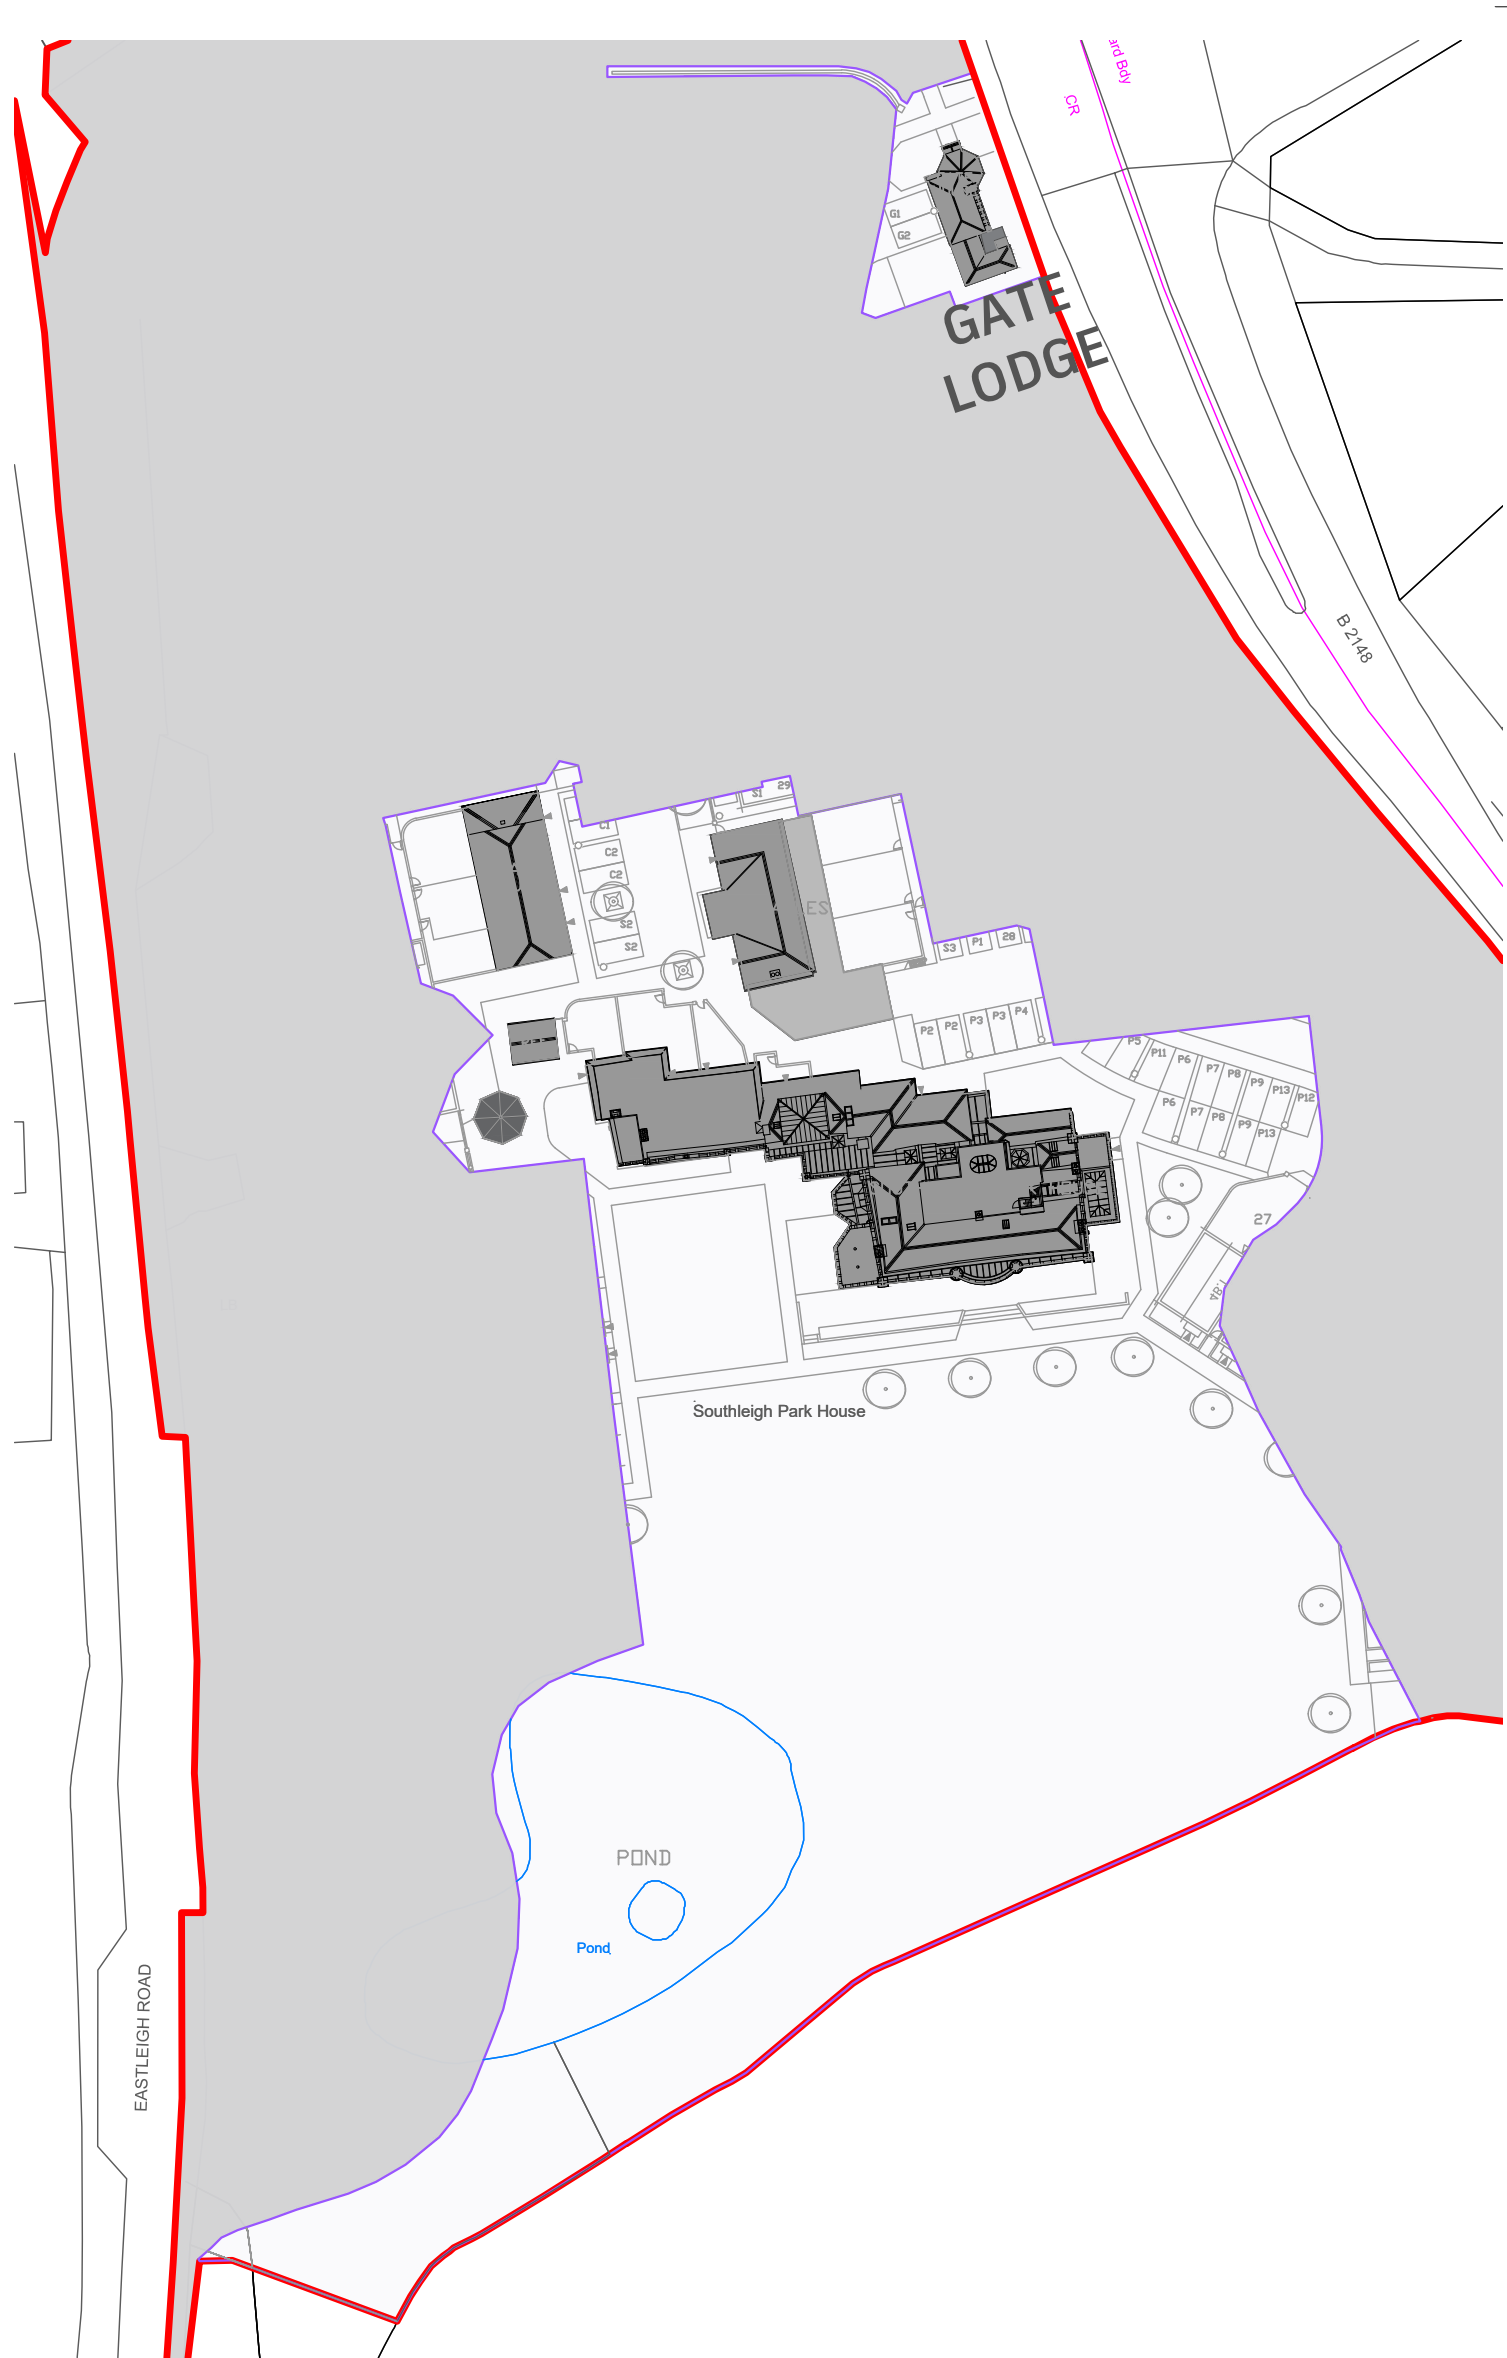Create new opening for new door.

Key Plan
Scale : NTS @ A1

Minor amendments		HC	CMH	22.08.23
B	Conservation Alterations Up Issue	CDM	CMH	21.08.23
Rev:	Description:	Drawn:	Checked:	Date:
Drawing Status:				
CONCEPT - TENDER - APPROVAL - CONTRACT - CONSTRUCTION - AS BUILT				
PLANNING				
		M4, The Millennium Centre, Crosby Way, Farnham Surrey GU9 7XX +44 (0)1252 745200 info@fsl-group.co.uk www.fsl-group.co.uk		
Client:		Site Address:		
Bargate Homes		Southleigh Park House Havant PO9 2PE		
Floor & Drawing:				
Gate Lodge Ground & First Floor Conservations Alterations GA				
Drawing Number:				
28473 — LODGE — C-GA — C				
Project Number		Building	Drawing Code	Revision
Produced By:		HJC		
Creation Date:		18/11/20		
Scale:		SCALE 1:100@A1		
Drawing Notes: Figured dimensions only are to be taken from this drawing - DO NOT SCALE. Contractors must verify all dimensions prior to construction and any discrepancies are to be reported.Design © FSL Group				