




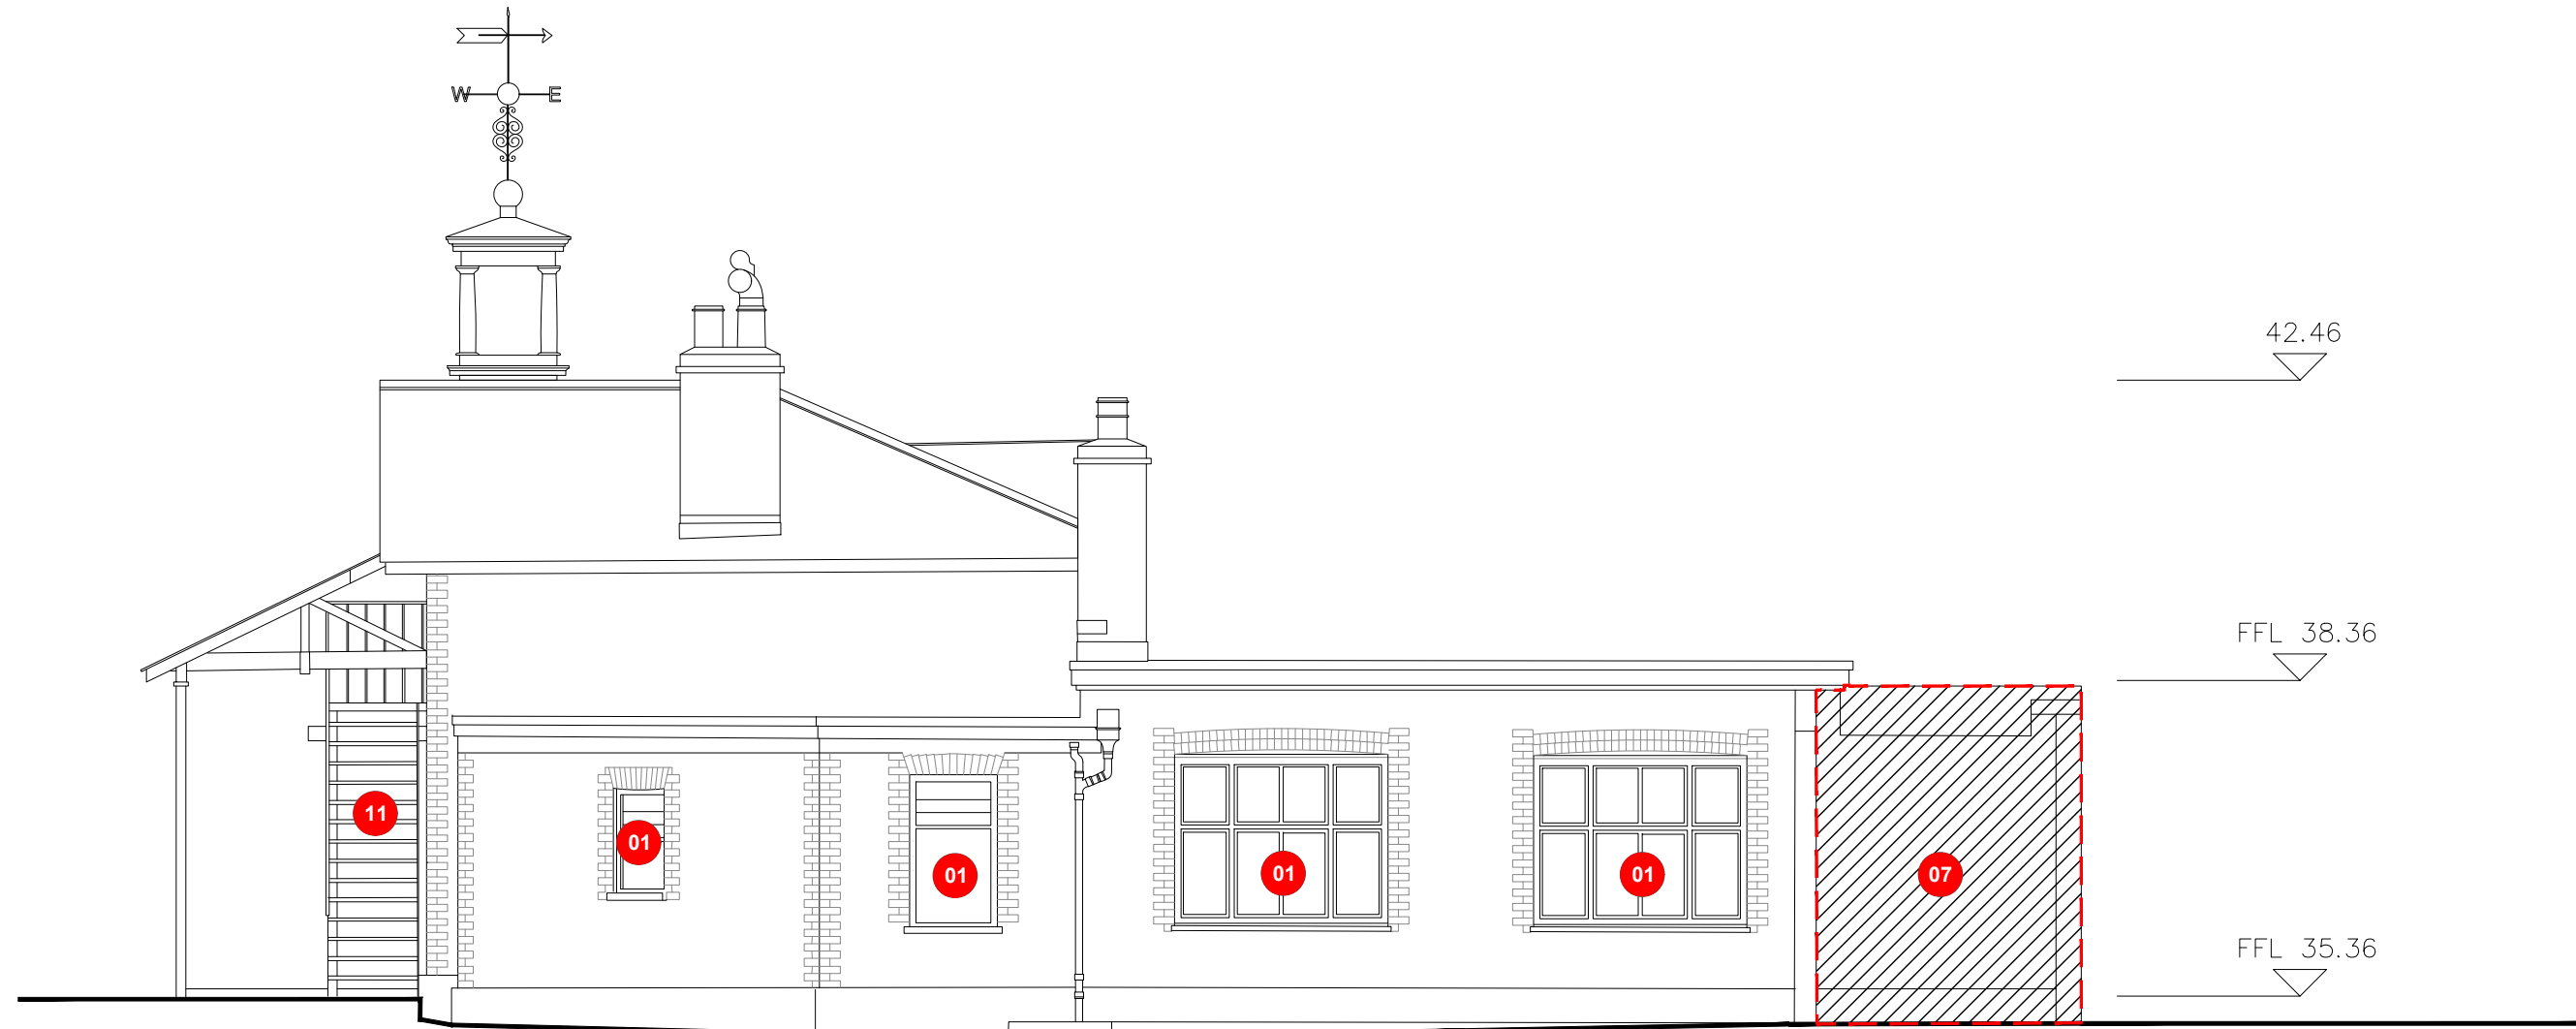

South Elevation
(Proposed alterations to existing)
Scale : 1:100 @ A1

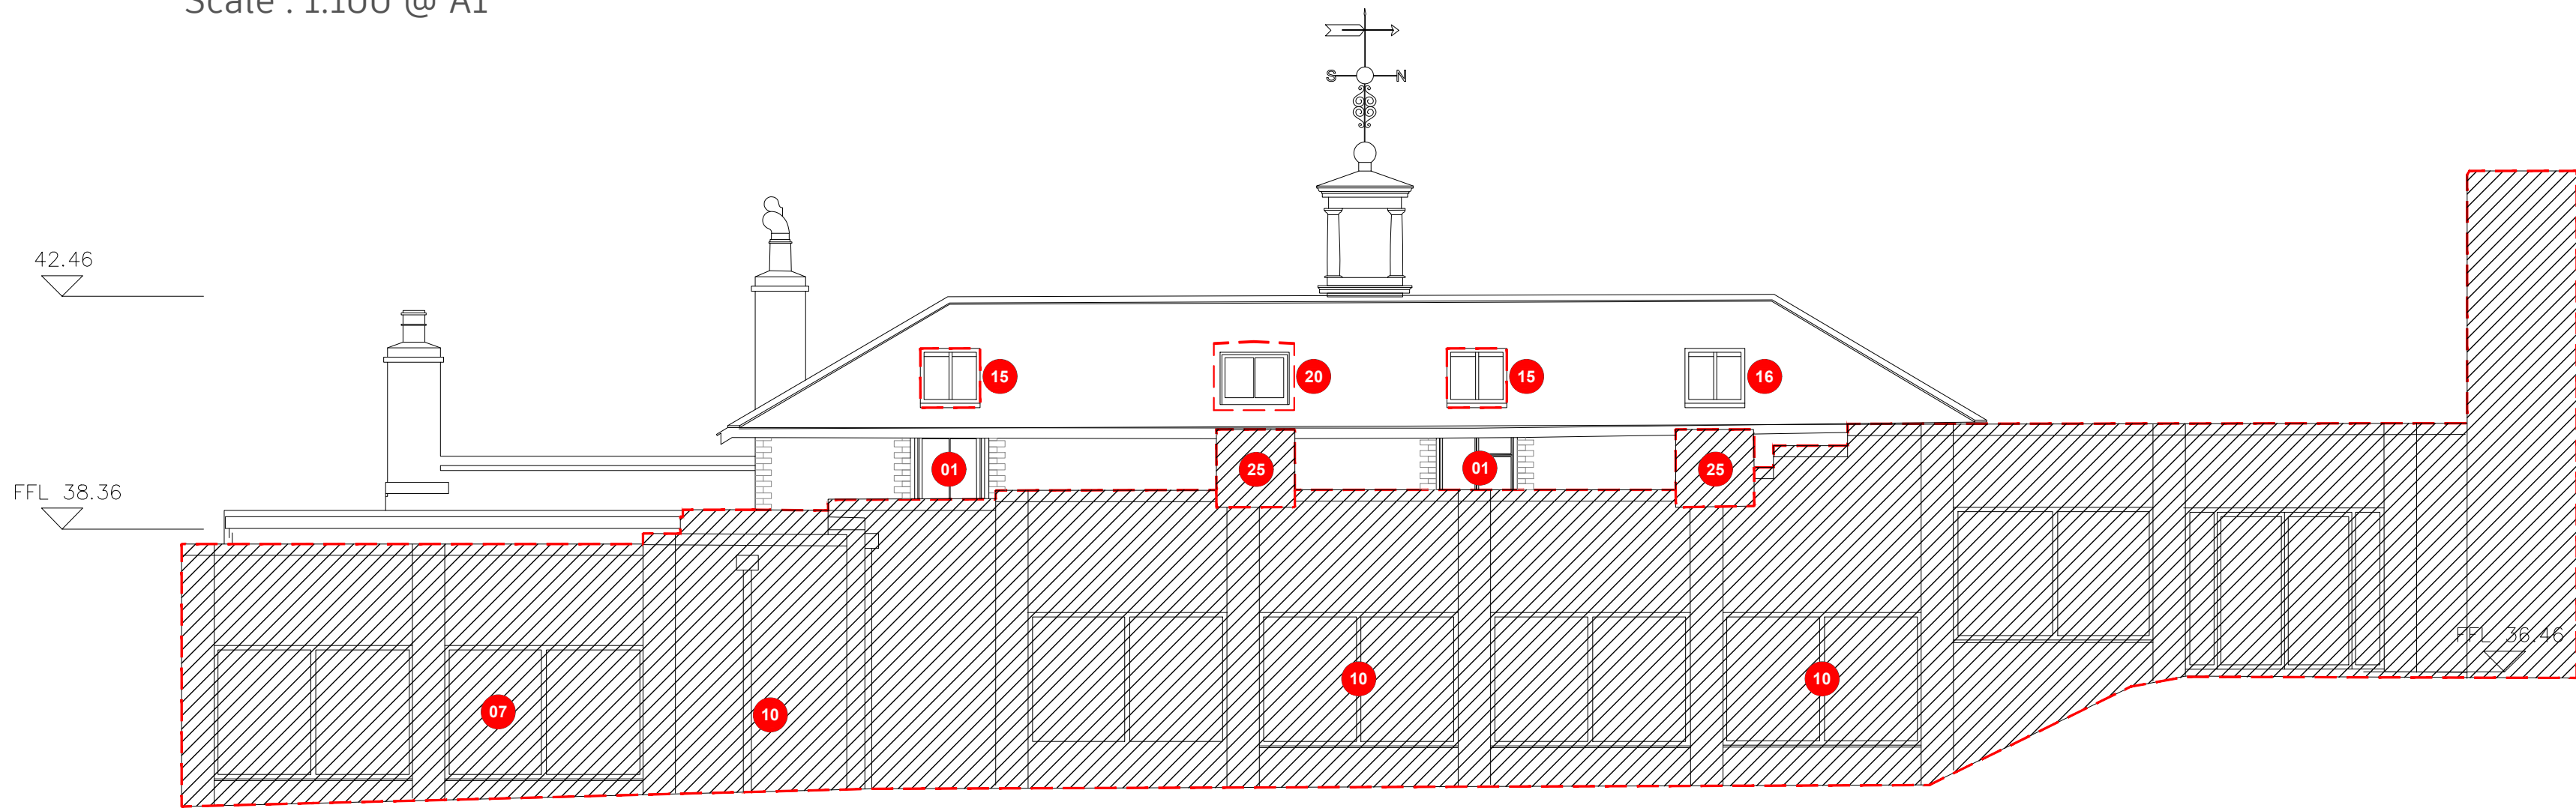

East Elevation
(Proposed alterations to existing)
Scale : 1:100 @ A1

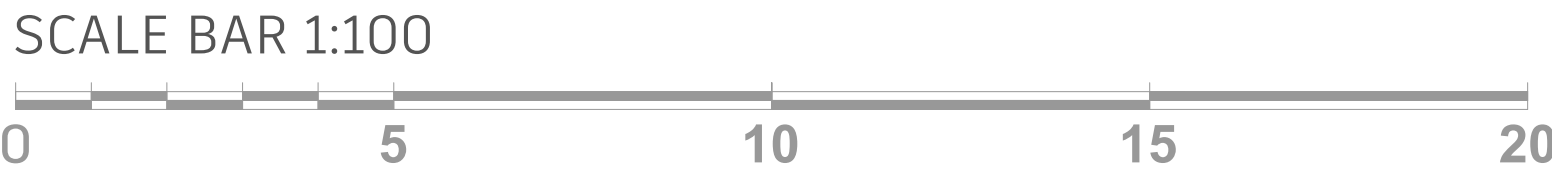

© FSL GROUP Property & Copyright. Use of drawings is not permitted nor can they be copied, duplicated or distributed without the consent of FSL Group. All designs are the sole property of FSL Group, and may not be used, transferred, or disclosed to a third party without the express permission of FSL Group. Electronic copies of this drawing are supplied for convenience only. No dimensions or other information should be used from the electronic copy.



Key Plan
Scale : NTS @ A1

LEGEND

Stables
South / East Elevation

00 Refer key for further detail of proposed alterations to existing building fabric

- 01 Existing openings to receive new windows / doors.
- 02 Single storey extension to be demolished.
- 03 Existing floor to be removed and replaced with new insulated and damp proofed floor
- 04 New doors into existing openings - levels to be reduced
- 05 Amend existing window openings for new doorway.
- 06 Existing doors & windows to be removed & replaced with high quality window / door in keeping with surrounding aesthetics.
- 07 Existing structure to be demolished.
- 08 Opening door to be moved to centre unit and open inwards.
- 09 Door swing to be amended in order to open inwards.
- 10 Form new openings for proposed single storey rear extension.
- 11 Existing fire escape staircase to be removed.
- 12 Tarmac to be removed and replaced with new surfacing as landscape detail.
- 13 Driveway to be removed & reconfigured as part of proposed residential development to north.
- 14 Proposed rear garden areas to residential conversions.

- 15 New opening for conservation rooflight.
- 16 Existing rooflight retained.
- 17 Existing window to be blocked up with flintwork to match existing, recessed from face of existing wall.
- 18 Existing stairs to be removed and openings in floors to be in-filled.
- 19 Form new opening in floor for proposed staircase.
- 20 Existing dormer removed and replaced with conservation rooflight.
- 21 Existing wall to be removed and rebuilt to form new party wall.
- 22 Existing window required as escape window compliant with Building Regulations AD B.
- 23 Remove existing doorway and replace with window to match that of southern end of elevation. Reinstall brick arch above.
- 24 Form new opening for proposed external door.
- 25 Proposed new window to form escape window compliant with ADB.
- 26 Existing retaining wall to be demolished.

Minor amendments		HC	CMH	22.08.23
B	Conservation Alterations Up Issue			
Rev:	Description:	CDM	CMH	21.08.23
Drawing Status:		Drawn:	Checked:	Date:
PLANNING				
CONCEPT - TENDER - APPROVAL - CONTRACT - CONSTRUCTION - AS BUILT				
		M4, The Millennium Centre, Crosby Way, Farnham Surrey GU9 7XX +44 (0)1252 745200 info@fsl-group.co.uk www.fsl-group.co.uk		
FSL Group				
Client:		Site Address:		
Bargate Homes		Southleigh Park House Havant PO9 2PE		
Floor & Drawing:				
Former Stables (Existing) South/East Conservation Alterations Elevations				
Drawing Number:				
28473 – STABLES – EXT-EX-SE C				
Project Number	Building	Drawing Code	Revision	
Produced By:				HJC
Creation Date:				19/11/20
Scale:				SCALE 1:100@A1
Drawing Notes: Figured dimensions only are to be taken from this drawing - DO NOT SCALE. Contractors must verify all dimensions prior to construction and any discrepancies are to be reported.Design © FSL Group				