




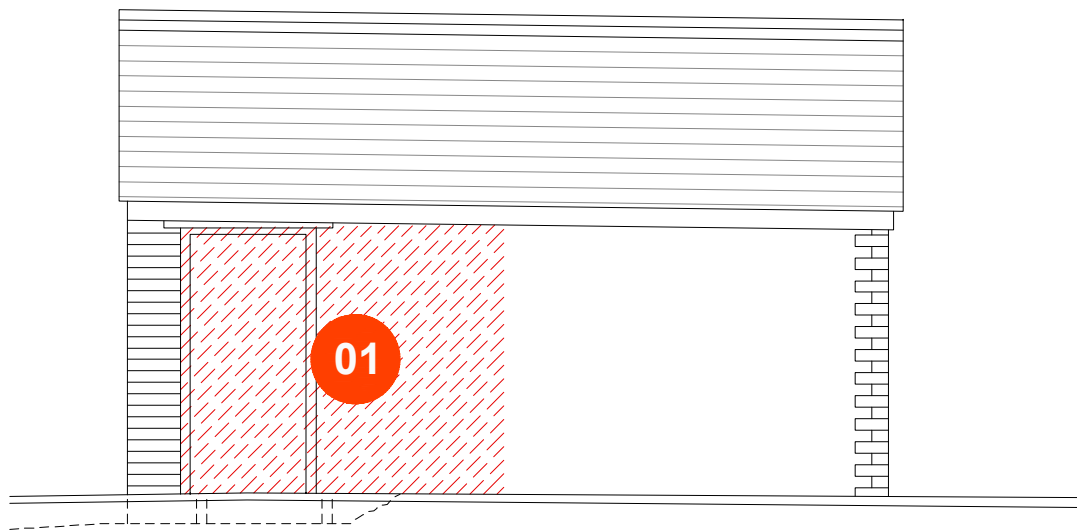


Wood store - North Elevation
[Proposed alterations to existing]
Scale 1:50@A1

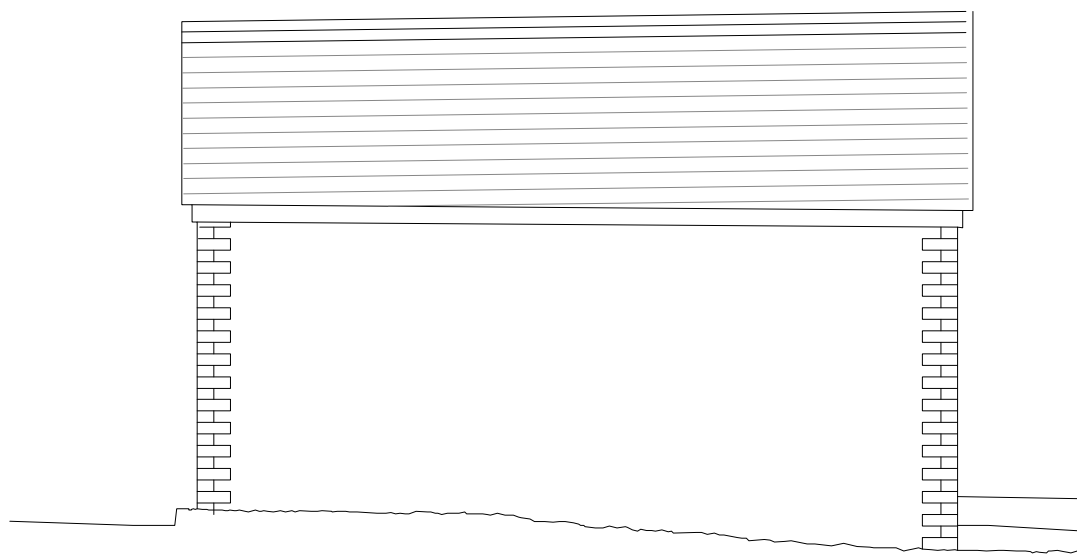


Wood store - South Elevation
[Proposed alterations to existing]
Scale 1:50@A1

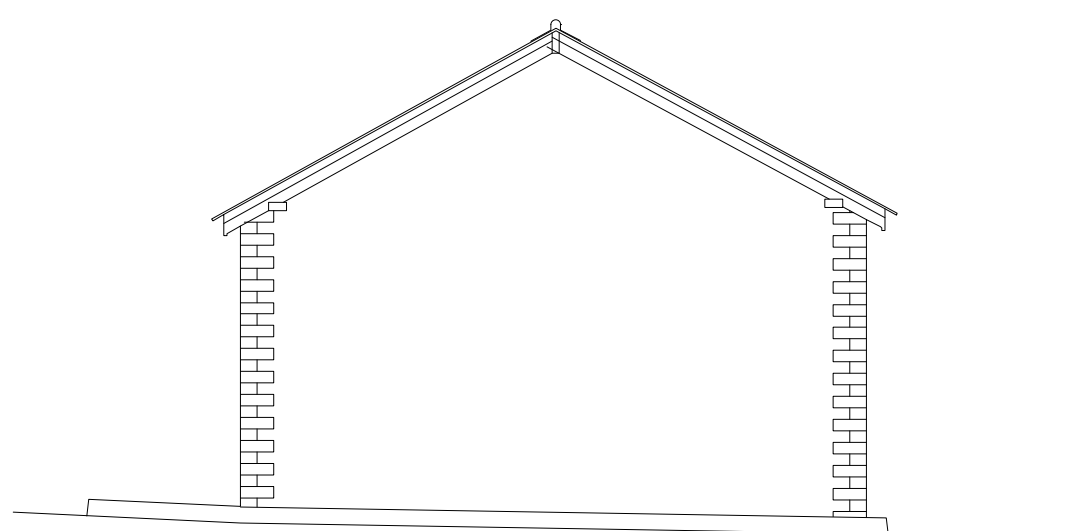

Wood store - West Elevation
[Proposed alterations to existing]
Scale 1:50@A1

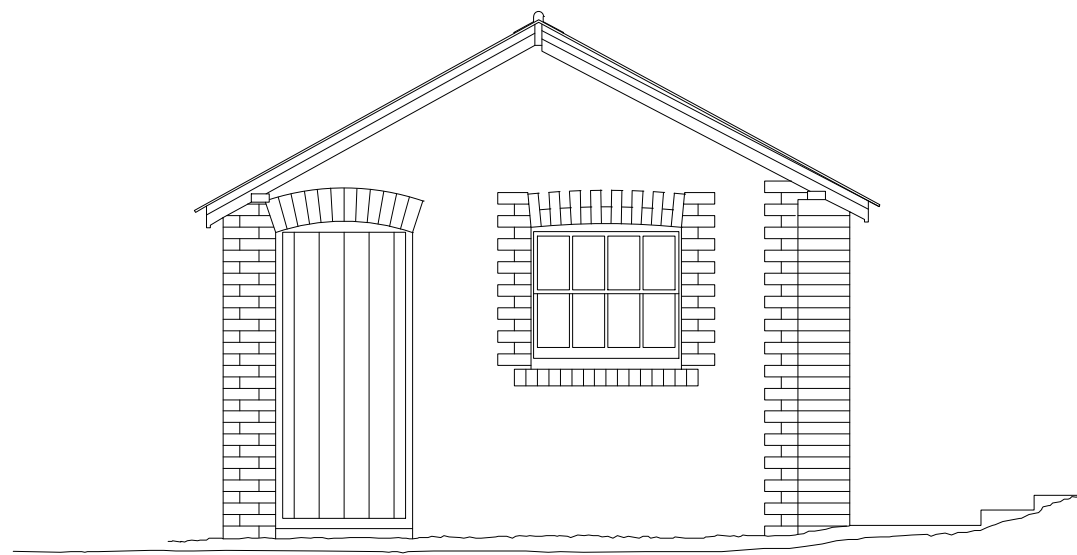

Wood store - East Elevation
[Proposed alterations to existing]
Scale 1:50@A1

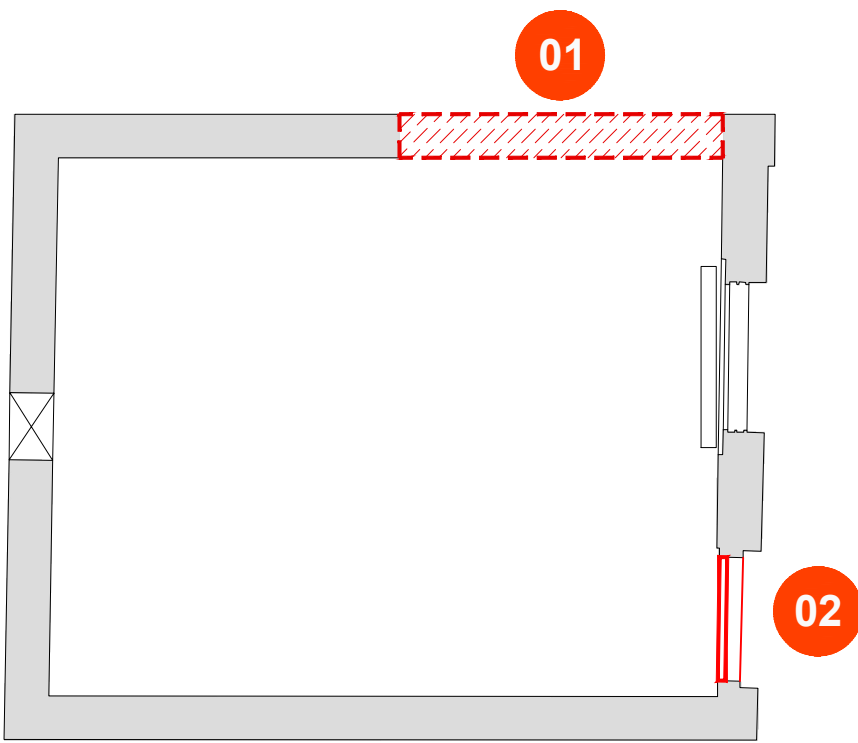


Wood store - Proposed Plan
[Proposed alterations to existing]
Scale 1:50@A1

Existing / Demo / Infill Legend	
	Demo Structural Wall
	Existing Structural Wall

LEGEND	
	Log Store Refer key for further detail of proposed alterations to existing building fabric
01 Original doorway to be reinstated & widened for tongue & groove double access door (to match style of single door).	
02 Existing door & door / frame to be retained & secured in the shut position.	



Key Plan
Scale : NTS @ A1

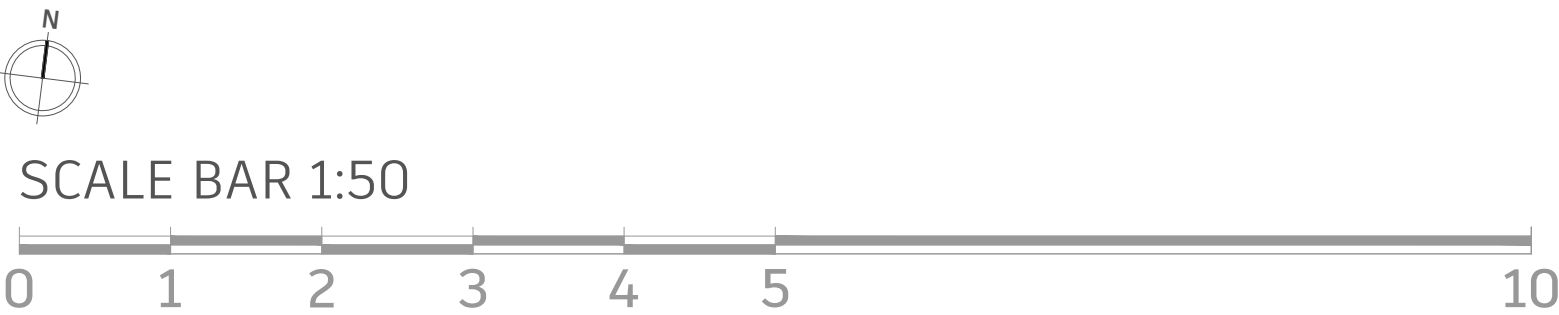

© FSL GROUP Property & Copyright. Use of drawings is not permitted nor can they be copied, duplicated or distributed without the consent of FSL Group. All designs are the sole property of FSL Group, and may not be used, transferred, or disclosed to a third party without the express permission of FSL Group. Electronic copies of this drawing are supplied for convenience only. No dimensions or other information should be used from the electronic copy.

Minor amendments		HC	CMH	22.08.23
B	Conservation Alterations			
Rev:	Up Issue	CDM	CMH	21.08.23
Description:		Drawn:	Checked:	Date:
Drawing Status:				
CONCEPT - TENDER - APPROVAL - CONTRACT - CONSTRUCTION - AS BUILT				
PLANNING				
		M4, The Millennium Centre, Crosby Way, Farnham Surrey GU9 7XX +44 (0)1252 745200 info@fsl-group.co.uk www.fsl-group.co.uk		
Client:		Site Address:		
Bargate Homes		Southleigh Park House Havant PO9 2PE		
Floor & Drawing:				
Wood Store (Waste storage) Conservation Alterations GA				
Drawing Number:				
28473 — WOOD — C-GA — C				
Project Number		Building	Drawing Code	Revision
Produced By:		CMH		
Creation Date:		10/08/23		
Scale:		SCALE 1:50@A1		
Drawing Notes: Figured dimensions only are to be taken from this drawing - DO NOT SCALE. Contractors must verify all dimensions prior to construction and any discrepancies are to be reported.Design © FSL Group				