



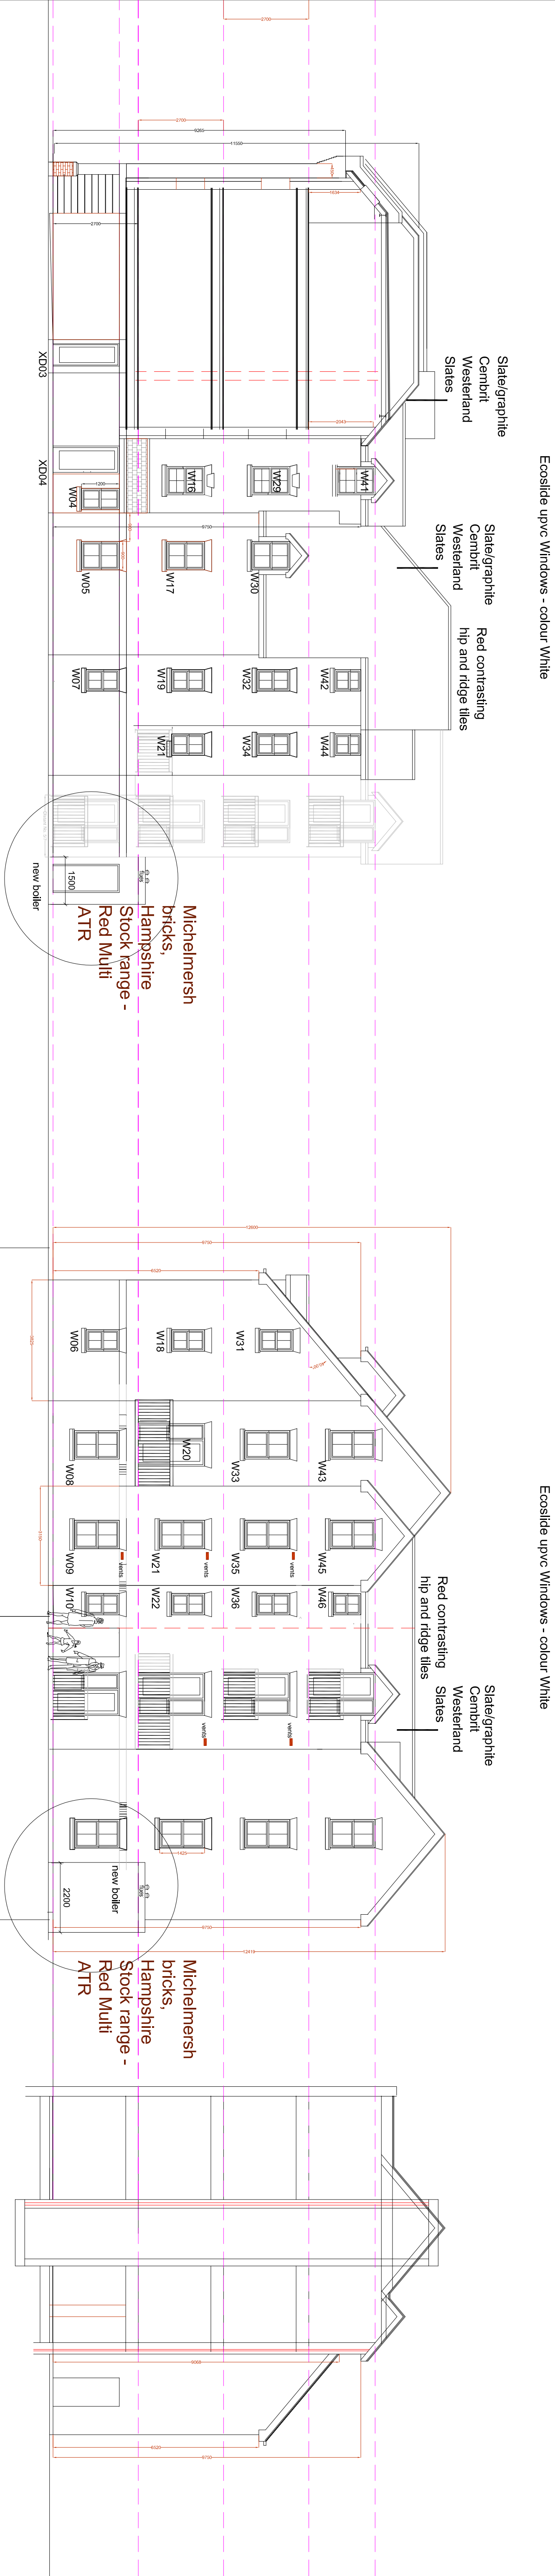


East Elevation

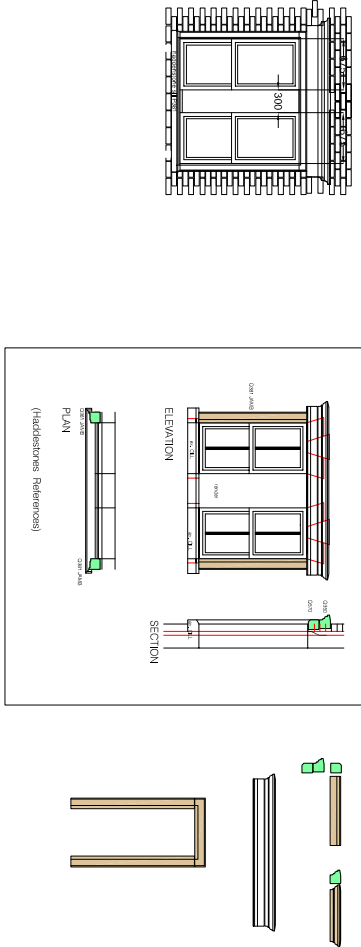

No.5&7 No. 9

South Elevations

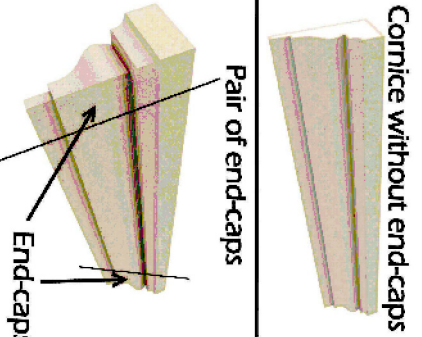

Planning Amendment
(as built)

No.5&7 No. 9

South Elevations

Planning Approval