
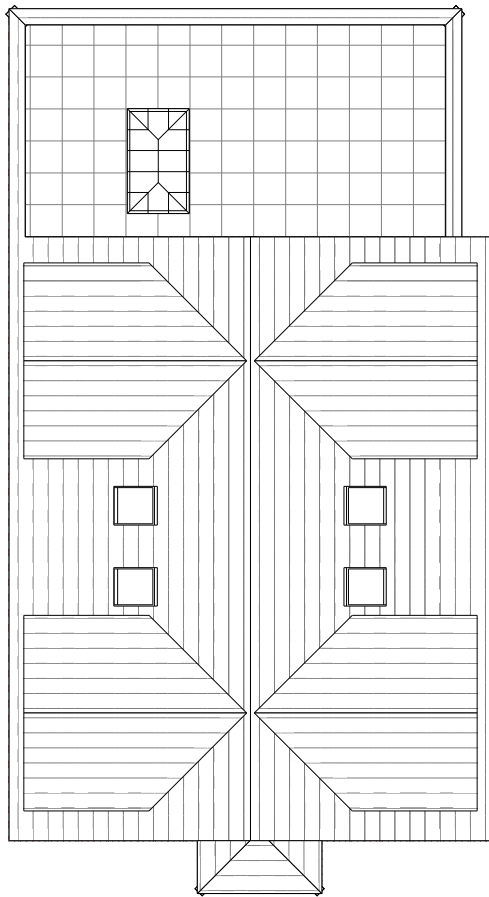


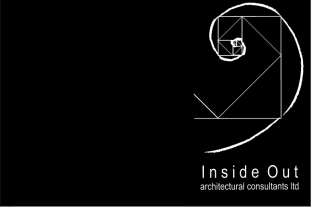

Existing Roof Plan
Scale 1:100

job no. 226		drawing no. A.06	
			
client Mr. & Mrs. Southwood			
job 18 Springvale Cowplain PO89DA			
drawing title Existing Roof Plan As Built			
scale See Drawing	drawn	date	
Scale 1:100 			
© Inside Out Architectural Consultants Ltd 2011			
job no. 226		drawing no. A.06	