




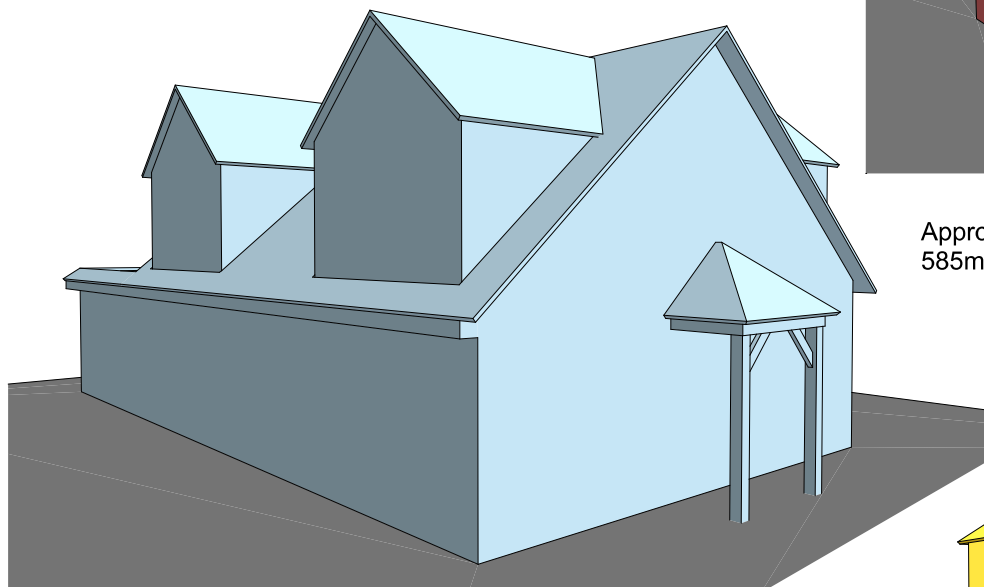


As Built
589 m³

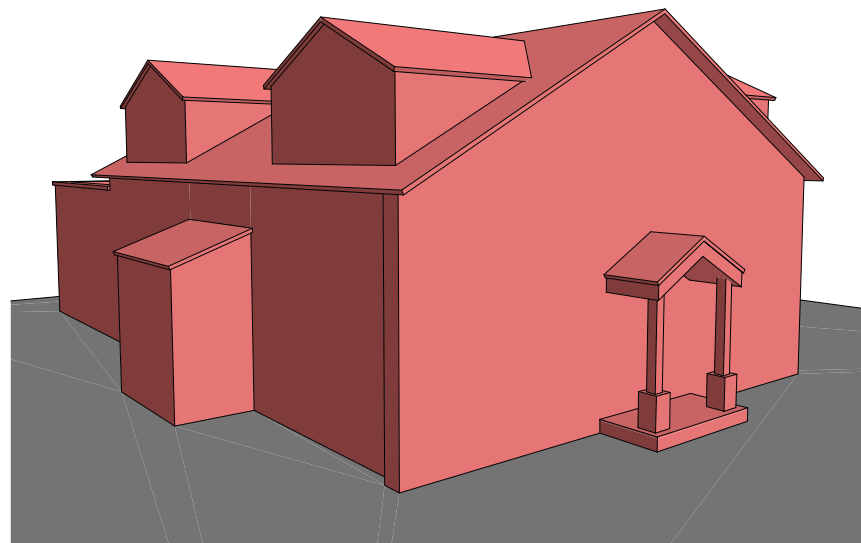

Approved
585m³

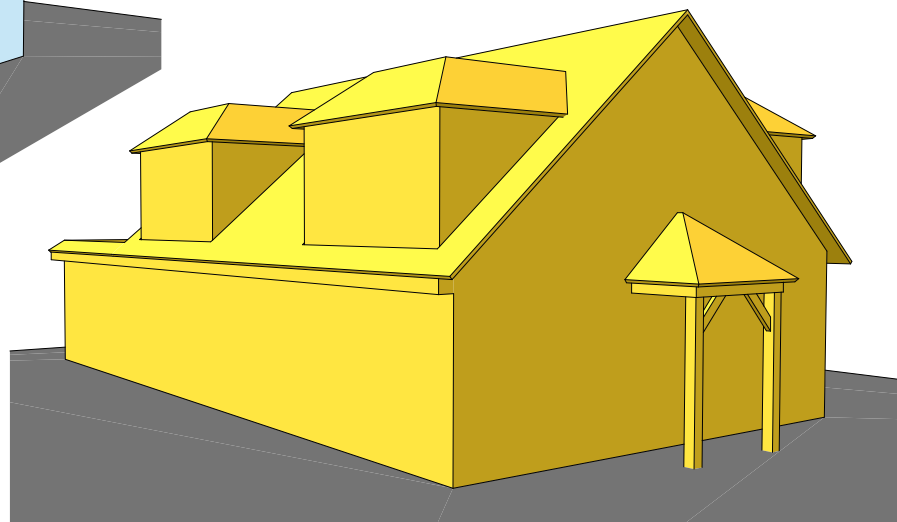

Proposed
530 m³

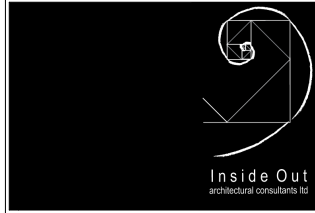job no. 226		drawing no. A.14	
			
client Mr. & Mrs. Southwood			
job 18 Springvale Cowplain PO89DA			
drawing title Volumetric Analysis M3			
scale See Drawing	drawn	date	
Legend: Approved: 585 m³ As Built: 589 m³ Proposed: 530 m³			
© Inside Out Architectural Consultants Ltd 2011			
job no. 226		drawing no. A.14	