




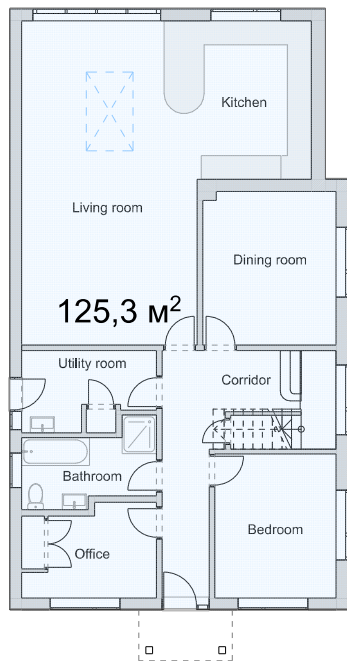


As Built Ground Floor Plan

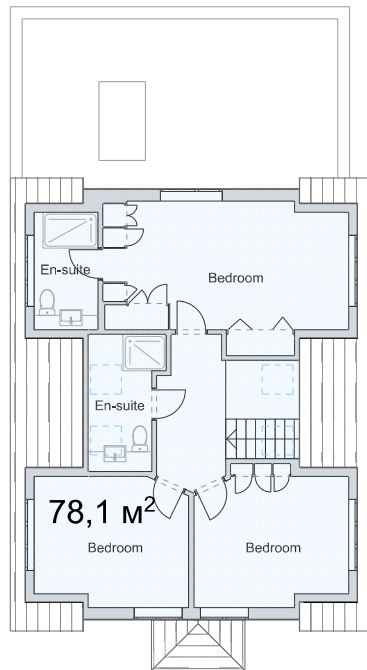

As Built First Floor Plan

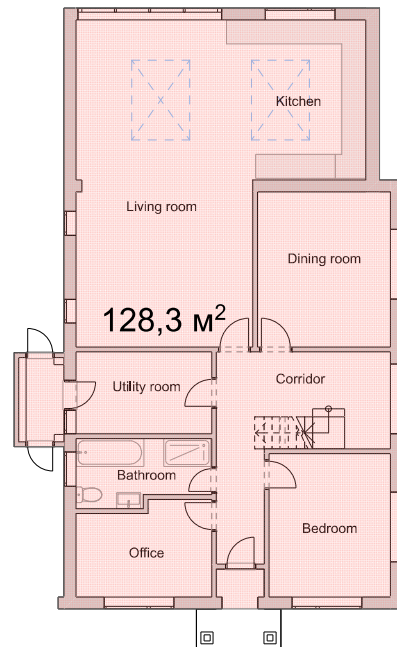

Approved Ground Floor Plan

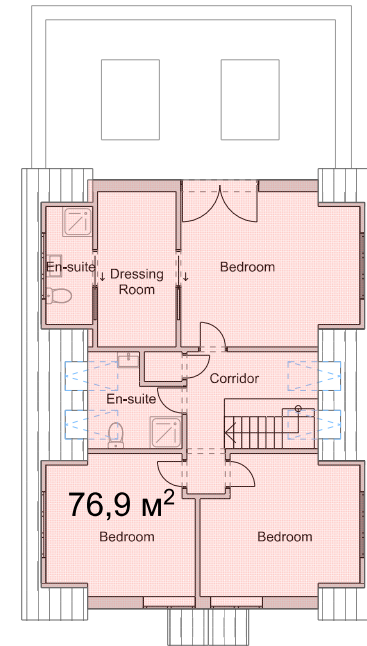

Approved First Floor Plan

job no.	226	drawing no.	A.13
 Inside Out architectural consultants ltd			
client	Mr. & Mrs. Southwood		
job	18 Springvale Cowplain PO89DA		
drawing title	Volumetric Analysis M2		
scale	See Drawing	drawn	date
Legend: Approved - 205,2 m² As Built - 203,4 m²			
© Inside Out Architectural Consultants Ltd 2011			
job no.	226	drawing no.	A.13