




boundary

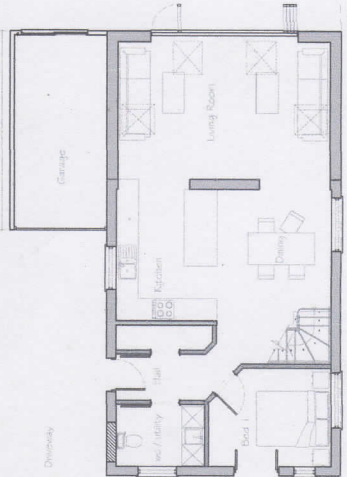

As Built Ground Floor Plan
Scale 1:100

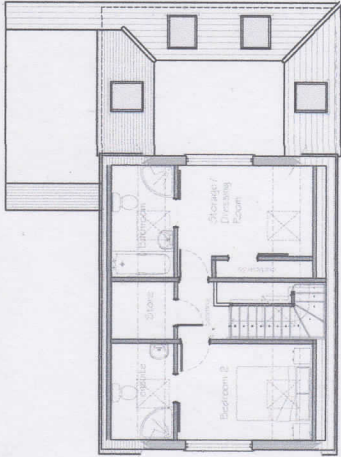

As Built First Floor Plan
Scale 1:100

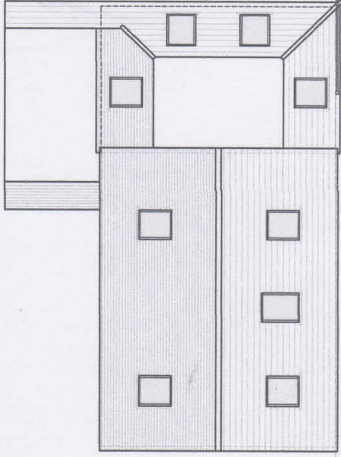


As Built Roof Plan
Scale 1:100


boundary




As Built Side Elevation (east)
Scale 1:100

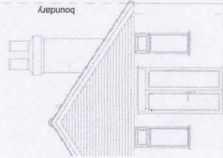


As Built Front Elevation (north)
Scale 1:100

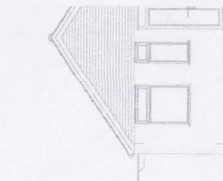

As Built Side Elevation (west)
Scale 1:100

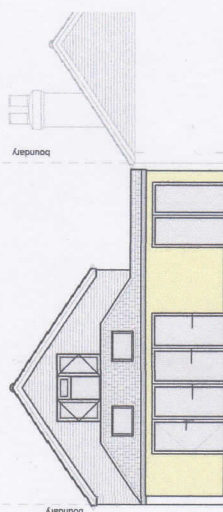

As Built Rear Elevation (south)
Scale 1:100

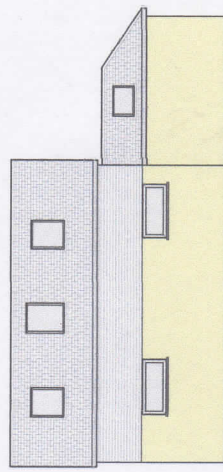

As Built Side Elevation (east)
Scale 1:100

Rev	Description	Date	PM
C	As surveyed April 2023	20.04.23	MD
B	As surveyed April 2023	17.04.23	MD

AS_BUILT

CLIENT
Mr Tattersall

PROJECT
Alterations under
Permitted Development to
37 North Crescent
Hayling Island
Hants
PO11 9LR

TITLE
Existing and Proposed
Floor Plans and Elevations

Scale : 1:100@A2
Date : 0 APRIL 22
Drawing No: MD



Drawn by: MD
Date: 0 APRIL 22
Drawing No: MD

18.235.AB100

ST
TU
VW
XY
Z