




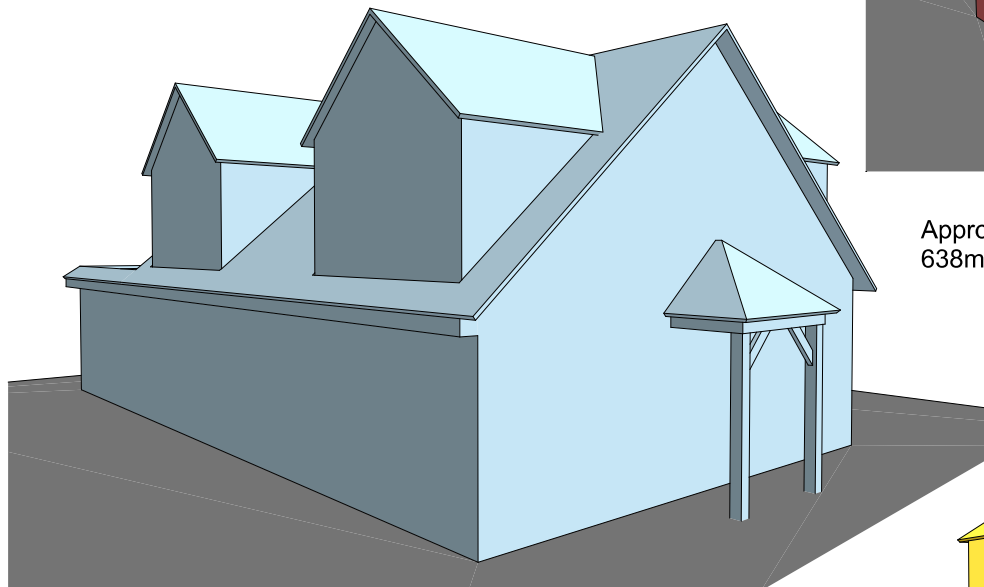

As Built  
698 m<sup>3</sup>

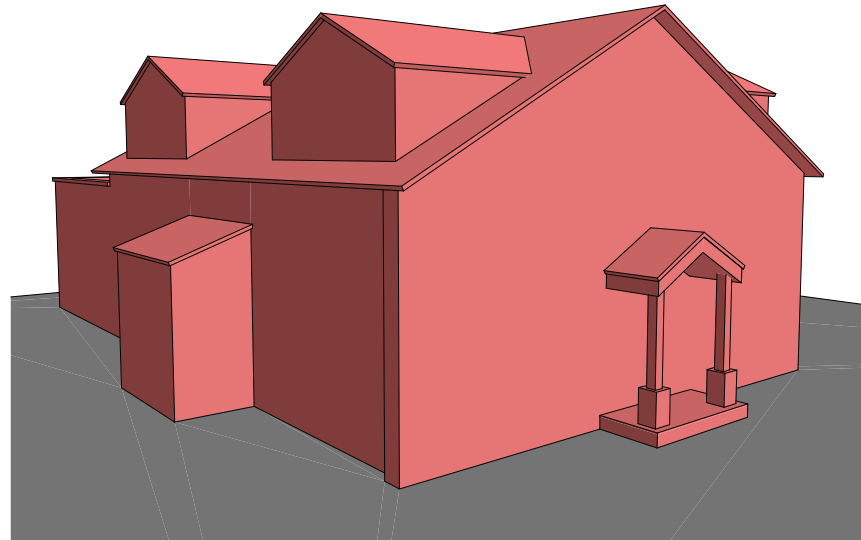

Approved  
638m<sup>3</sup>

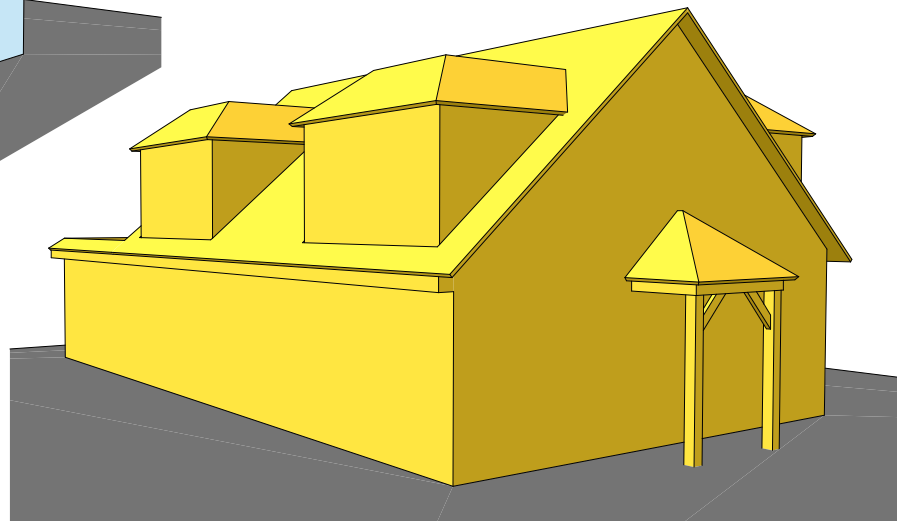

Proposed  
639 m<sup>3</sup>

|                                                                                                                                                                                                                                                                                                                                                                                                                                                                                                                                                                                                                                                                |       |                  |  |
|----------------------------------------------------------------------------------------------------------------------------------------------------------------------------------------------------------------------------------------------------------------------------------------------------------------------------------------------------------------------------------------------------------------------------------------------------------------------------------------------------------------------------------------------------------------------------------------------------------------------------------------------------------------|-------|------------------|--|
| job no. 226                                                                                                                                                                                                                                                                                                                                                                                                                                                                                                                                                                                                                                                    |       | drawing no. A.14 |  |
|                                                                                                                                                                                                                                                                                                                                                                                                                                                                                                                                                                                                                                                                |       |                  |  |
| client Mr. & Mrs. Southwood                                                                                                                                                                                                                                                                                                                                                                                                                                                                                                                                                                                                                                    |       |                  |  |
| job 18 Springvale<br>Cowplain PO89DA                                                                                                                                                                                                                                                                                                                                                                                                                                                                                                                                                                                                                           |       |                  |  |
| drawing title<br><b>Volumetric Analysis<br/>M3</b>                                                                                                                                                                                                                                                                                                                                                                                                                                                                                                                                                                                                             |       |                  |  |
| scale<br>See Drawing                                                                                                                                                                                                                                                                                                                                                                                                                                                                                                                                                                                                                                           | drawn | date             |  |
| <b>Legend:</b><br><div style="display: flex; align-items: center; margin-bottom: 10px;"> <div style="width: 20px; height: 20px; background-color: red; margin-right: 10px;"></div> <div>Approved:<br/>638 m<sup>3</sup></div> </div> <div style="display: flex; align-items: center; margin-bottom: 10px;"> <div style="width: 20px; height: 20px; background-color: lightblue; margin-right: 10px;"></div> <div>As Built:<br/>698 m<sup>3</sup></div> </div> <div style="display: flex; align-items: center;"> <div style="width: 20px; height: 20px; background-color: yellow; margin-right: 10px;"></div> <div>Proposed:<br/>639 m<sup>3</sup></div> </div> |       |                  |  |
| © Inside Out Architectural Consultants Ltd 2011                                                                                                                                                                                                                                                                                                                                                                                                                                                                                                                                                                                                                |       |                  |  |
| job no. 226                                                                                                                                                                                                                                                                                                                                                                                                                                                                                                                                                                                                                                                    |       | drawing no. A.14 |  |