




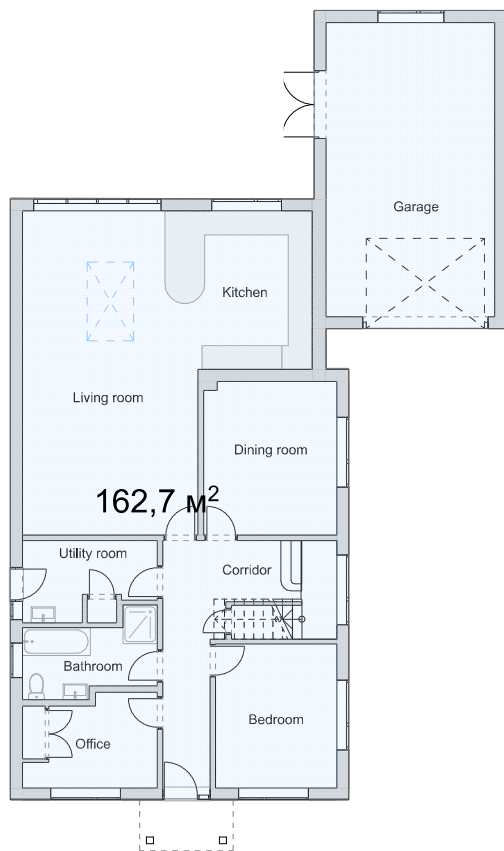


As Built Ground Floor Plan

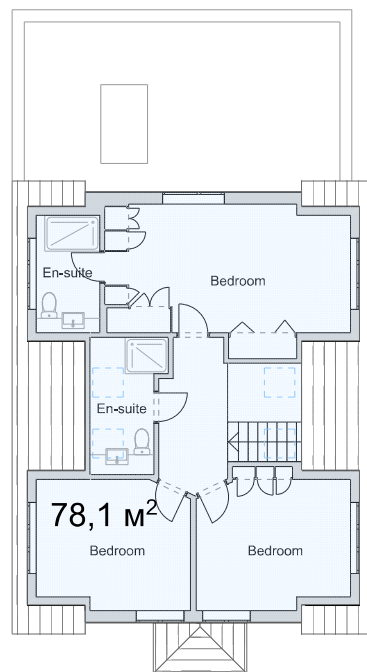

As Built First Floor Plan

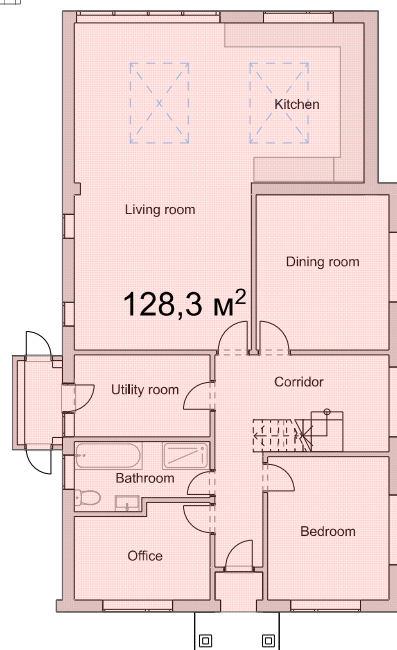

Approved Ground Floor Plan

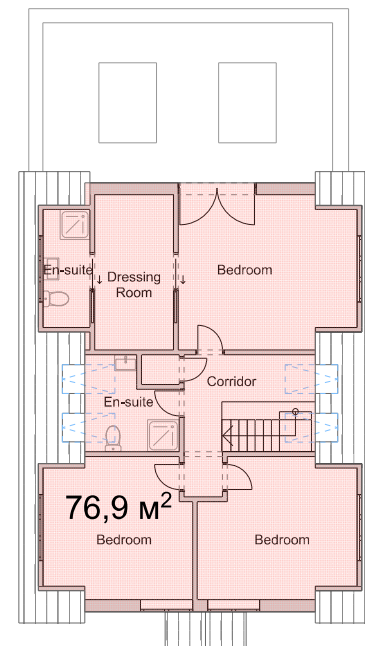

Approved First Floor Plan

job no.	226	drawing no.	A.13
			
client Mr. & Mrs. Southwood			
job 18 Springvale Cowplain PO89DA			
drawing title Volumetric Analysis M2			
scale See Drawing	drawn	date	
Legend: Approved - 228,6 m² As Built - 240,8 m²			
© Inside Out Architectural Consultants Ltd 2011			
job no.	226	drawing no.	A.13