




- Notes:
- 1) Dimensions represent the as built measurements of the porch.
 - 2) Vertical dimensions are taken from the finished floor level (FFL) of the existing house as the ground level varies falling from the house to Barncroft Way

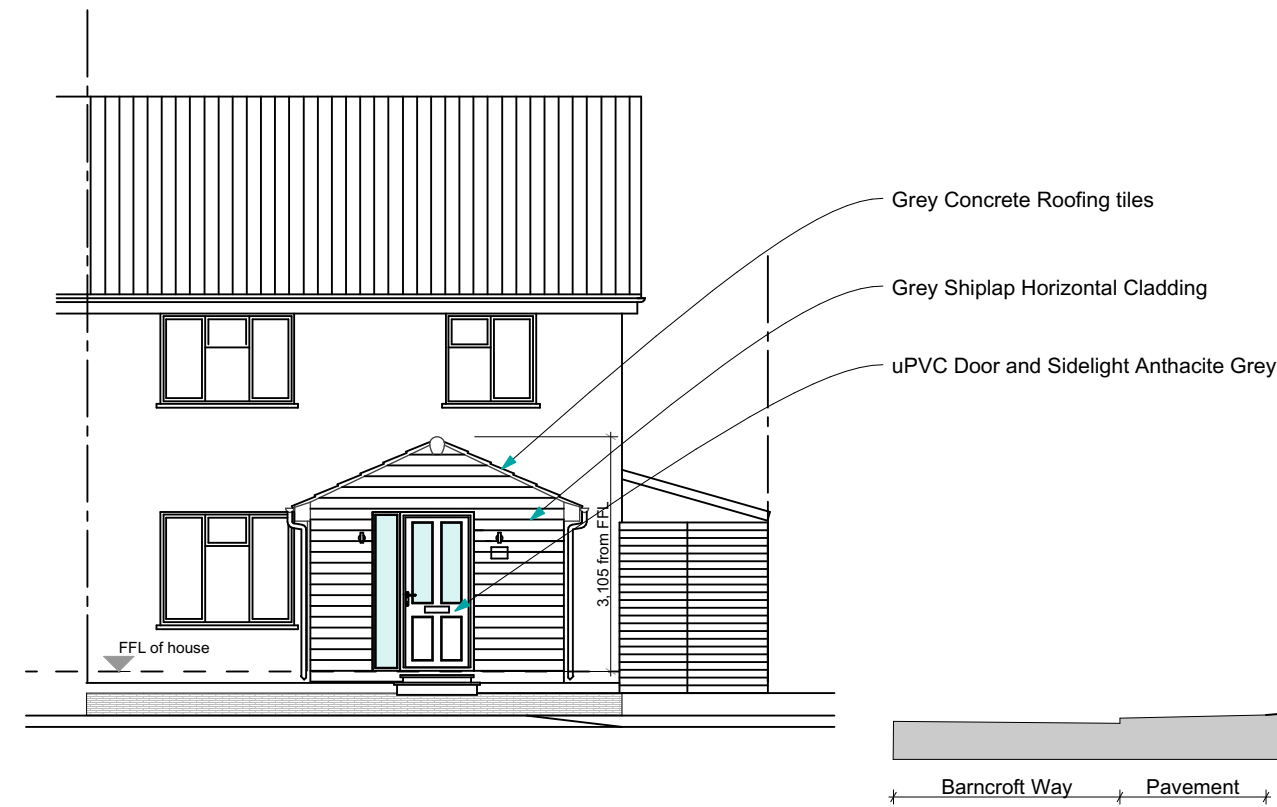


North East Elevation

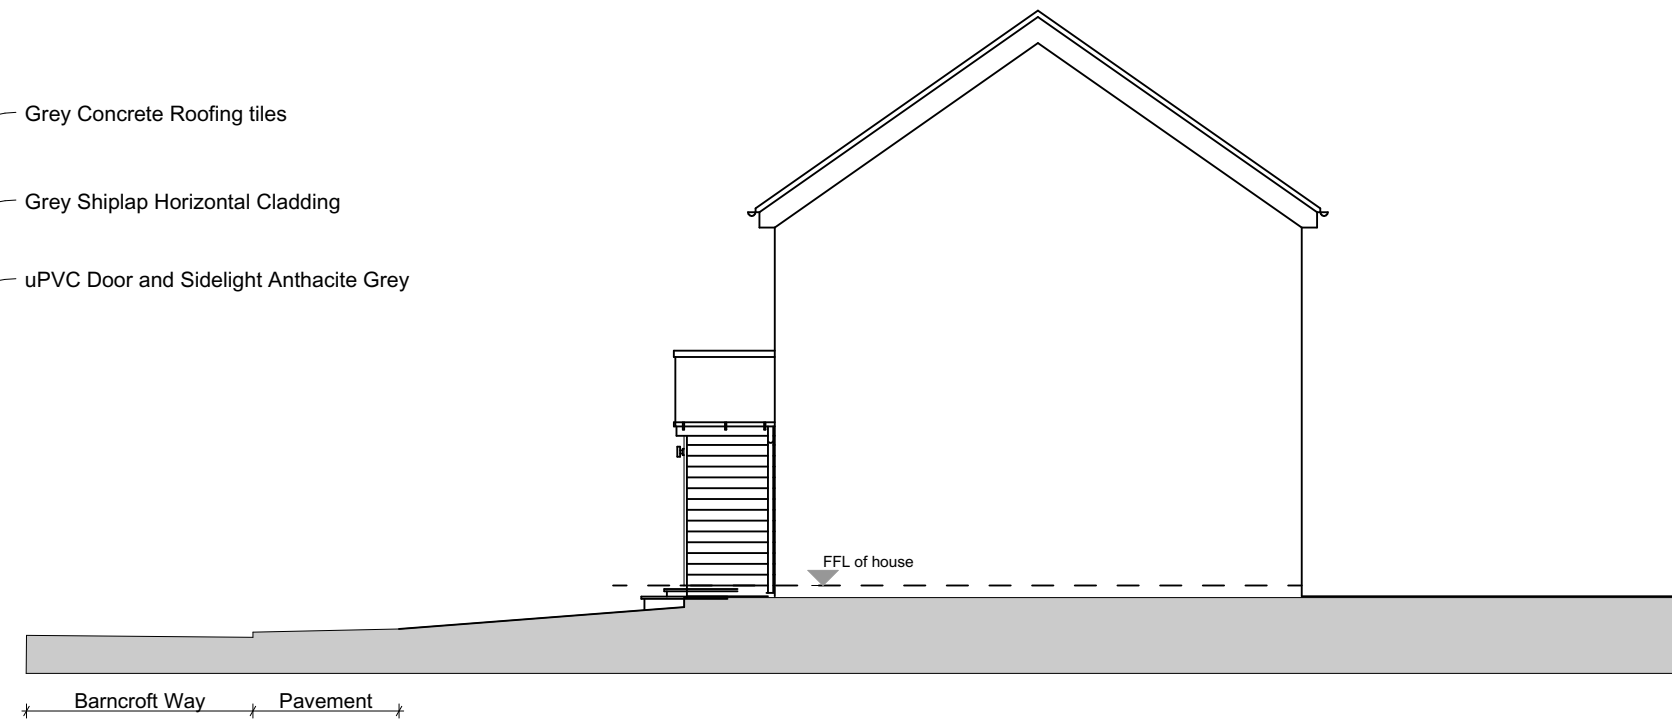


North West Elevation

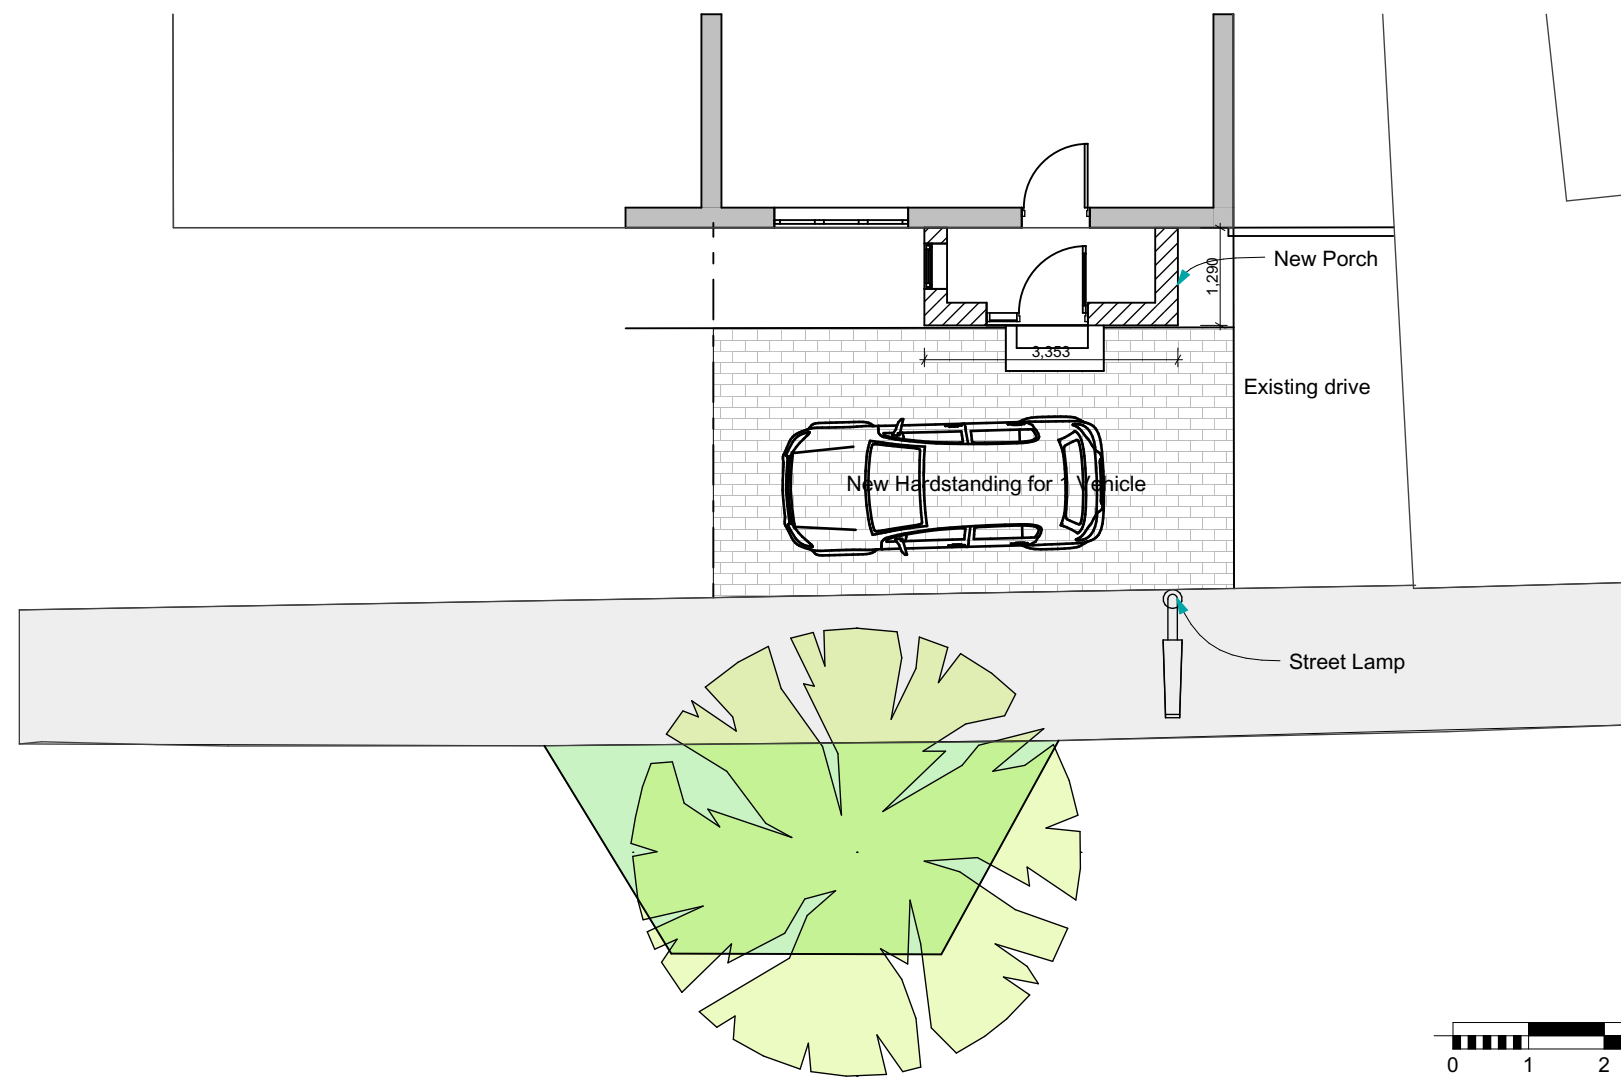


BARNCROFT WAY

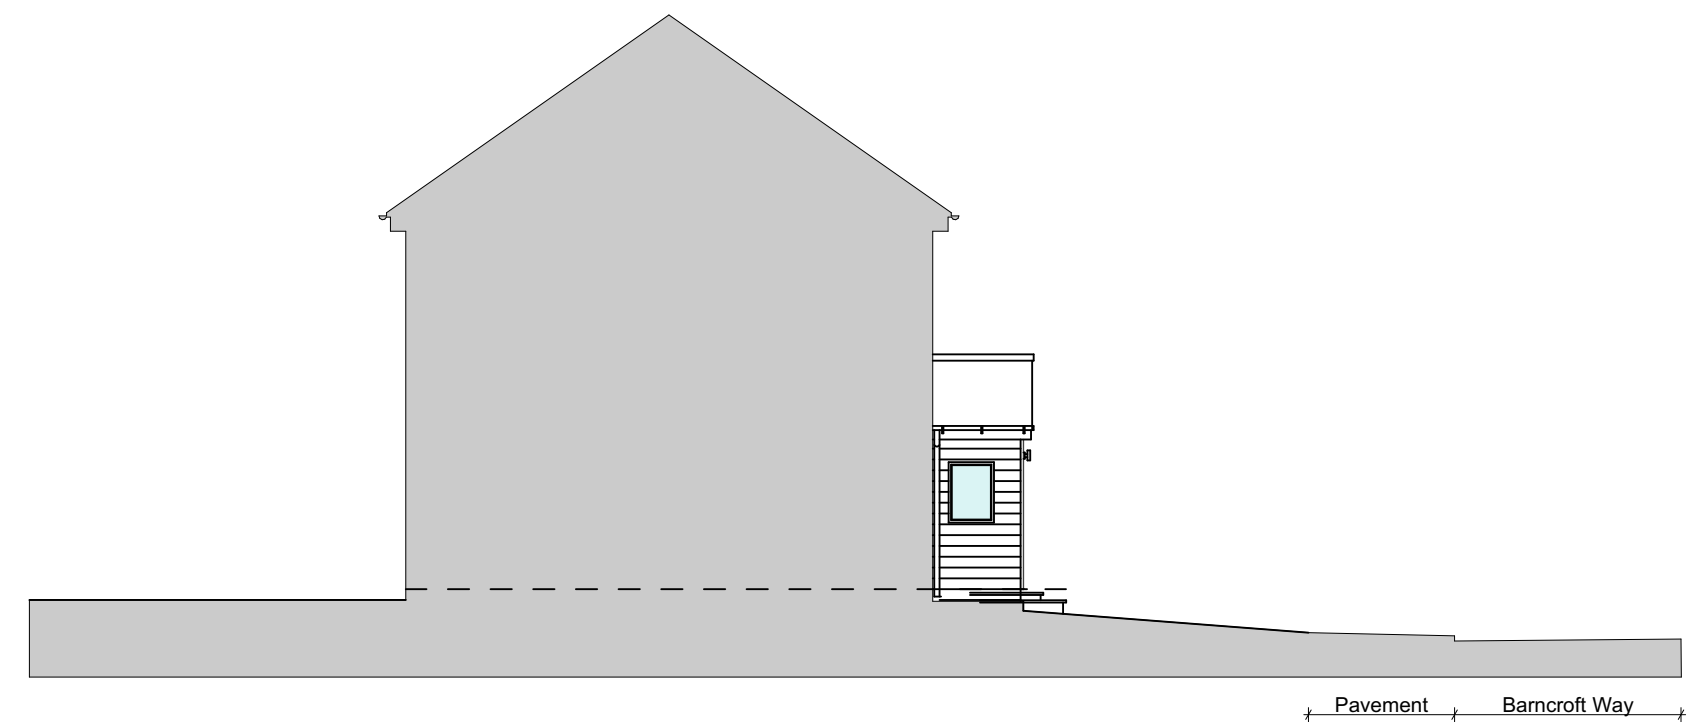

Sectional South East Elevation

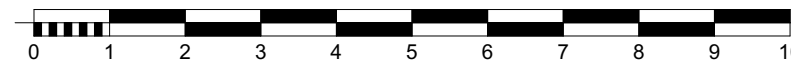

Plan

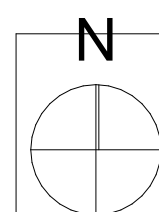

0 100mm @A1

Note: All dimensions to be checked on site by the contractor before fabrication and erection. Figured dimensions to be taken in preference to scaled dimensions. This drawing is the copyright of the architects and must not be reproduced or used without their express consent, except for the purposes of a planning application. Electronic issue of this drawing to be confirmed by paper hard copy only.

revisions & notes: RevID | ChID | Change Name | Date

Revision A: Dimensions and explanatory note added regading measurments: 01-06-2023

Drawing:

Project:

Project name: **New front Porch and drive**
Site address: **170 Barncroft Way**

Drawing name: **Proposed Plan and Elevations**
Date: **May 2023**
Scale: **1:100**

Project status: **Planning**

pwparchitects
61 South Street, Havant, Hampshire PO9 1BZ
t: 023 9248 2494 f: 023 9248 1152
e: design@pwp-architects.com w: www.pwp-architects.com

Project No. **5948** drawing No. **1127revA**