

Dear Mr. Toole,

Thank you for your email and the clarifications. Please note the following issues

1- On the first (ground) floor and new front window issue: To be clearer from your clarifications below. This additional window [highlighted as (#3)] on the planning diagram attached. Please confirm if this window is the one mentioned in your email. If so, then I suggest that the obscure glazing of this window should be clearly stated in the planning permission. Also, the two existing windows highlighted as [(#6 & #7)] in the attached planning diagram, should also remain obscured as they area and as a result of this extension work process. This also need to be noted in the planning permission. The reason for this , is that, although you have mentioned that these windows ' not applying to change the existing windows therefore we can only assess what they are applying for' . However , I suggest that the above note to be noted just in case these windows being altered by this extension process.



I also highlighted the case for the Window (#5) in the second floor. This window is clearly overlooking on our propoerty and is currently not obscure. Although this is apparently not part of this planning application, and it is presumed that this will not be altered as part of this extension , however, my earlier note/ inquiry on this window, is for your offices as part of this planning application to investigate and confirm if the current non- glazed glass of this overlooking window does,, comply with the current planing regulations on neighbor overlooking windows . To the best of my knowledge, the house was built in the early 1980's, and these should have been applied then . This is clearly not the case at this stage. Please confirm and clarify this concern.

2- On the health risk issue/ traffic obstruction issues: The health risk is an important issue, especially at this lock down period, where the infection rates of COVID-19 are high in the area. Any possible building work prior to any easing of these restrictions can be unlawful, and can constitute health risk to the neighbors and the community . I suggest that the Environmental Health team to be notified on this application, and to ensure that such work does not commence prior to any easing of the restrictions by the government. The transport team need also to be notified on this application, and further clarifications need to be submitted on this application on how the extensive work to be conducted as part of this planning applications, will not obstruct the traffic flow of the neighbors and the traffic on this busy road, and the compliance with the existing parking regulation in force on Glebe Park Avenue.

Please note that unless these issues are further clarified, our objection on this matter stands.

1. This drawing is the copyright of Hampshire Design
 2. The Contractor shall not make any alterations to this drawing for
 3. All dimensions and levels are to be checked on site by the
 4. The responsibility for any errors or omissions in this drawing
 5. The Contractor shall not make any alterations to this drawing for
 6. The Contractor shall not make any alterations to this drawing for
 7. The Contractor shall not make any alterations to this drawing for

Blue dashed line represents
the profile for the existing
house.

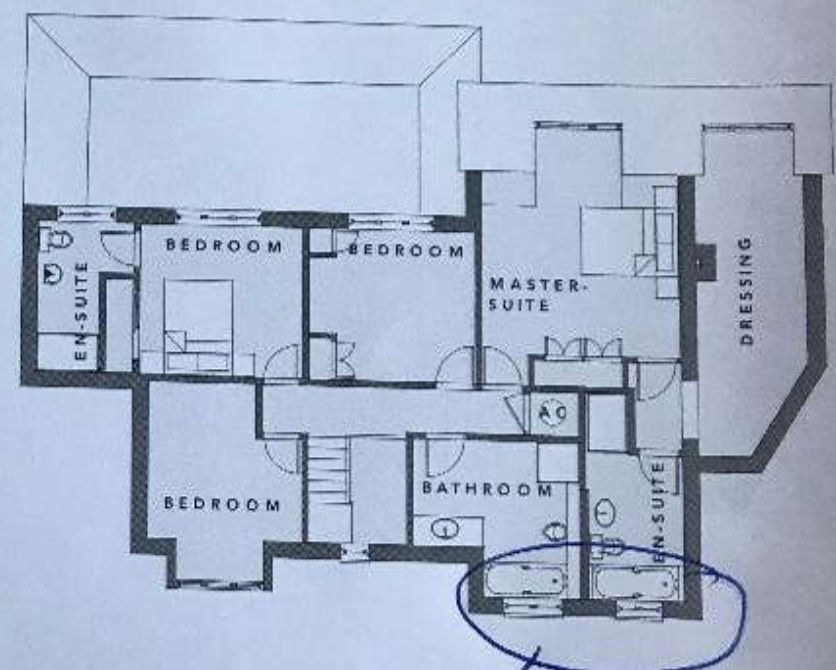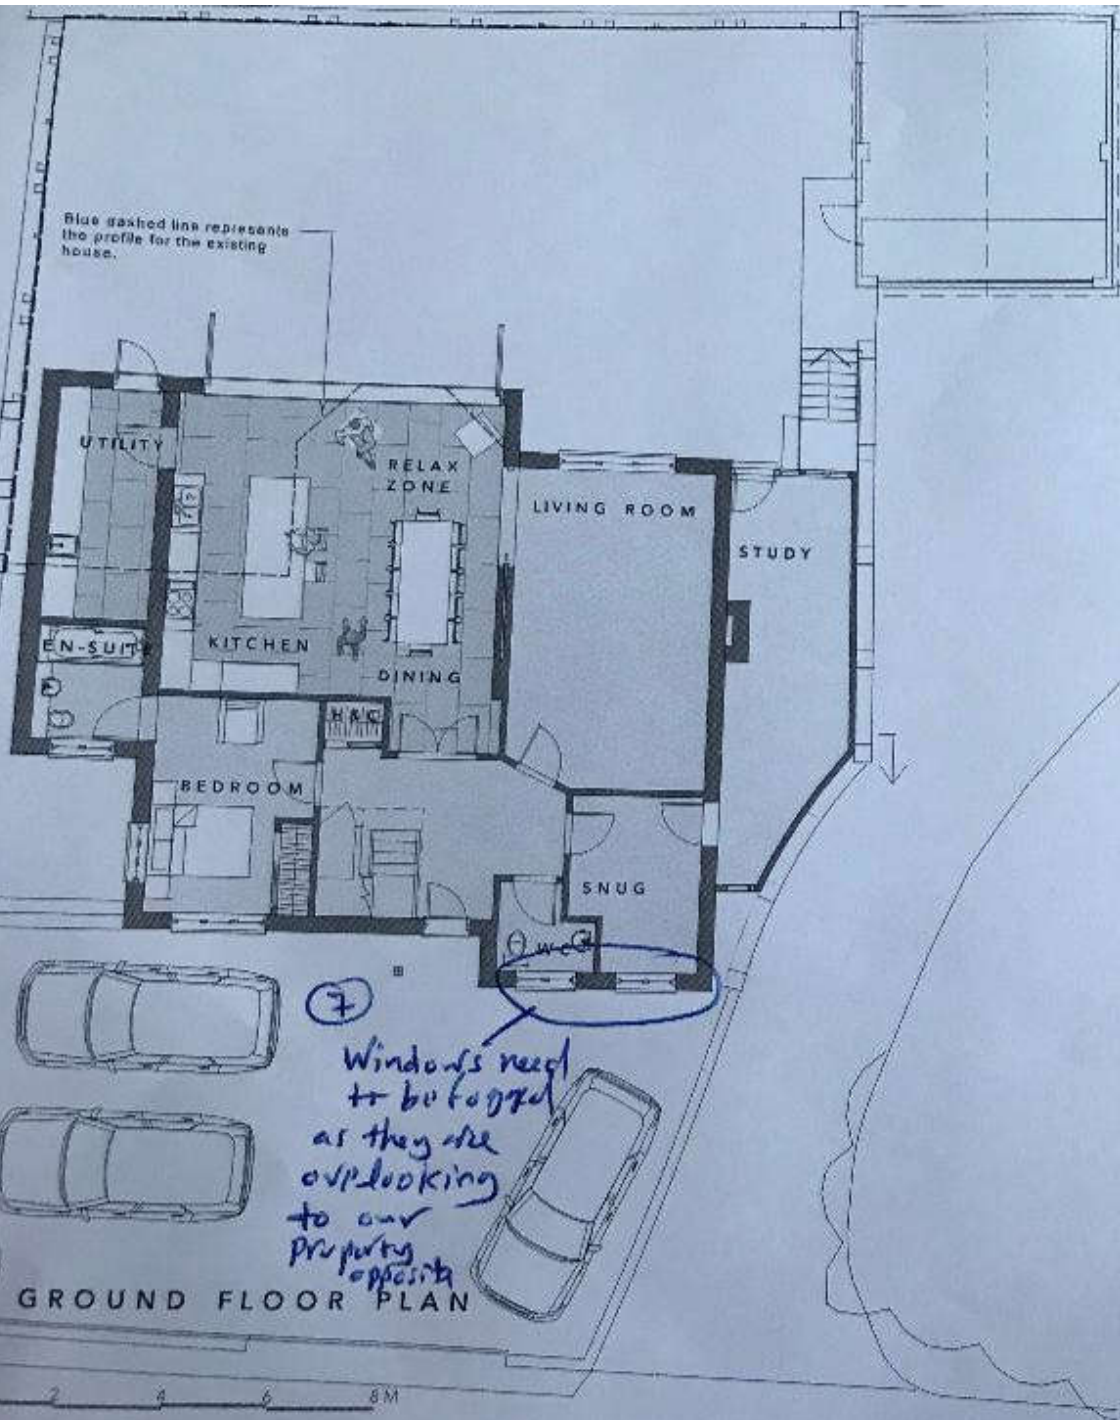

FIRST FLOOR PLAN

⑥ These windows need
to be obscured and not changed as
a result of any
internal work.

Mr & Mrs P. Patel
 8, Gieve Park Avenue,
 Southampton, Hants.
 PO9 3JR.



PROPOSED FLOOR PLANS.

Drawn by: HDC/LS
 Checked by: PSH/DPD
 Date: 11/09/03
 Scale: 1:100
 Project: PLANNING
 Date: Nov 20
 www.hampshiredesign.co.uk

[illegible]

Proposed materials to match
the existing -
roof tiles and face brickwork

on brickwork.

④ please confirm if there are no overlooking windows to our property opposite - due to this first floor extension

① Please confirm if the windows will remain as they are and obscured / No changed.

② What is the purpose of this window. It should be obscured / fogged as it overlooks our property opposite.

Proposed materials to match the existing -
roof tiles and face brickwork.

33.0m DATUM
EAST ELEVATION

33.0m DATE: 02/11/02

NORTH ELEVATION

Mr & Mrs P. Patel
7, Globe Park Avenue
Bedhampton, Hants.
PO9 3JR.

PROPOSED ELEVATIONS
1 of 2

100% Ltd 254/00000
 100000 100000
 Nov 20
 www.hampshiredesign.co.uk

HDC