




Proposed west elevations

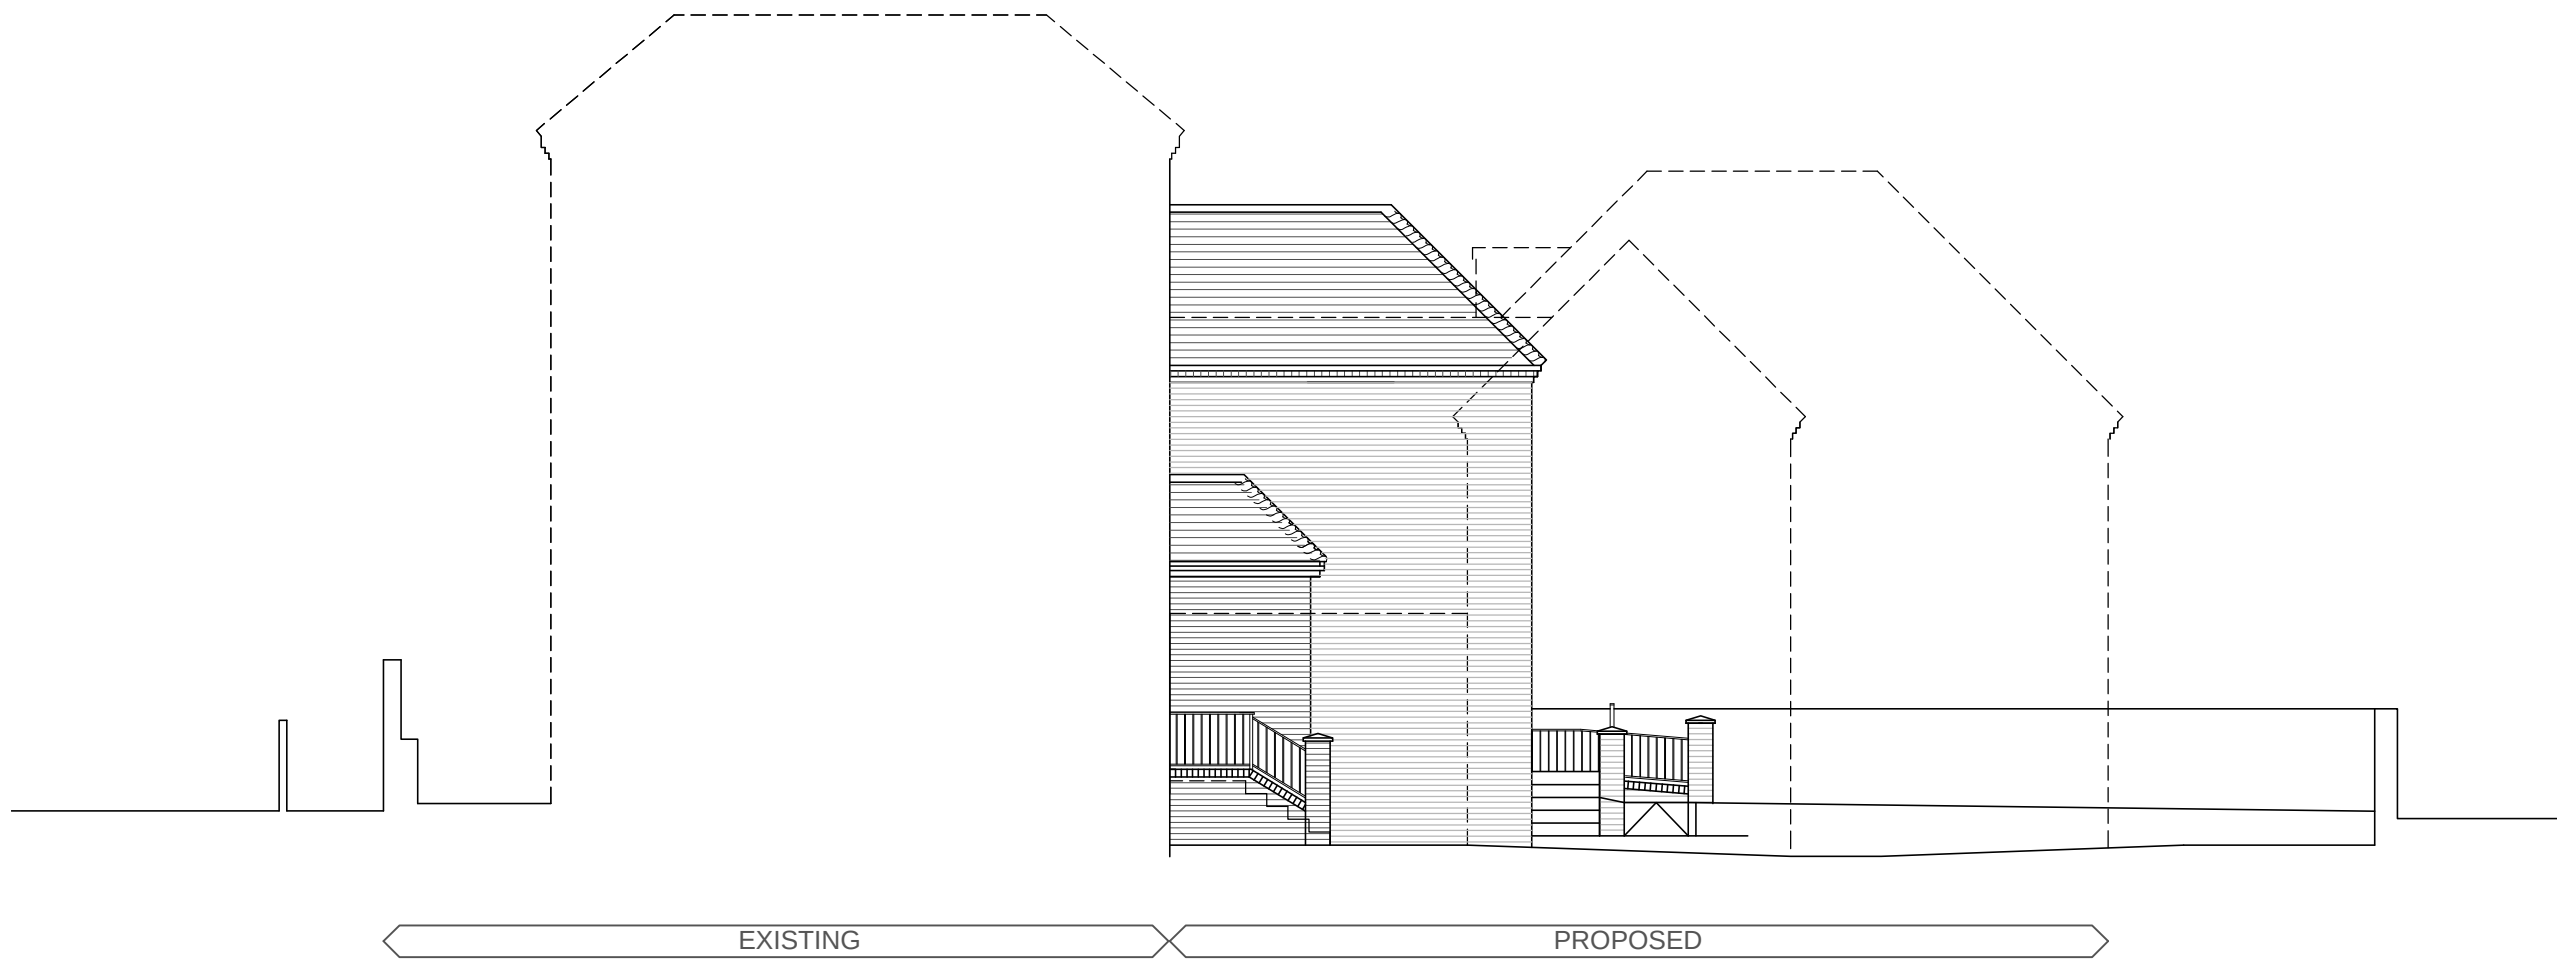

Proposed north elevations

notes

this drawing is the copyright of the **pdp architecture llp** and must not be reproduced in whole or part or used for the execution of works without their permission.

all dimensions to be checked on site prior to commencement of construction works and the architect notified of any discrepancy.

figured dimensions are to be used in preference to scaled dimensions.

no deviation from this drawing will be permitted without prior consent of the architect.

all drawings are prepared subject to a full measured and structural survey of the buildings and site.

all structural work is subject to the appointment of a structural engineer to confirm and agree the structural proposals.

os promap licence no. 100020449.


health & safety:
exceptional risks involving specific methods of construction or exceptional maintenance issues:

NO SIGNIFICANT RISK

revision		notes	date	drawn	checked
A	External steps added	12.11.13	GSE		
B	AS BUILT	19.11.14	GSE		



AS BUILT

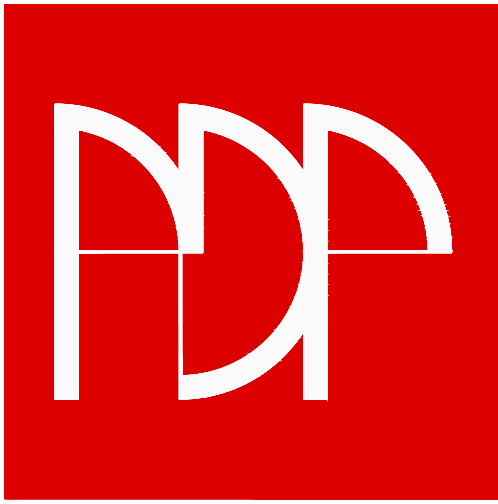

pdp architecture llp

chartered architects town planning
interior design consultants

2 beechworth road havant
hampshire po9 1ax
tel 023 9248 1100
fax 023 9247 5050
email pdp@pdp-architects.co.uk

www.pdp-architects.co.uk

project	Proposed Development Homewell House Havant		
detail	Proposed North & West elevations		
drawn	GSE	checked	
date	JULY 2013	status	AS BUILT
a1 scale	1:100	a3 scale	1:200
		rev	27940-WD-200 B