

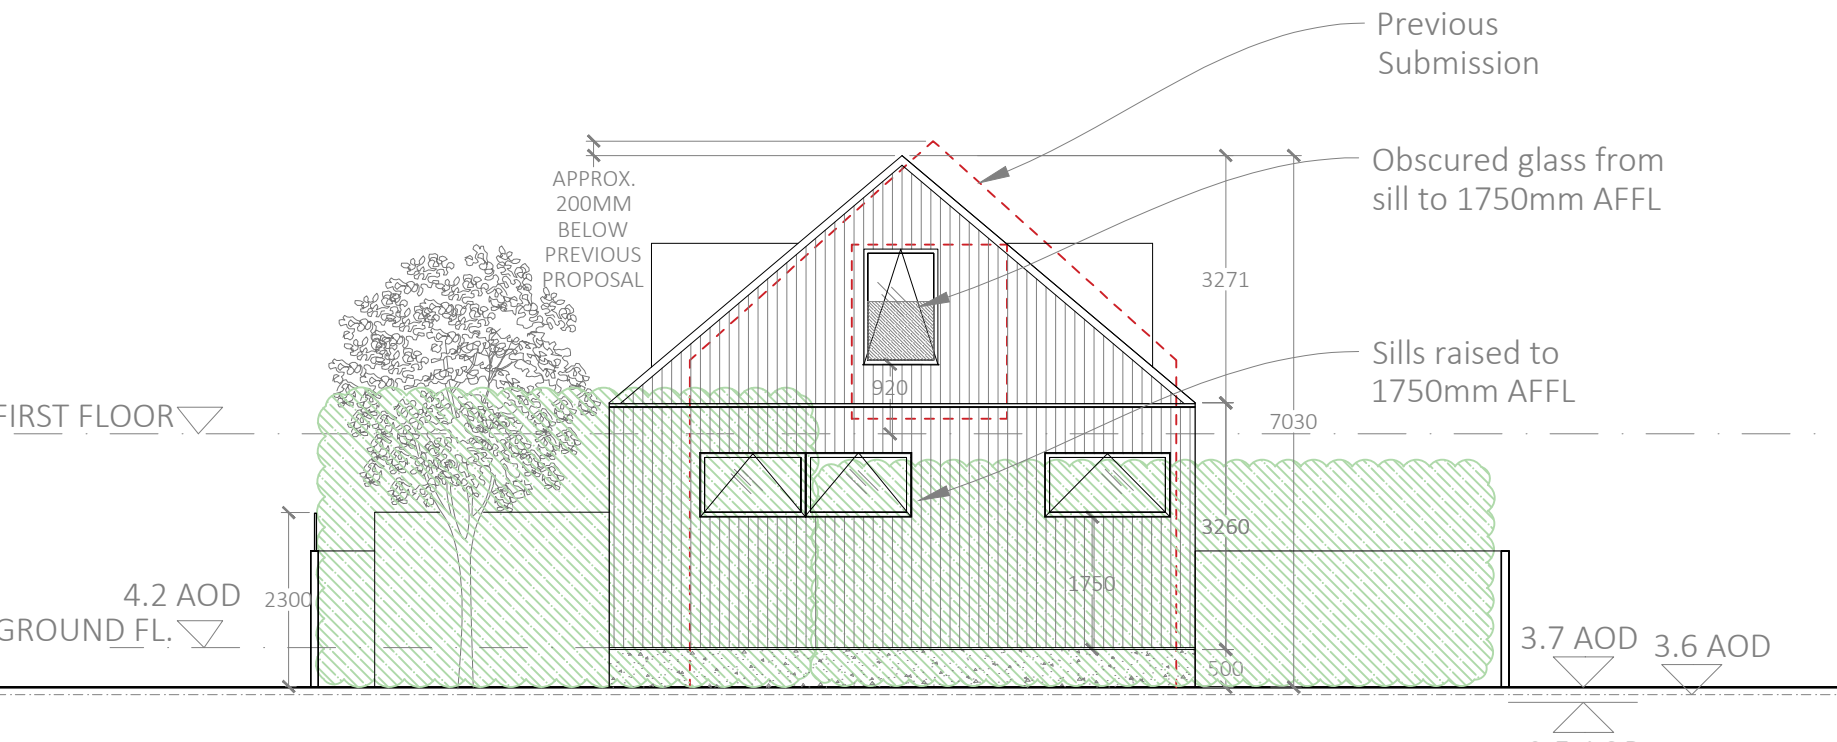
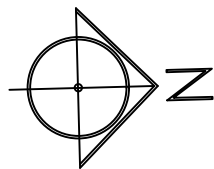



Proposed South and West Elevations

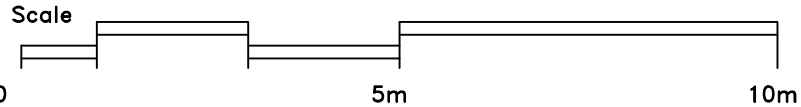

South Elevation

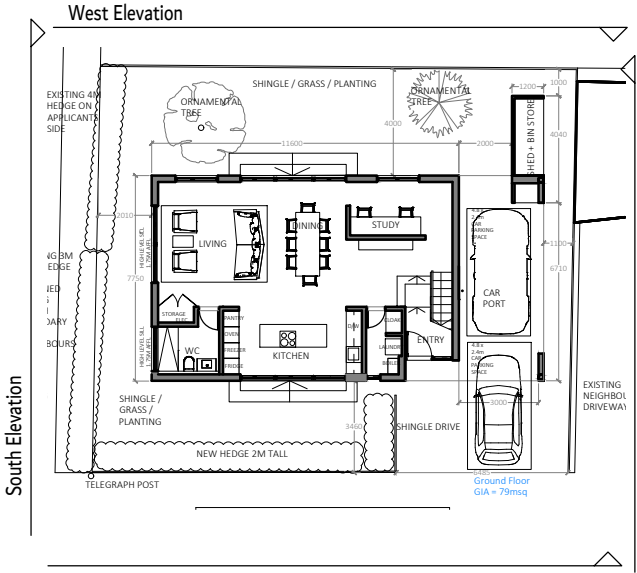

CURRENT 1:1000 YEAR
EXTREME TIDAL FLOOD
LEVEL FOR CICHESTER
HARBOUR = 3.6 ADD.
HBC STRATEGIC RISK
ASSESMENT, SITE REF
HY16 NAB CAR PARK,
PAGE 27)

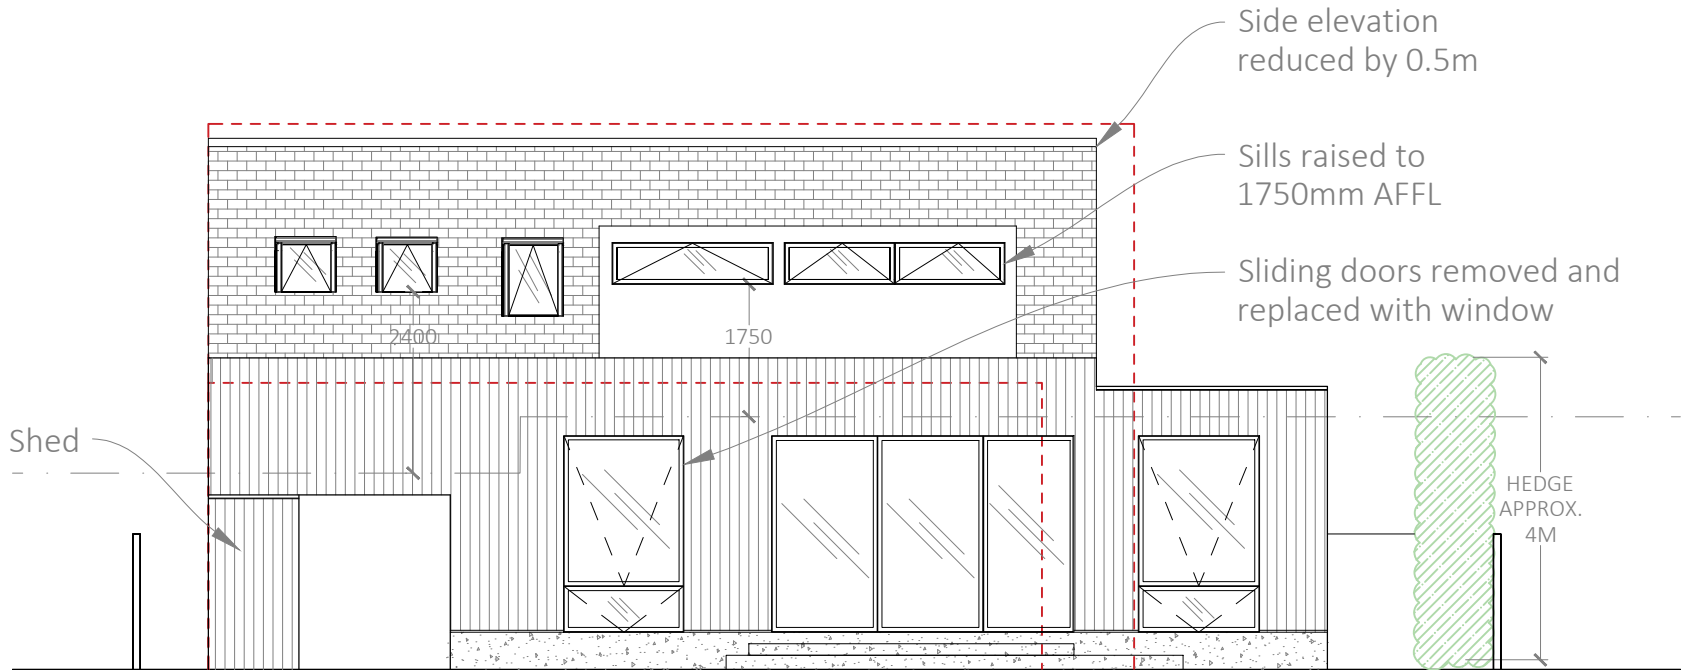

West Elevation

REV: A 04/02/2021 Reduced height by 200mm and bulk of rear first floor extension, original proposal shown in dotted red line
REV:B 09/02/2021 Revised proposal added
REV:C 25/02/2021 Revised proposal, decreased length of house by 500mm and all high level windows cill up to 1750 AFFL
REV:D 01/03/2021 Amended 'obscured film to glazing' to 'obscured glass'

PLANNING

RS

ARCHITECTURE

CLIENT:

PROJECT:
3 Nutbourne

TITLE:
Proposed South + West Elevations

DRAWING NUMBER : 008.D

Scale : 1:100 @ A3

DATE: 09/12/2020
DRAWN BY: AS APPROVED BY: RS

194 Southwood Road, Hayling Island,
Hampshire, PO11 9QL
07887933281
rob@rs-architecture.co.uk
www.rs-architecture.co.uk