

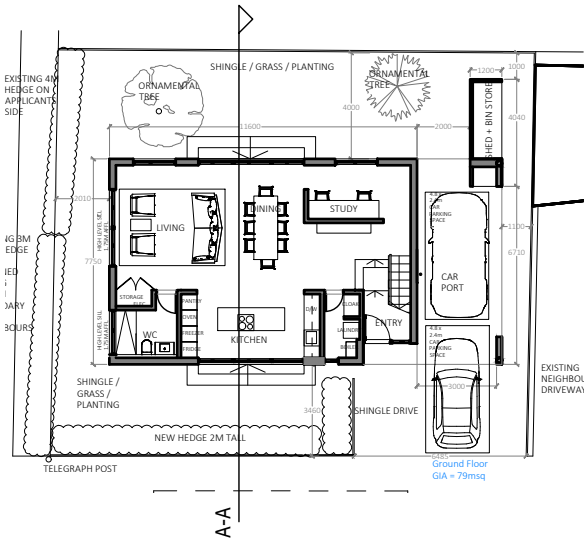
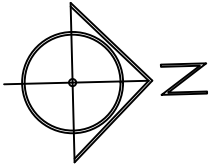


Proposed Section A-A

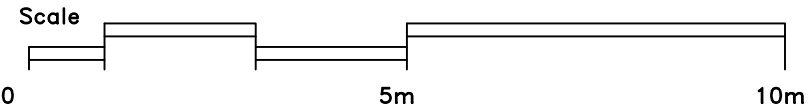

Fence to rear, solid timber panels to 1800mm high with 500mm lattice screen above

HEIGHT REDUCED APPROX. 190

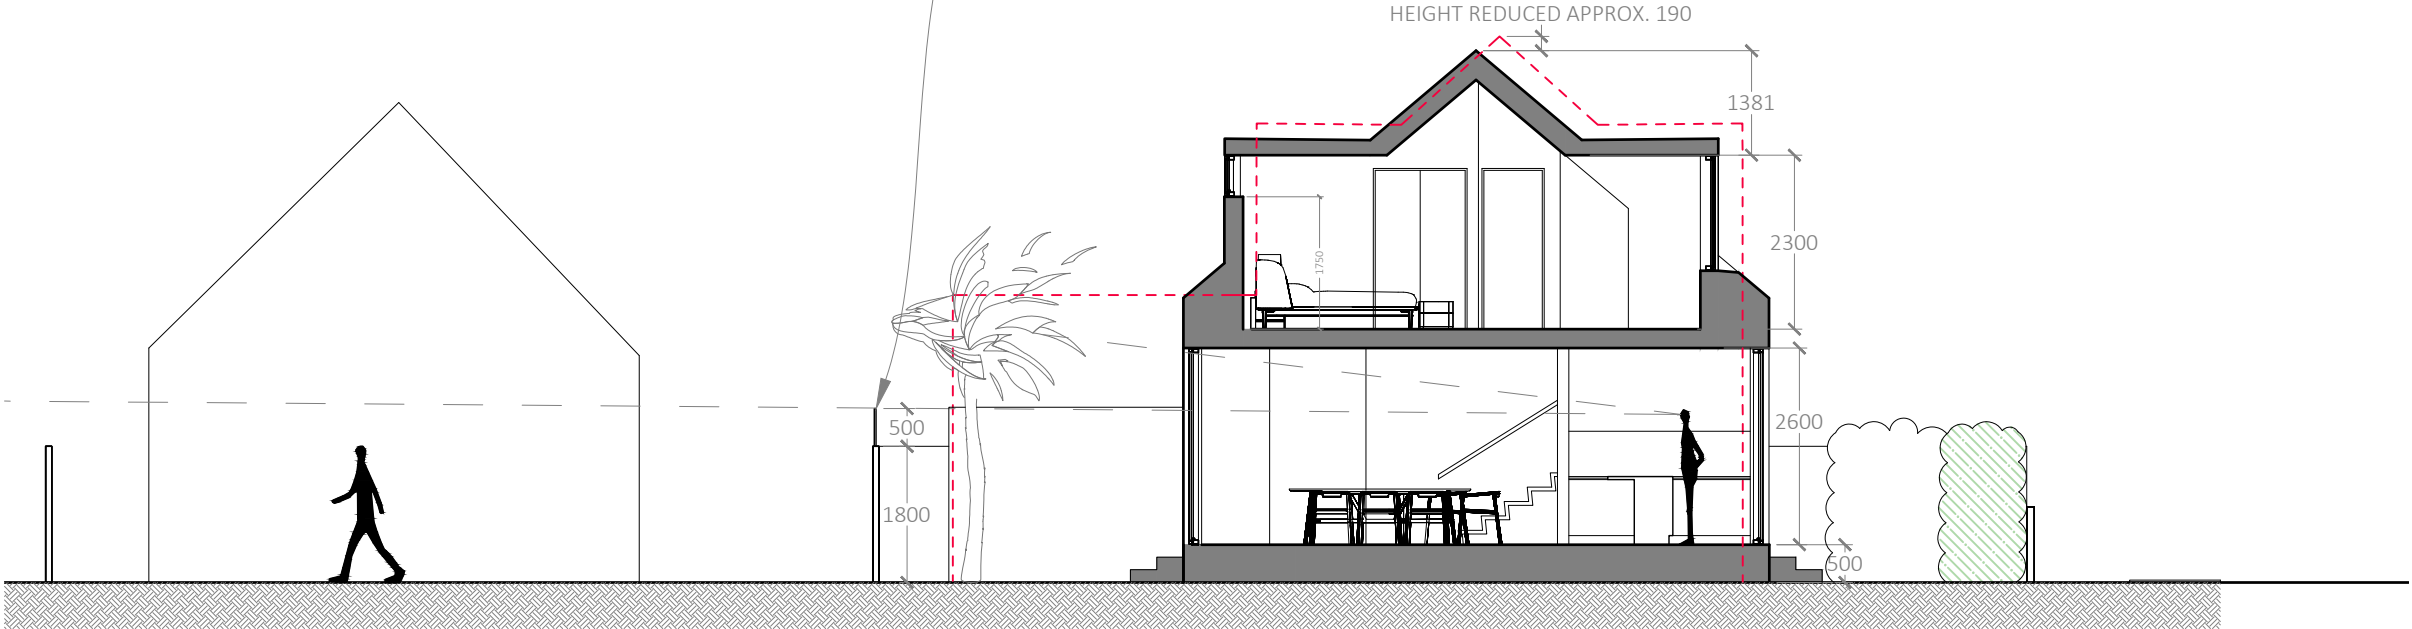

APPROX. SIZE AND LOCATION
OF 32 WHEATLANDS AVENUE

REV: A 04/02/2021 Reduced height by 200mm
and bulk of rear first floor extension, original
proposal shown in dotted red line
REV:B 25/02/2021 Amended in line with reduced
scheme

PLANNING

RS
ARCHITECTURE

CLIENT:

PROJECT:
3 Nutbourne
TITLE:
Proposed Section A-A
DRAWING NUMBER : 009.B
Scale : 1:100 @ A3
DATE: 09/12/2020
DRAWN BY: AS APPROVED BY: RS
194 Southwood Road, Hayling Island,
Hampshire, PO11 9QL
07887933281
rob@rs-architecture.co.uk
www.rs-architecture.co.uk