


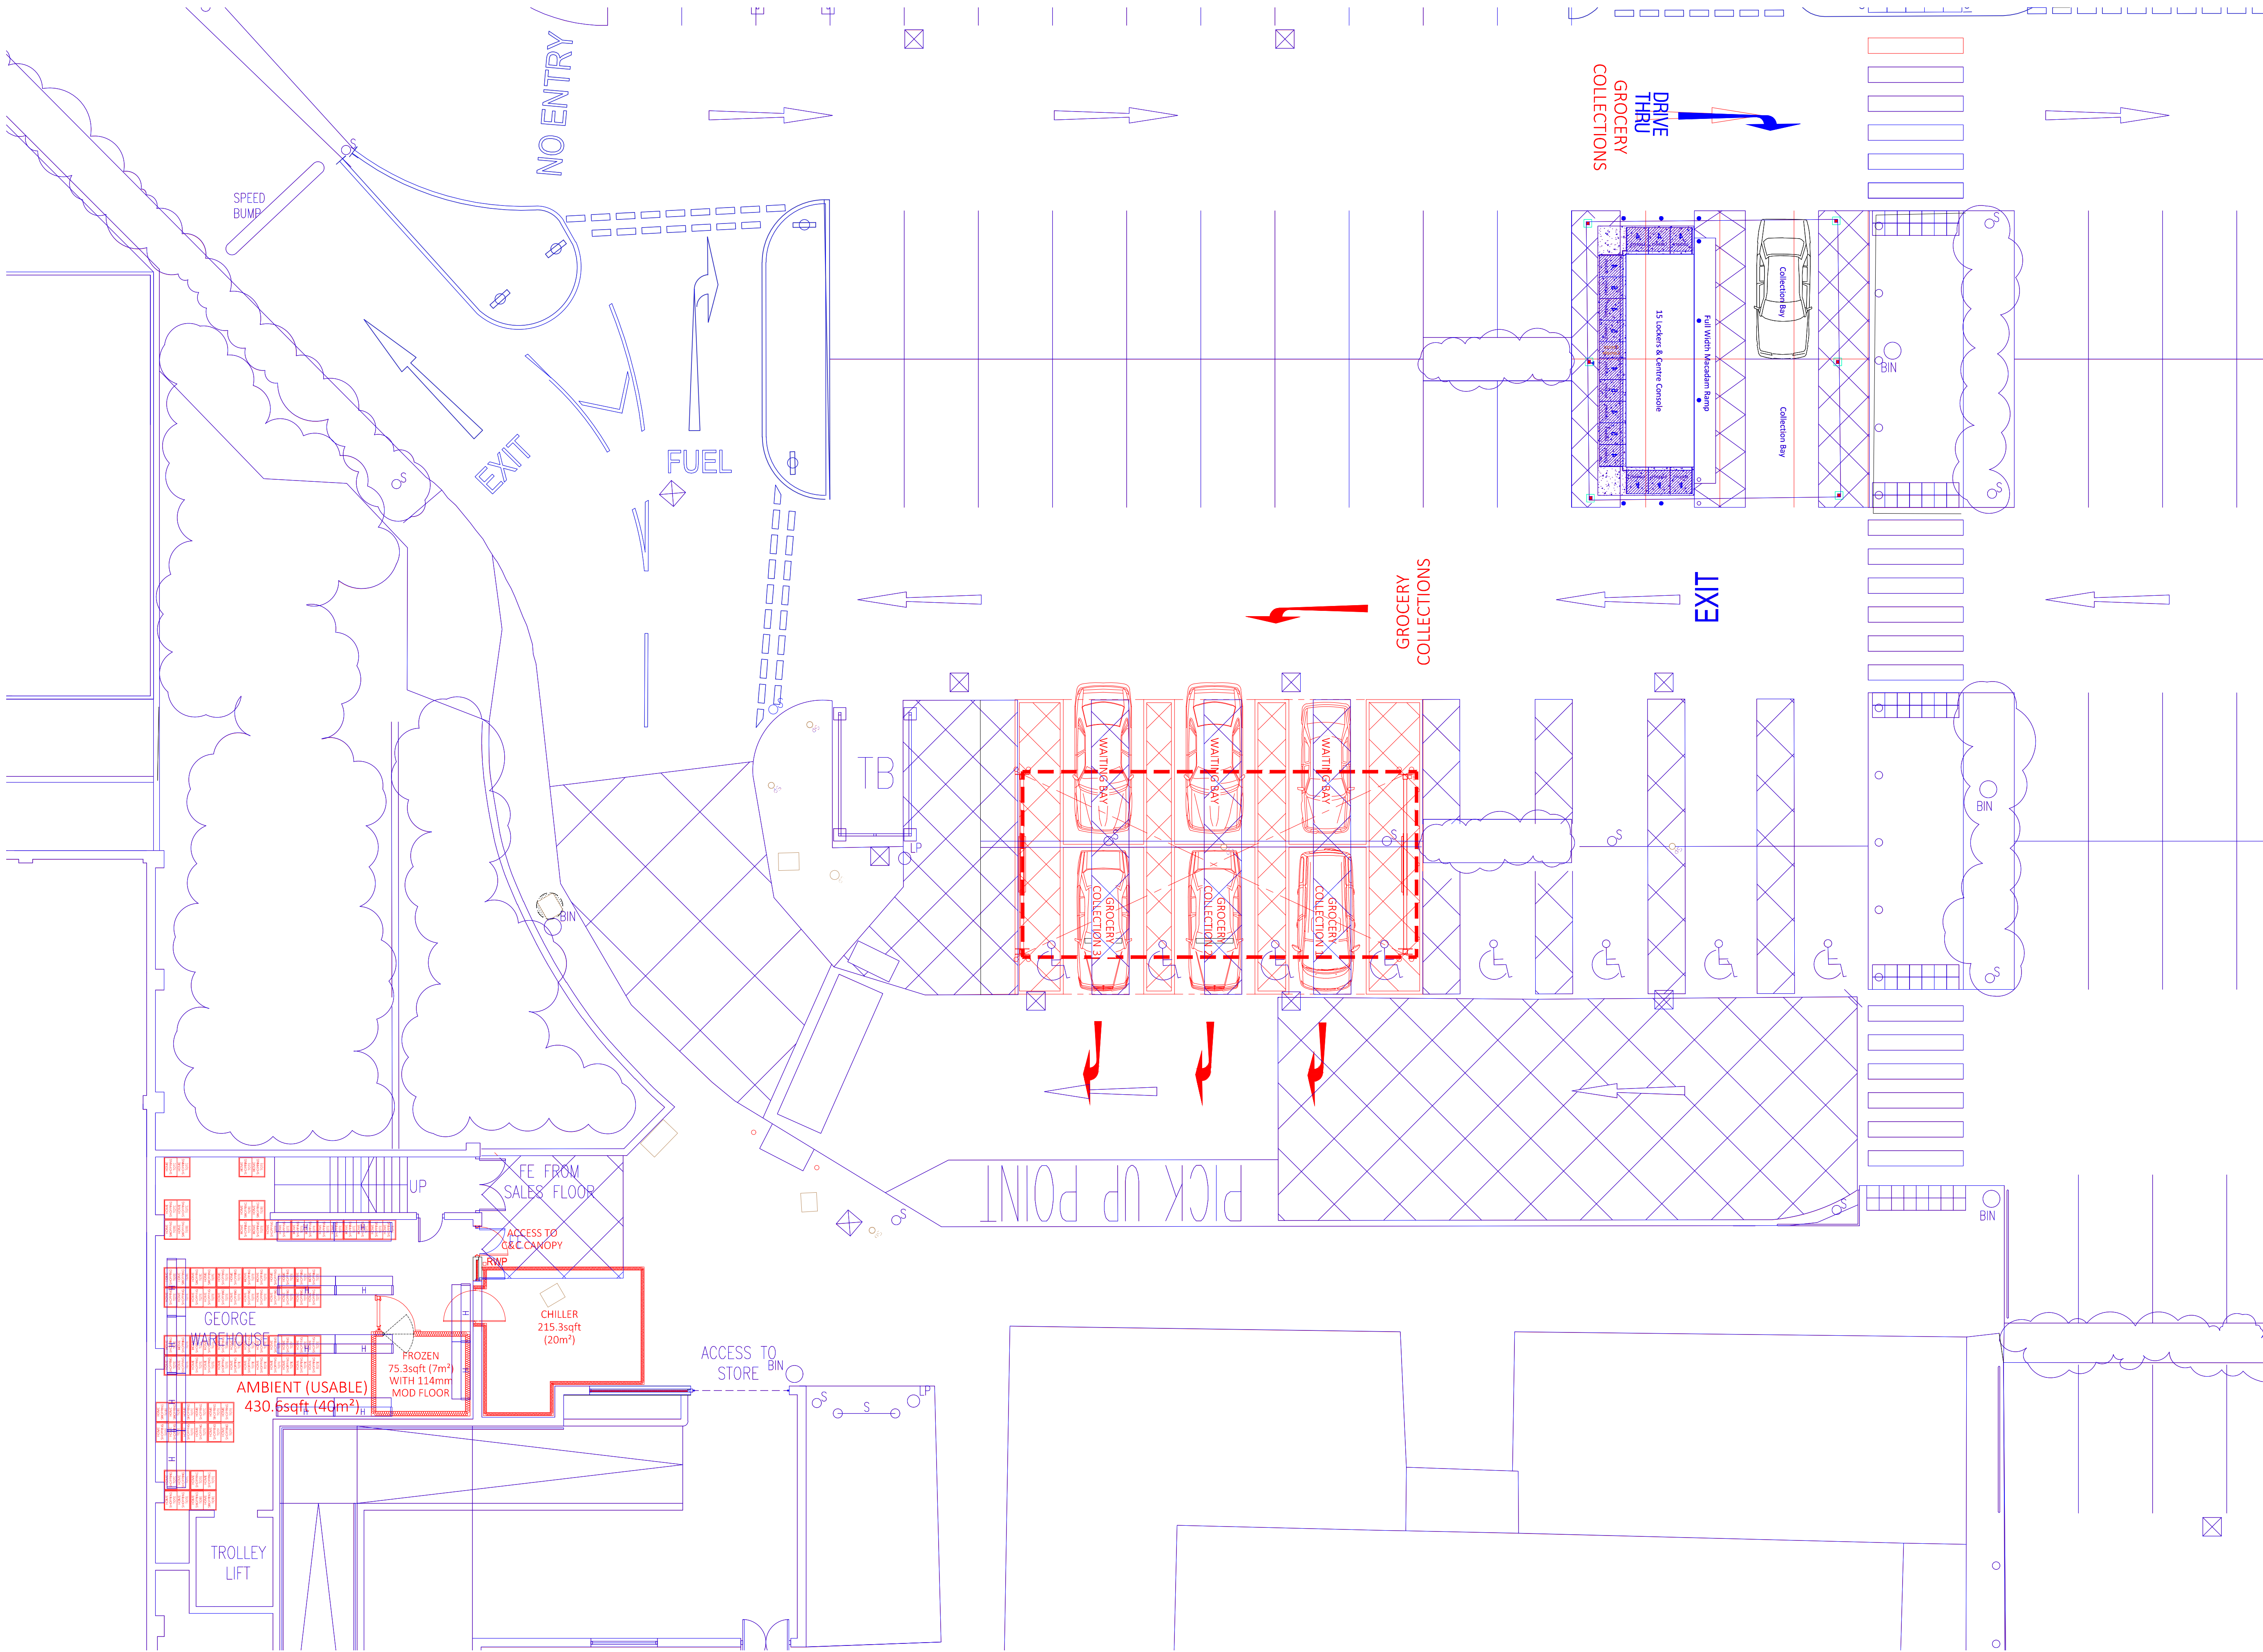

© Whittam Cox Architects - Disclaimer:

This drawing is copyright of WCEC Group Ltd trading as Whittam Cox Architects, and shall not be reproduced nor used for any other purpose without the written permission of the Architects. This drawing must be read in conjunction with all other related drawings and documentation. It is the contractors responsibility to ensure full compliance with the Building Regulations. Do not scale from this drawing, use figured dimensions only. It is the contractors responsibility to check and verify all dimensions on site. Any discrepancies to be reported immediately. IF IN DOUBT ASK.
Materials not in conformity with relevant British or European Standards/Codes of practice or materials known to be deleterious to health & safety must not be used or specified on this project.

NOTES :

This drawing is to be read in conjunction with the following Whittam Cox Architects and ASDA documentation:

- Project specific Scope Of Works

Any discrepancies between this drawing and the above should be reported to the contract administrator.

C.D.M :

There are **NO SIGNIFICANT** risks associated with the works on this drawing that a competent contractor would not foresee.

KEY TO LINETYPES :

Red lines = **PROPOSED LAYOUT**

Blue lines = **EXISTING LAYOUT**

11/05/21	Second Issue	TH / SJS
06/03/21	First Issue	MS / SJS
PLANNING		
No.	Description	Drawn/Checked
CLIENT		



PROJECT
PROPOSED HOME SHOPPING WORKS
ASDA BRIGHTON MARINA
TITLE
EXISTING & PROPOSED HOME SHOPPING OVERLAY

DRAWING STATUS		
PLANNING		
DRAWN	MS	CHECKED SJS
SCALE	1:100 @ A1	
DATE	MARCH 2021	

Whittam Cox ARCHITECTS
Chesterfield / 01246 260261
London / 020 3388 0019
Leeds / 0113 3560018
whittamcox.com

JOB NO.	DRAWING NO.	REV
200670	PL_06	A