




Proposed Site Plan


Rev A	First Issue	Feb 20
Rev B	Fencing details updated	Feb 20
Rev C	Highways info added	Mar 20
Rev D	Notation amended	Apr 20
Rev E	Equipment added	Apr 20
Rev F	Planting added	May 20
Rev G	Drainage detailed	Sep 20
Rev H	As Built Shown	Oct 20
Rev I	Planting Dimensioned	Oct 20
Rev J	Planting Adjusted to match site	Nov 20
Rev K	Screen fencing added to Key	Feb 21
Rev L	Gate position returned to approved	

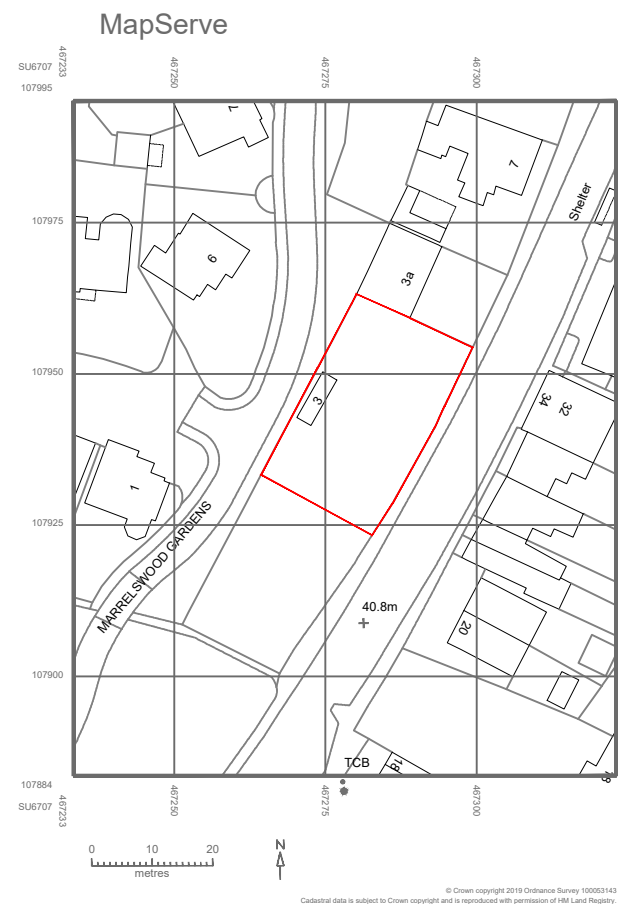

Location Plan

Boundary Treatments	
A-B	1.8m Close Boarded Fence (Existing)
B-C	2.4m Green Palisade fence
D-E	Existing 5.6m opening/ Dropped Kerb, with recessable Bollards
E-F	2.1m Green Palisade fence
F-A	2.1m Green Palisade fence
G-B	2.0m (H) Close Boarded Fence located outside of boundary
H-J	1.8m screen fencing

- Dry/ Clean
- Jet Wash/Foam
- Wait
- Boundary Fence

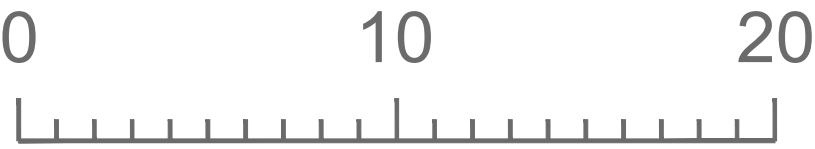

© Crown copyright 2019 Ordnance Survey 100053143
Cadastral data is subject to Crown copyright and is reproduced with permission of HM Land Registry.

Solent Design Ltd
5 The old Railway
Spring Garden Lane
Gosport
PO12 1FQ

SOLENT DESIGN.

tel: 02392 580745 mob: 07771 355742 e-mail: info@solentplans.com

PROJECT DESCRIPTION:
New Car Wash
DRAWING TITLE:
Site & Location Plans

ADDRESS: London Road Purbrook Havant	CLIENT: Mr T Ferrati
	FIRST DRAWN: February 2020

DRAWING No:
SD-2019-01

drawing status:
Issued for Comment

SCALE:
1:100
1:1250

NORTH