




ROOF TILE KEY



CS26 NATURAL ROOFING SLATE

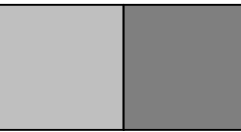

CLAY LARGE PROFILE PLAIN ROOF TILE TO MAIN ROOFS, SMALL PROFILE PLAIN PORCH TILE TO CO-ORDINATE WITH MAIN ROOF TILE

FOR INFORMATION

Drawing Notes:



red line indicates previous layout



Project Title
Manors Farm, Bedhampton
Document Title
Proposed Site Plan overlayed with previous layout
Drawing Scale / Sheet Size
1/500@A1

Date
November 2020
Drawn by / Checked by
IS / CK
Signature

Drawing Number / Revision
sk20 / RevB

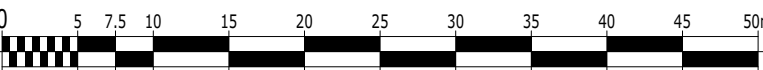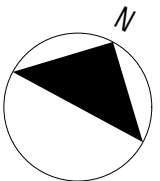

Revisions

B	B&W base layout shown.	07.12.20	IS / CK
A	The original base layout (match the one presented at the committee) shown in red line.	27.11.20	IS / CK

Drawing Status

- ☐ Preliminary
☐ Planning
☐ Building Regulations
☐ Construction



HGP Architects Ltd.
Copyright Reserved.
Check dims. on site.