



- GENERAL NOTES
1. The location, size, depth and identification of existing services that may be shown or referred to on this drawing have been assessed from non-invasive observations, record drawings or the file. The contractor shall safely carry out intrusive investigations, trial holes or soundings prior to commencing work to satisfy himself that it is safe to proceed and that the assessments are accurate. Any discrepancies shall be notified to gta prior to works commencing.
 2. Tender or billing drawings shall not be used for construction or the ordering of materials.
 3. Do not scale. All dimensions and levels to be site confirmed.
 4. This drawing shall be read in conjunction with all relevant architects, consultants drawings and specifications, together with H&S plan requirements.
 5. Copyright : This drawing must not be copied, amended nor reproduced without the prior written agreement of gta.
 6. All drawings specifications and recommendations made by gta are subject to Local Authority and other relevant Statutory Authorities approval. Any works or services made abortive due to the client proceeding prior to these approvals is considered wholly at the Client's risk. gta hold no responsibility for resulting abortive works or costs.

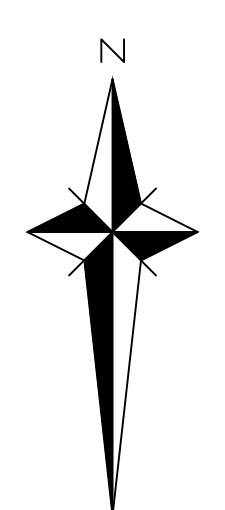


INSET DETAIL BELOW

Exceedance flow path

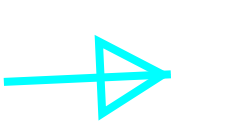


Exceedance flow path in event of Surface Water pump and upstream storage failure

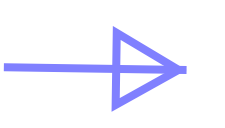

RCP - Mark Up
Exceedance Flow
Date: 25/01/2021

Exceedance flow in the event of a surface water pumping station failure

STAGE 1 SURVEY WORKS UNIT
REFER TO R&A DRAWING
(H&S) 101 FOR DETAILS

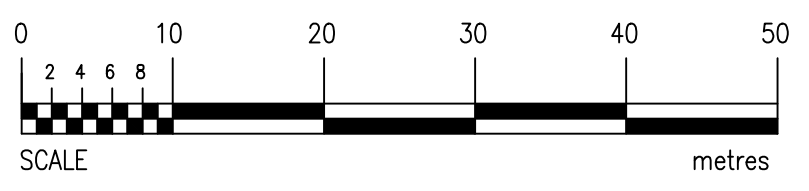

Rev	Initial Issue	20.11.20	DMS	ds
Status	Amendments	Date	Des	Chk
Client	PLANNING			
Project	 BARRATT HOMES			
Title	PEBBLE WALK, SINAH LANE HAYLING ISLAND, HANTS			
	OUTLINE SITE LEVELS PLANNING LAYOUT			
Date	NOVEMBER 2020	Scale @ A0	1:500	
Base Layout Ref.		CAD File ref.		
Client's Ref.		Project Ref.	10162	
 Civils & Transport Gloverwater House, 65a Church Walk, Burgess Hill, West Sussex, RH15 9AS Tel 01444 871444 Web: www.gtaivils.co.uk				
Drawing Number	10162/101			Rev: P1