


HAVANT BOROUGH
COUNCIL
09 APR 20
RECEIVED

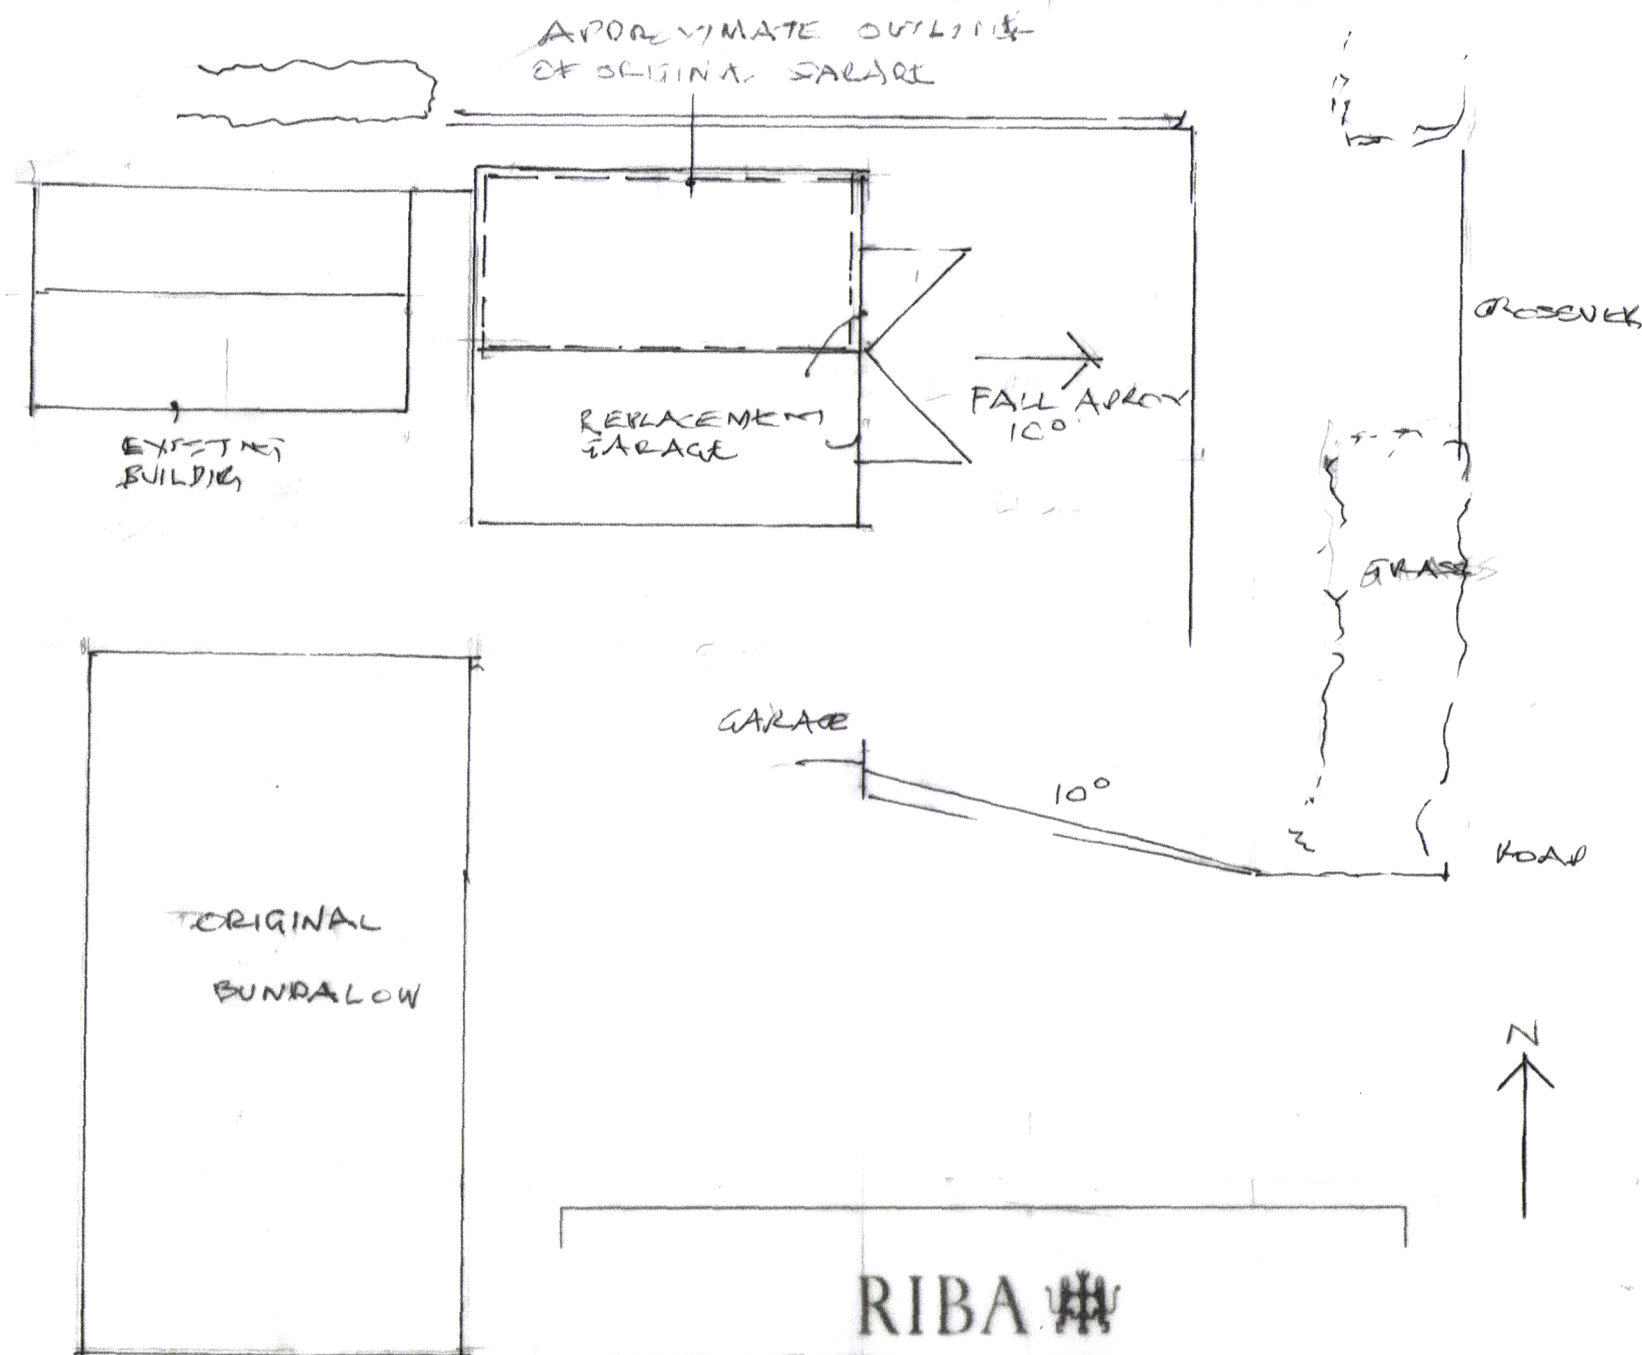

RIBA

Chartered Practice

John Groom Chartered Architect
32A High Street, Emsworth, Hampshire PO10 7AW
T 01243 430617 M 07780 997563
info@johngroomarchitect.co.uk
www.johngroomarchitect.co.uk
 JOB: Retrospective planning application for garage
 LOCATION: 2 Wraysbury Park Drive, Emsworth, PO10 7UU
 DRG TITLE: Plans, and elevations as built
 SCALE: 1:100 DRAWN: JG
 DRG NO: 19/314/1 DATE: 17 January 2020