




Front Elevation - Facade Treatment A

Plot Numbers
Plot 1 (Handed)
Plot 2
Plot 13 (Handed & Hipped Roof)




Front Elevation - Facade Treatment B

Plot Numbers
Plot 9 (Handed)
Plot 10
Plot 16 (Handed)
Plot 17

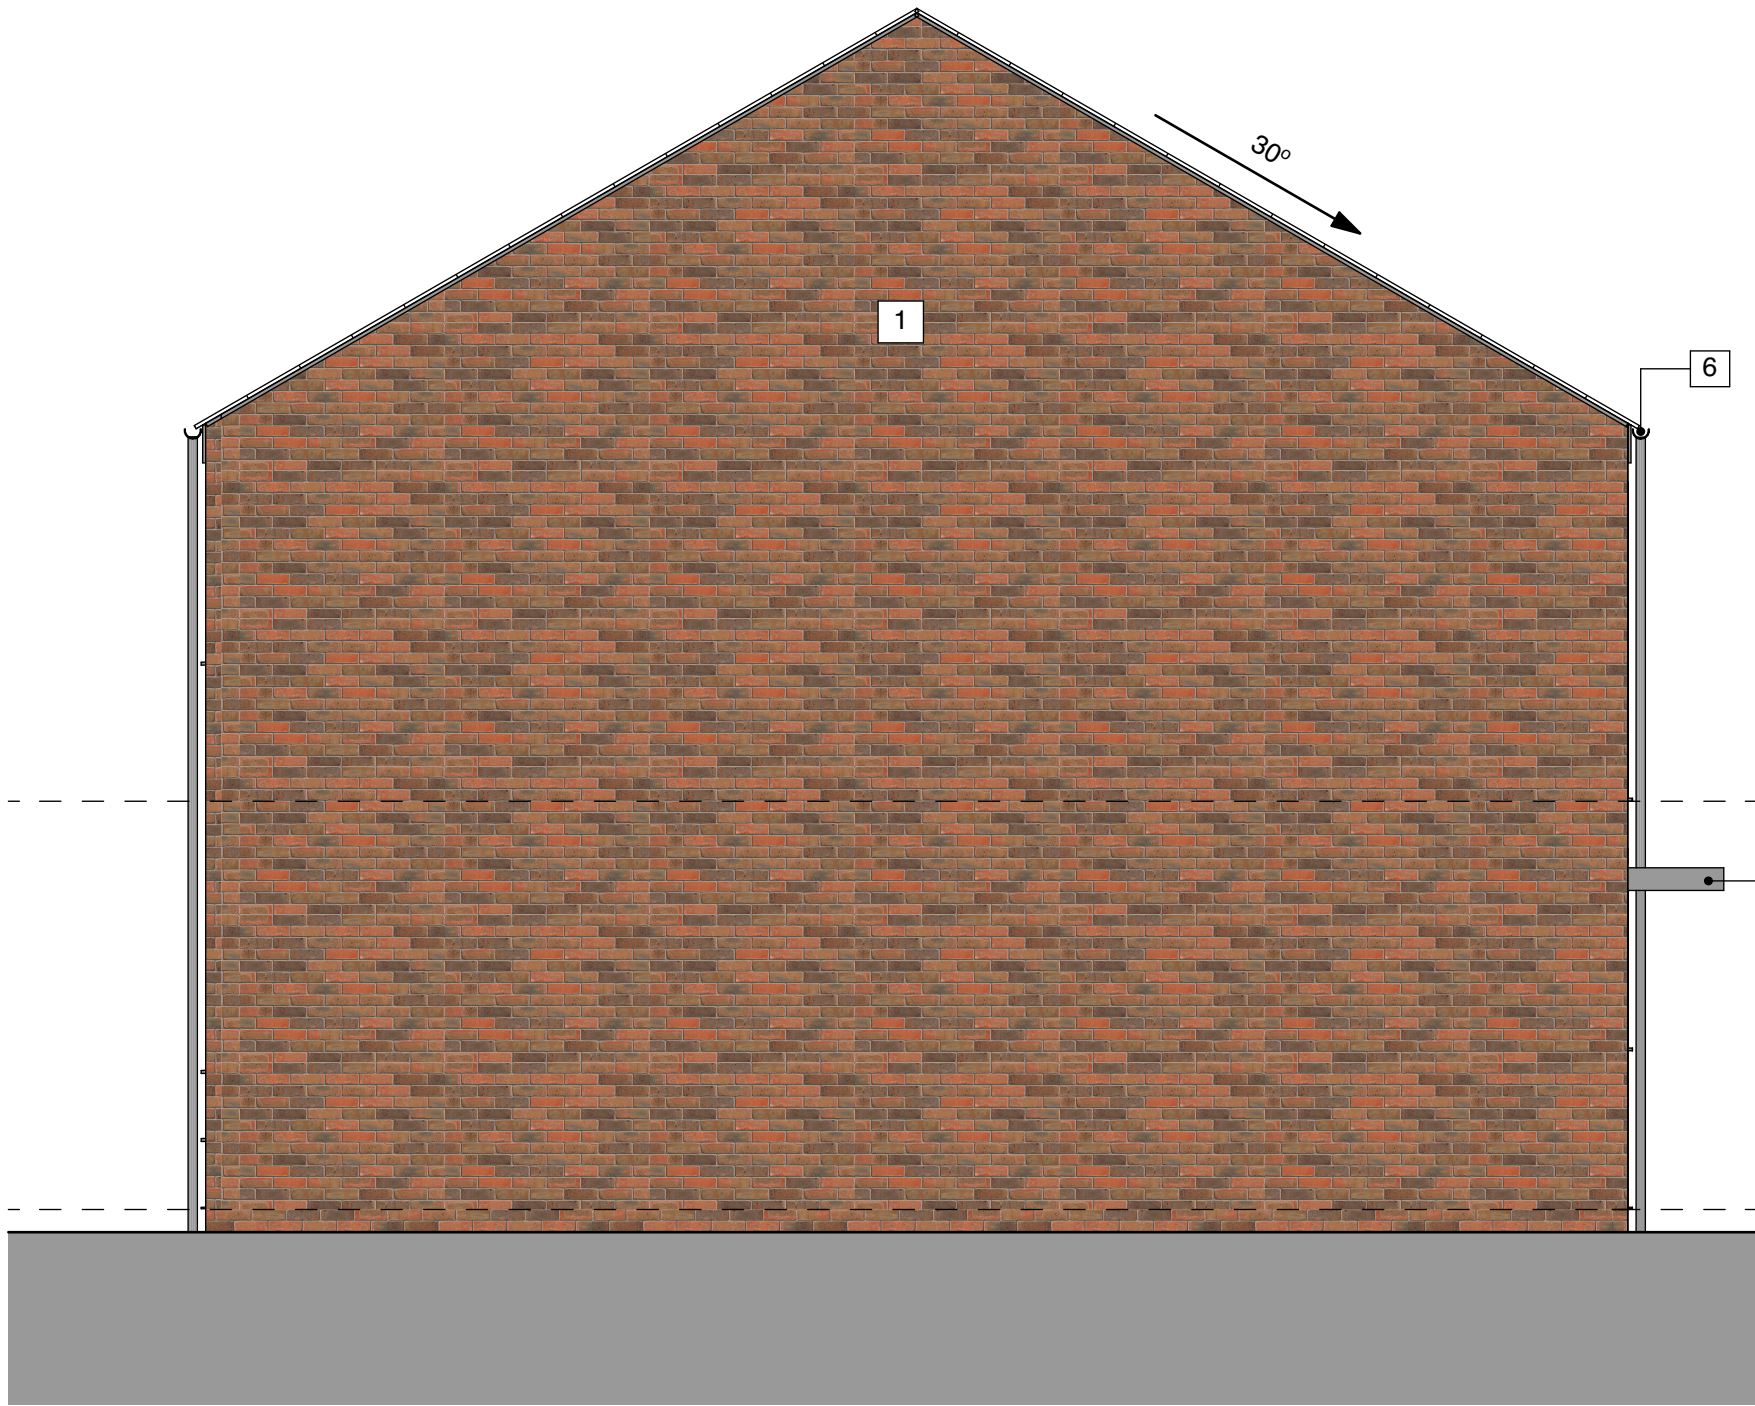


Left Elevation

Plot Numbers
Plot 1 (Handed)
Plot 2
Plot 9 (Handed)
Plot 10
Plot 13 (Handed)
Plot 16 (Handed)
Plot 17

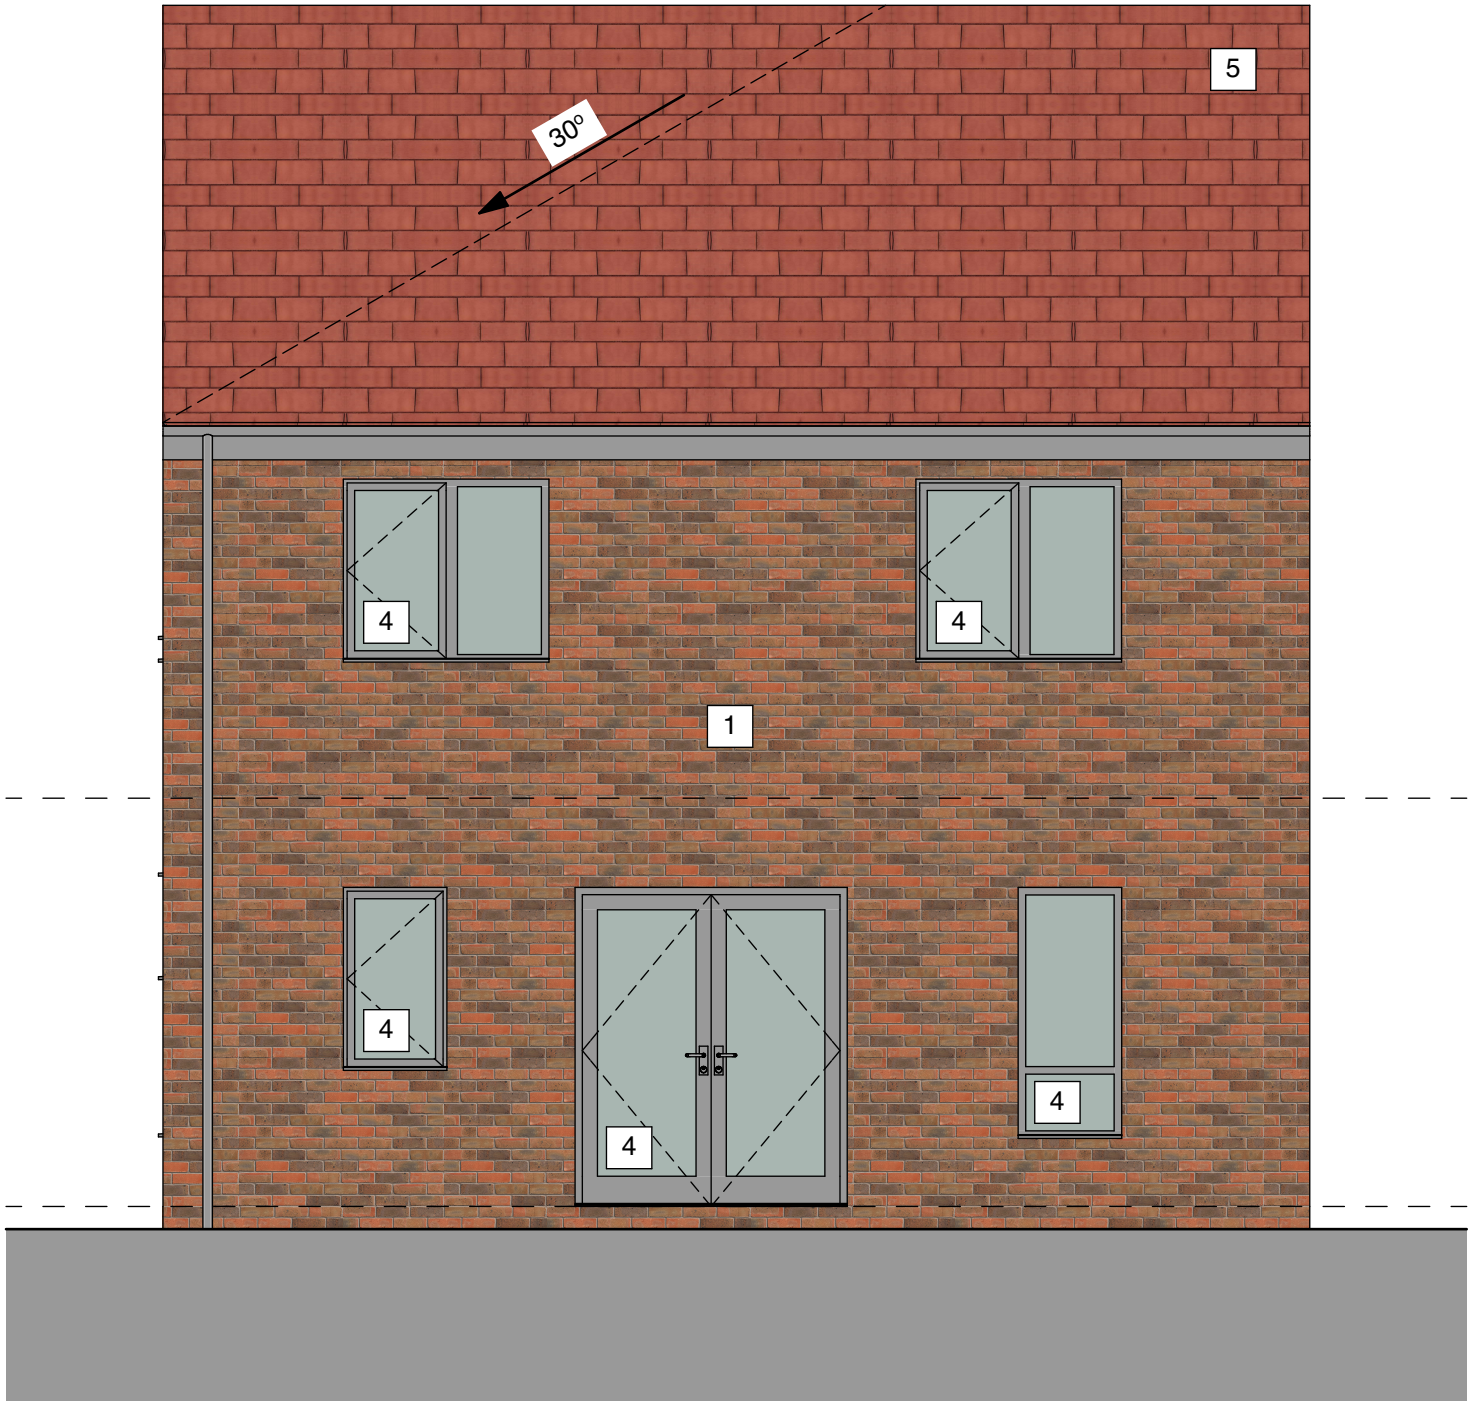


Rear Elevation

Plot Numbers
Plot 1 (Handed)
Plot 2
Plot 9 (Handed & Roof Facade Treatment B)
Plot 10 (Roof Facade Treatment B)
Plot 13 (Handed & Hipped Roof)
Plot 16 (Handed & Roof Facade Treatment B)
Plot 17 (Roof Facade Treatment B)

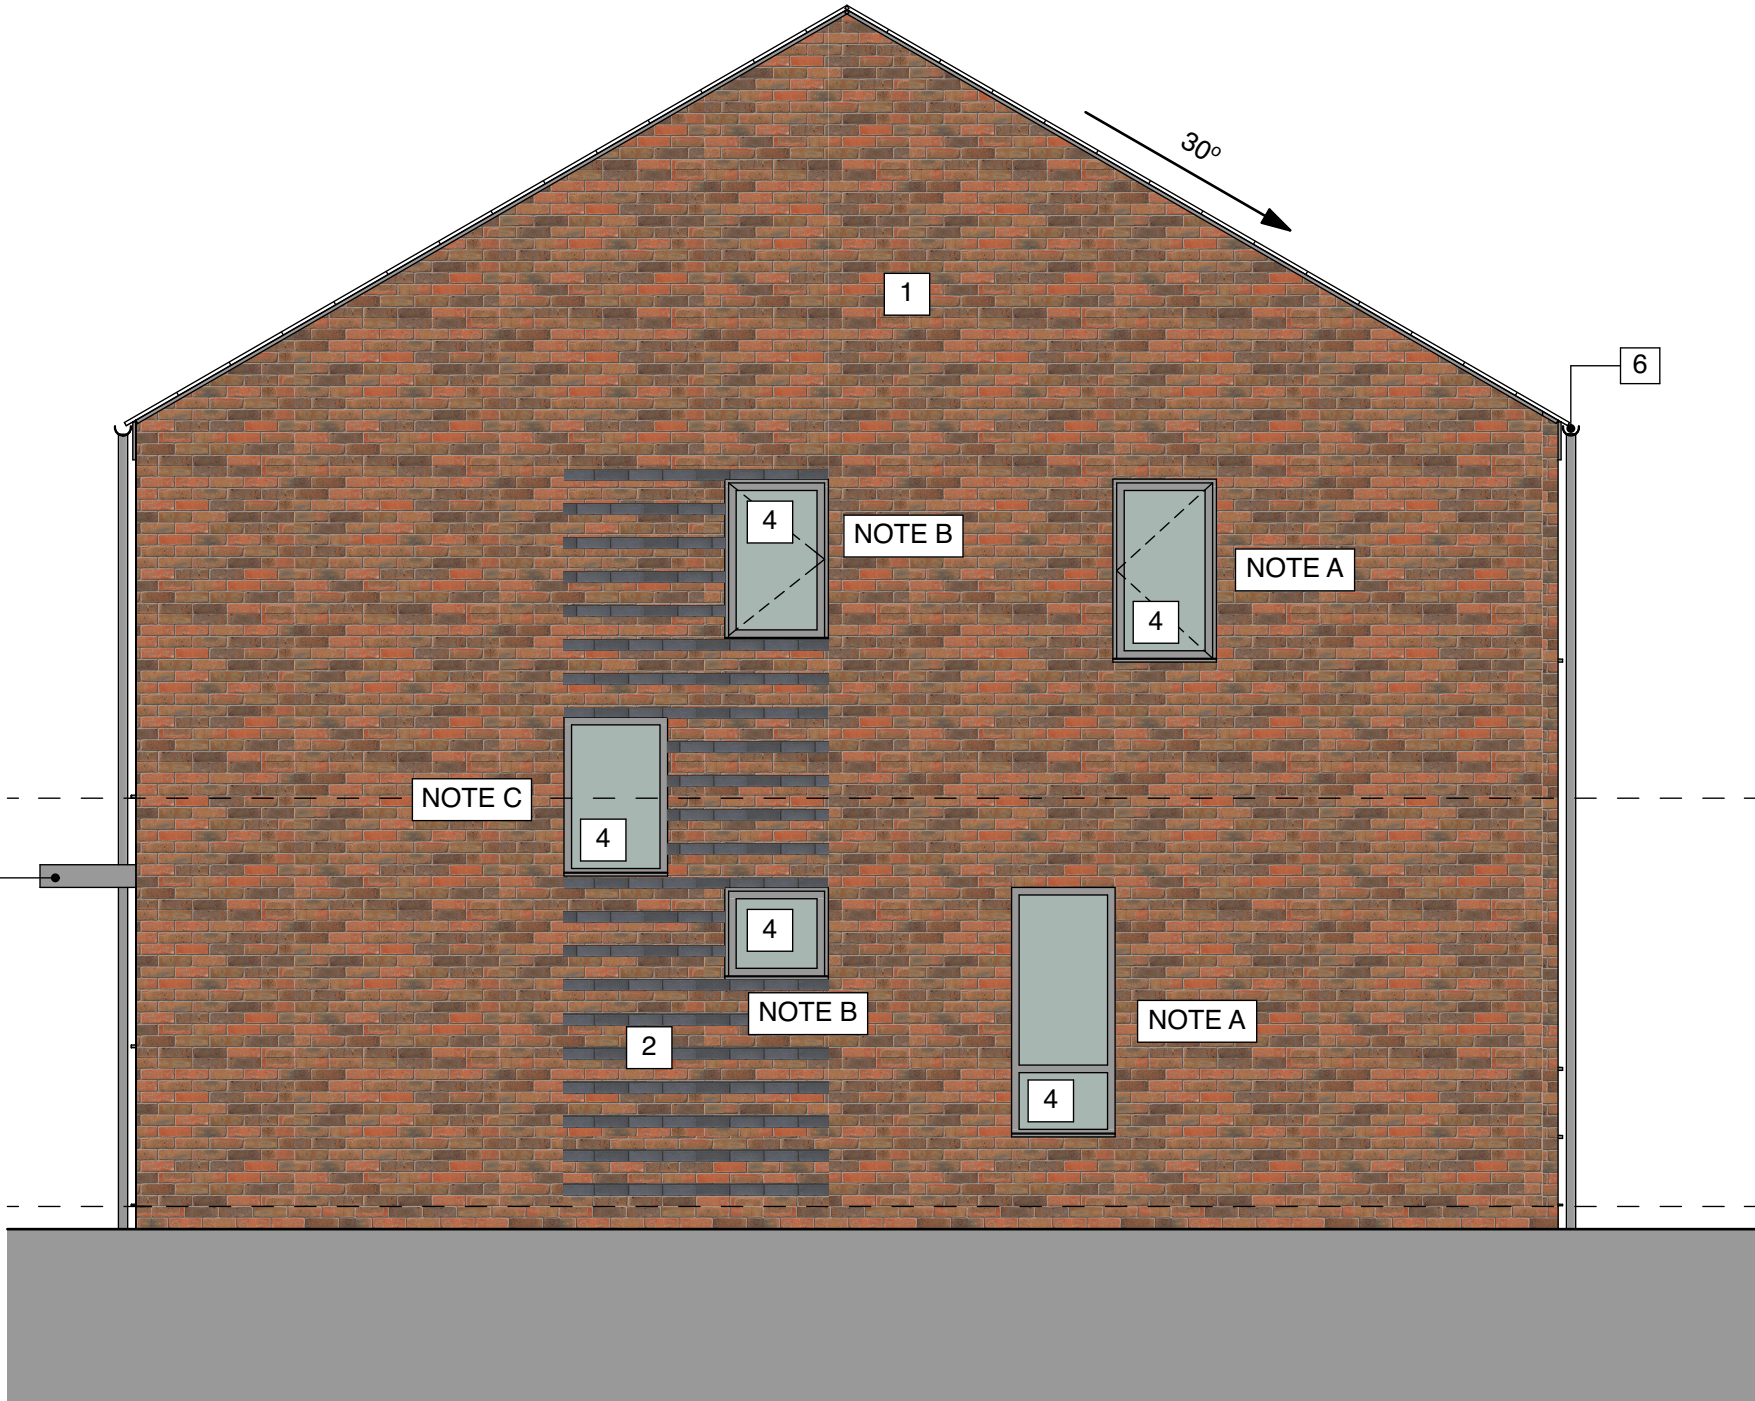

Right Elevation - Facade Treatment A

Plot Numbers
Plot 1 (Handed, Window note B&C)
Plot 2 (Window note B&C)
Plot 13 (Handed & Hipped Roof, Window note A, B&C)

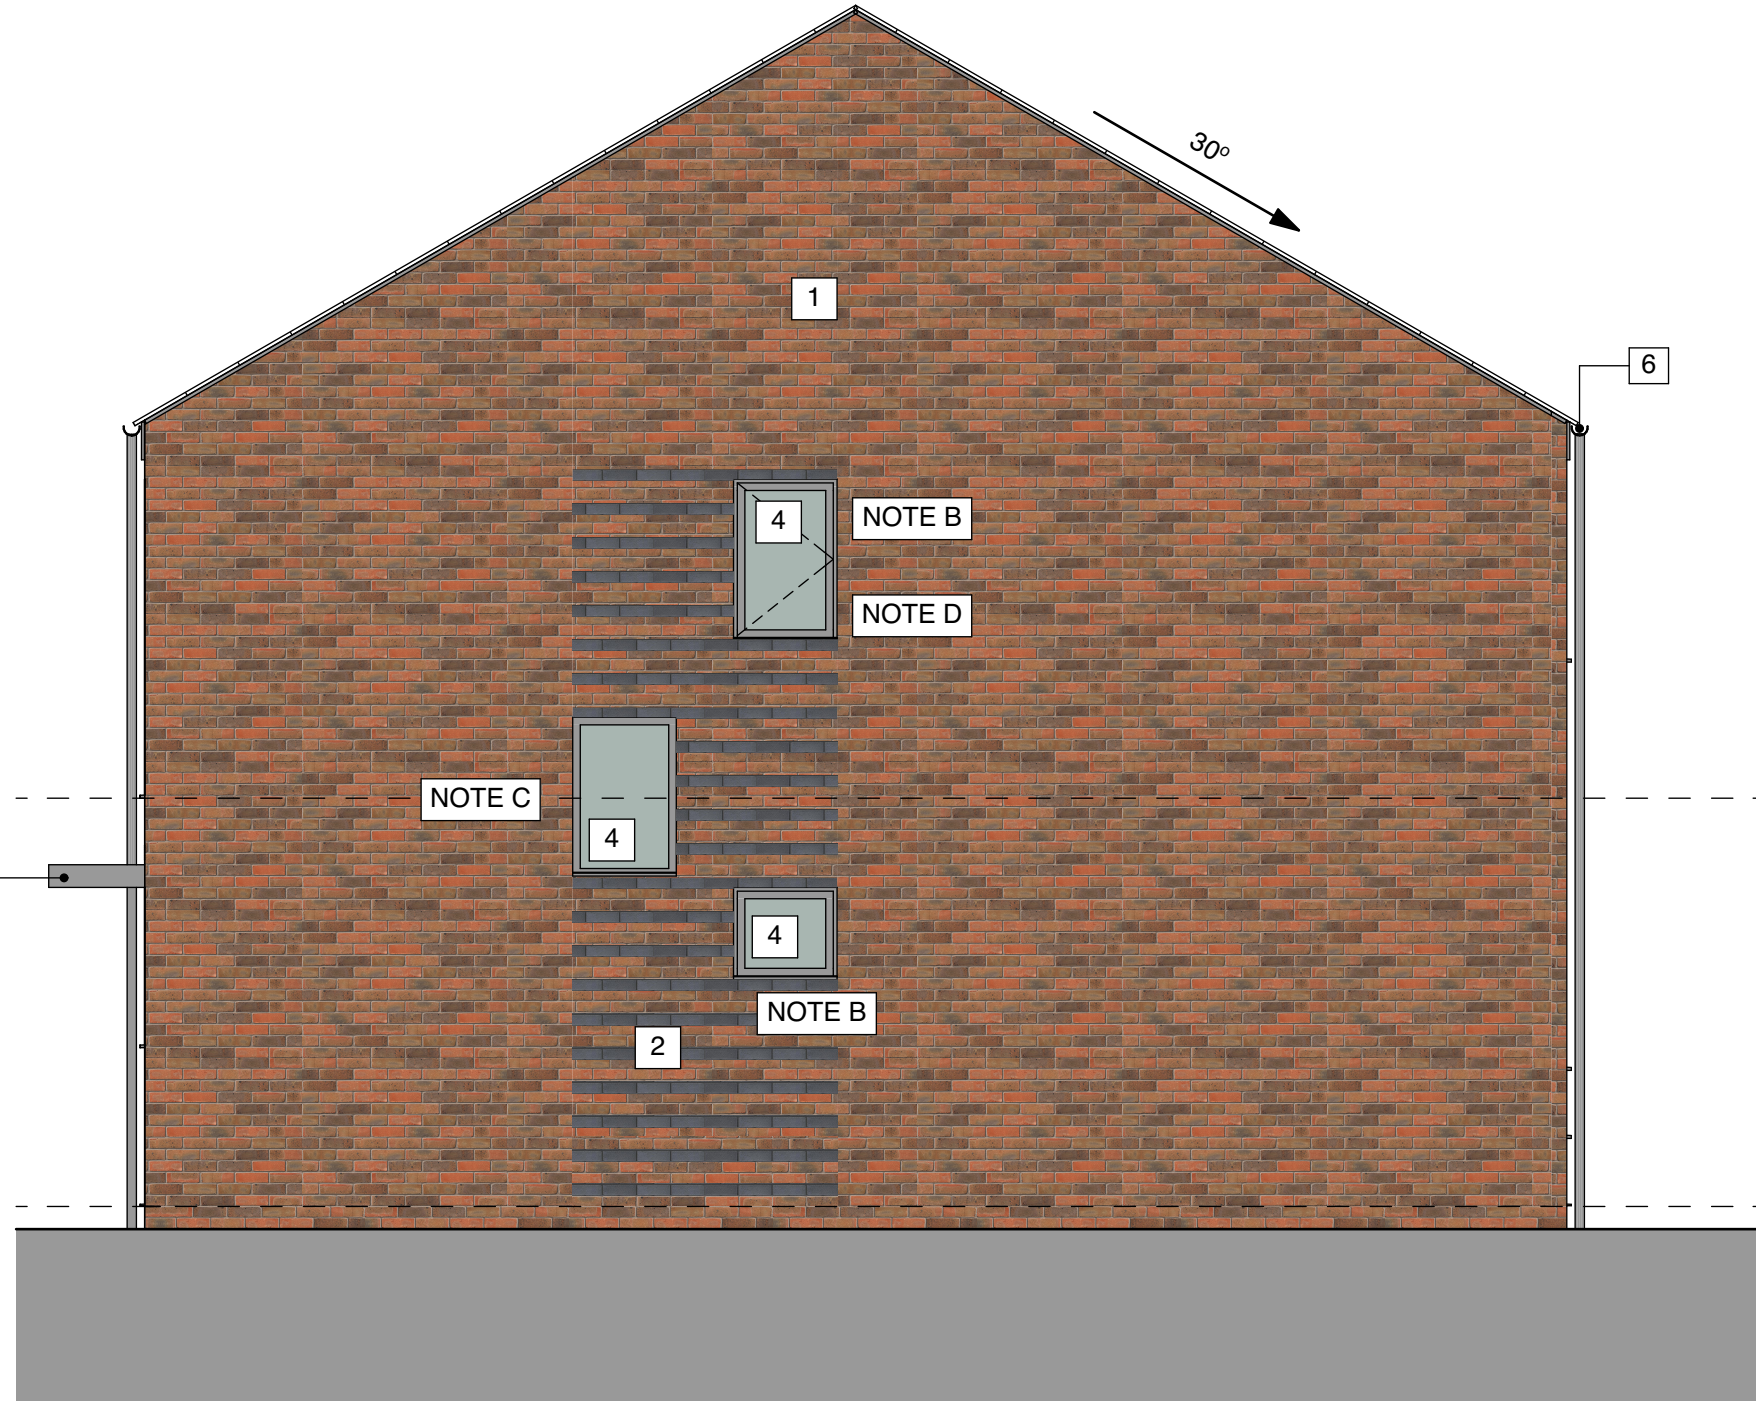

Right Elevation - Facade Treatment B

Plot Numbers
Plot 9 (Handed, no side windows)
Plot 10 (Window note D)
Plot 16 (Handed, Window note B&C)
Plot 17 (Window note B&C)

DO NOT SCALE FROM THIS DRAWING
ALL DIMENSIONS TO BE VERIFIED ON SITE
DRAWING TO BE SCALED FOR PLANNING AND
BUILDING REGULATIONS PURPOSES ONLY.

- MATERIALS KEY:
- Facing Brick - Red / Brown Multi
 - Projecting Blue Engineering Brick Feature Courses
 - ~~Cedral Weatherboarding (Refer to plot schedule)~~
~~Facade Treatment A - James Hardie Heathered Moss~~
~~Facade Treatment B - James Hardie Boothbay Blue~~
 - Grey UPVC windows & doors
 - Concrete Roof Tiles (Refer to plot schedule)
- Facade Treatment A. Redland Mini Stonewold Farmhouse Red
- Facade Treatment B. Redland Mini Stonewold Grey Slate
 - Grey UPVC fascia board and rainwater goods
 - Grey canopy
 - Metal faced composite door

- All bathrooms, WC's & front doors to have obscured glazing

House Type A - 4 Bed 7 Person				
GIA m²	Ground Floor	First Floor	Second Floor	Total
	58	58	-	116
Plot No.	Orientation	Facade Treatment		Type
01	Handed	Material A		Semi-Det
02	As Shown	Material A		Semi-Det
09	Handed	Material B		Mid Terrace
10	As Shown	Material B		End Terrace (R)
13	Handed	Material A		End Terrace (L)
16	Handed	Material B		Semi-Det
17	As Shown	Material B		Semi-Det
Windows				
NOTE A - Plot 13 ONLY				
NOTE B - All plots except Plot 9				
NOTE C - All plots except Plot 9 & Plot 10				
NOTE D - Reduced depth Window (610mm) to Plot 10 ONLY				

CH ID	Changes in this Revision:
Ch28	Note Added
Ch43	Hip added
Ch44	Front door style amended

Planning

EXBURY HOMES LTD

Fairview House
2A Osborne View Road
Hill Head
Fareham
PO14 3JN
T 01329 661840
F 01329 668140

Client
Guinness Developments Ltd,
30 Brock Street, Regents Place,
London, NW1 3FG

Project
Woodcroft Lane, Waterlooville

Title
House Type A Elevations

Scale	Date	Drawn	Checked
1:50 @ A1	Feb '20	AST	MW
Project No:	Drawing No.	Revision	
19-01	P-001	P2	

