

Notes

1.

The survey was carried out in December 2018.

2.

Grid and levels based OS national grid. Obtained through GPS observation.

3.

All values are displayed in metres.

Survey Key

BH

FLOOR TO BEAM HEIGHT

BL

UNDERSIDE OF BEAM LEVEL

C

CILL LEVEL

C-H

CILL TO HEAD HEIGHT

CL

COVER LEVEL

COL

COLUMN

CT

CEILING TYPE

DH

DOOR HEAD HEIGHT

F-C

FLOOR TO CILL HEIGHT

+FL

FLOOR LEVEL

FT

FLOOR TYPE

GV

GAS VALVE

GY

GULLY

H

HEAD LEVEL

MH

MANHOLE COVER

RAD

RADIATOR

RS

ROLLER SHUTTER

RWP

RAIN WATER PIPE

S/C

SLOPED CEILING

SCL

SLOPED CEILING LEVEL

+SF

SOFFIT LEVEL

SP

SIGN POST

SV

STOP VALVE

TP

TACTILE PAVING

T/R

TOWEL RAIL

TW

TOP OF WALL LEVEL

2.30

2.30

CEILING HEIGHT

2.30

2.30

FALSE CEILING HEIGHT

2.30

2.30

SLIDING DOOR

ISSUE/ REVISION

|  |  |  |  |  |  |
|--|--|--|--|--|--|
|  |  |  |  |  |  |
|  |  |  |  |  |  |
Rev

Date

Status/ Amendment

Drawn

Checked

Scale Bar

1:200 0

2m

4m

6m

8m

10m

12m

14m

16m

18m

20m

1:100 0

1m

2m

3m

4m

5m

6m

7m

8m

9m

10m

1:50 0

1m

2m

3m

4m

5m

6m

7m

8m

9m

10m

1:500 0

10m

20m

30m

40m

50m

For reference only. Do not scale off this drawing

BES

GEOMATICS

T: 01525 300721 E: info@besgeo.co.uk W: www.besgeo.co.uk

Client:

Project: The Manor House, Bedhampton.

Title: Ground Floor Plan

Sheet Number:

Status: Draft

Checked: BS

Drawn: CE


Date: 23/01/2019

Scale: 1:50 @ A1

Project No: BES18190 Drg No: 2 Rev: B

TOPOGRAPHICAL SURVEYS GPS MEASURED BUILDING SURVEYS

3D LASER SCANNING AS-BUILT SURVEYS AREA MEASUREMENTS

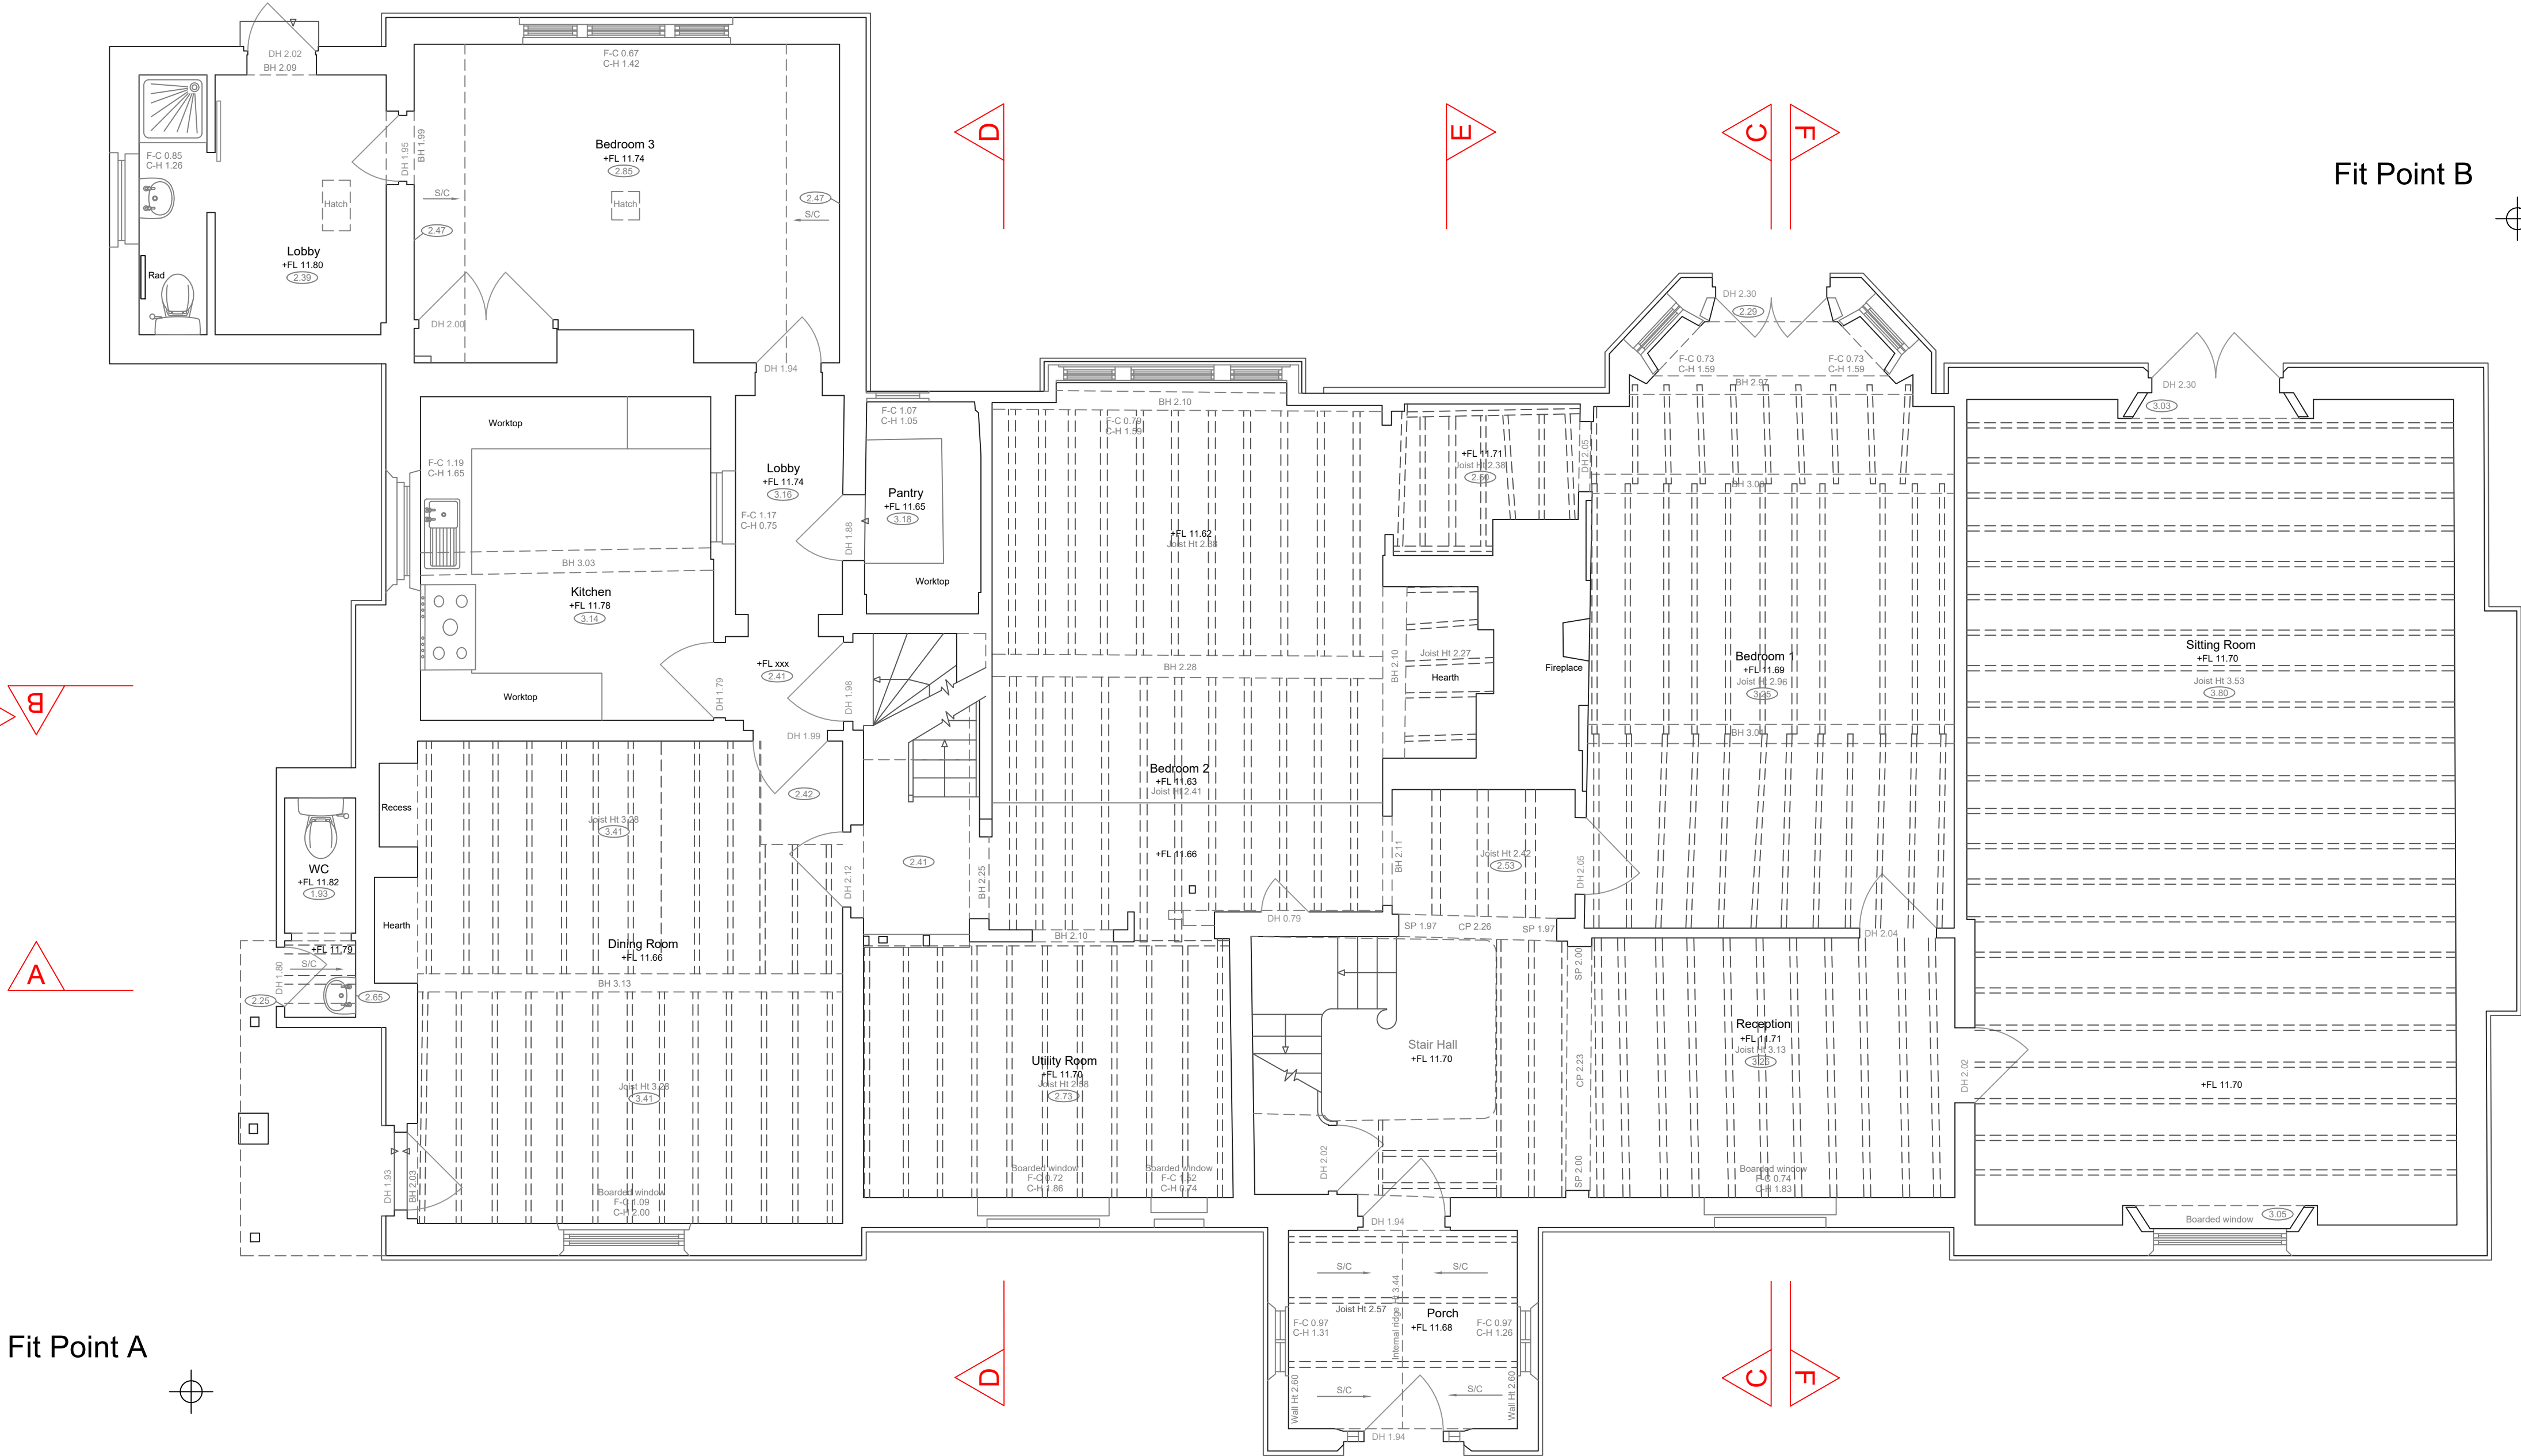

Ground Floor Plan