




Datum 11.00

Elevation 3

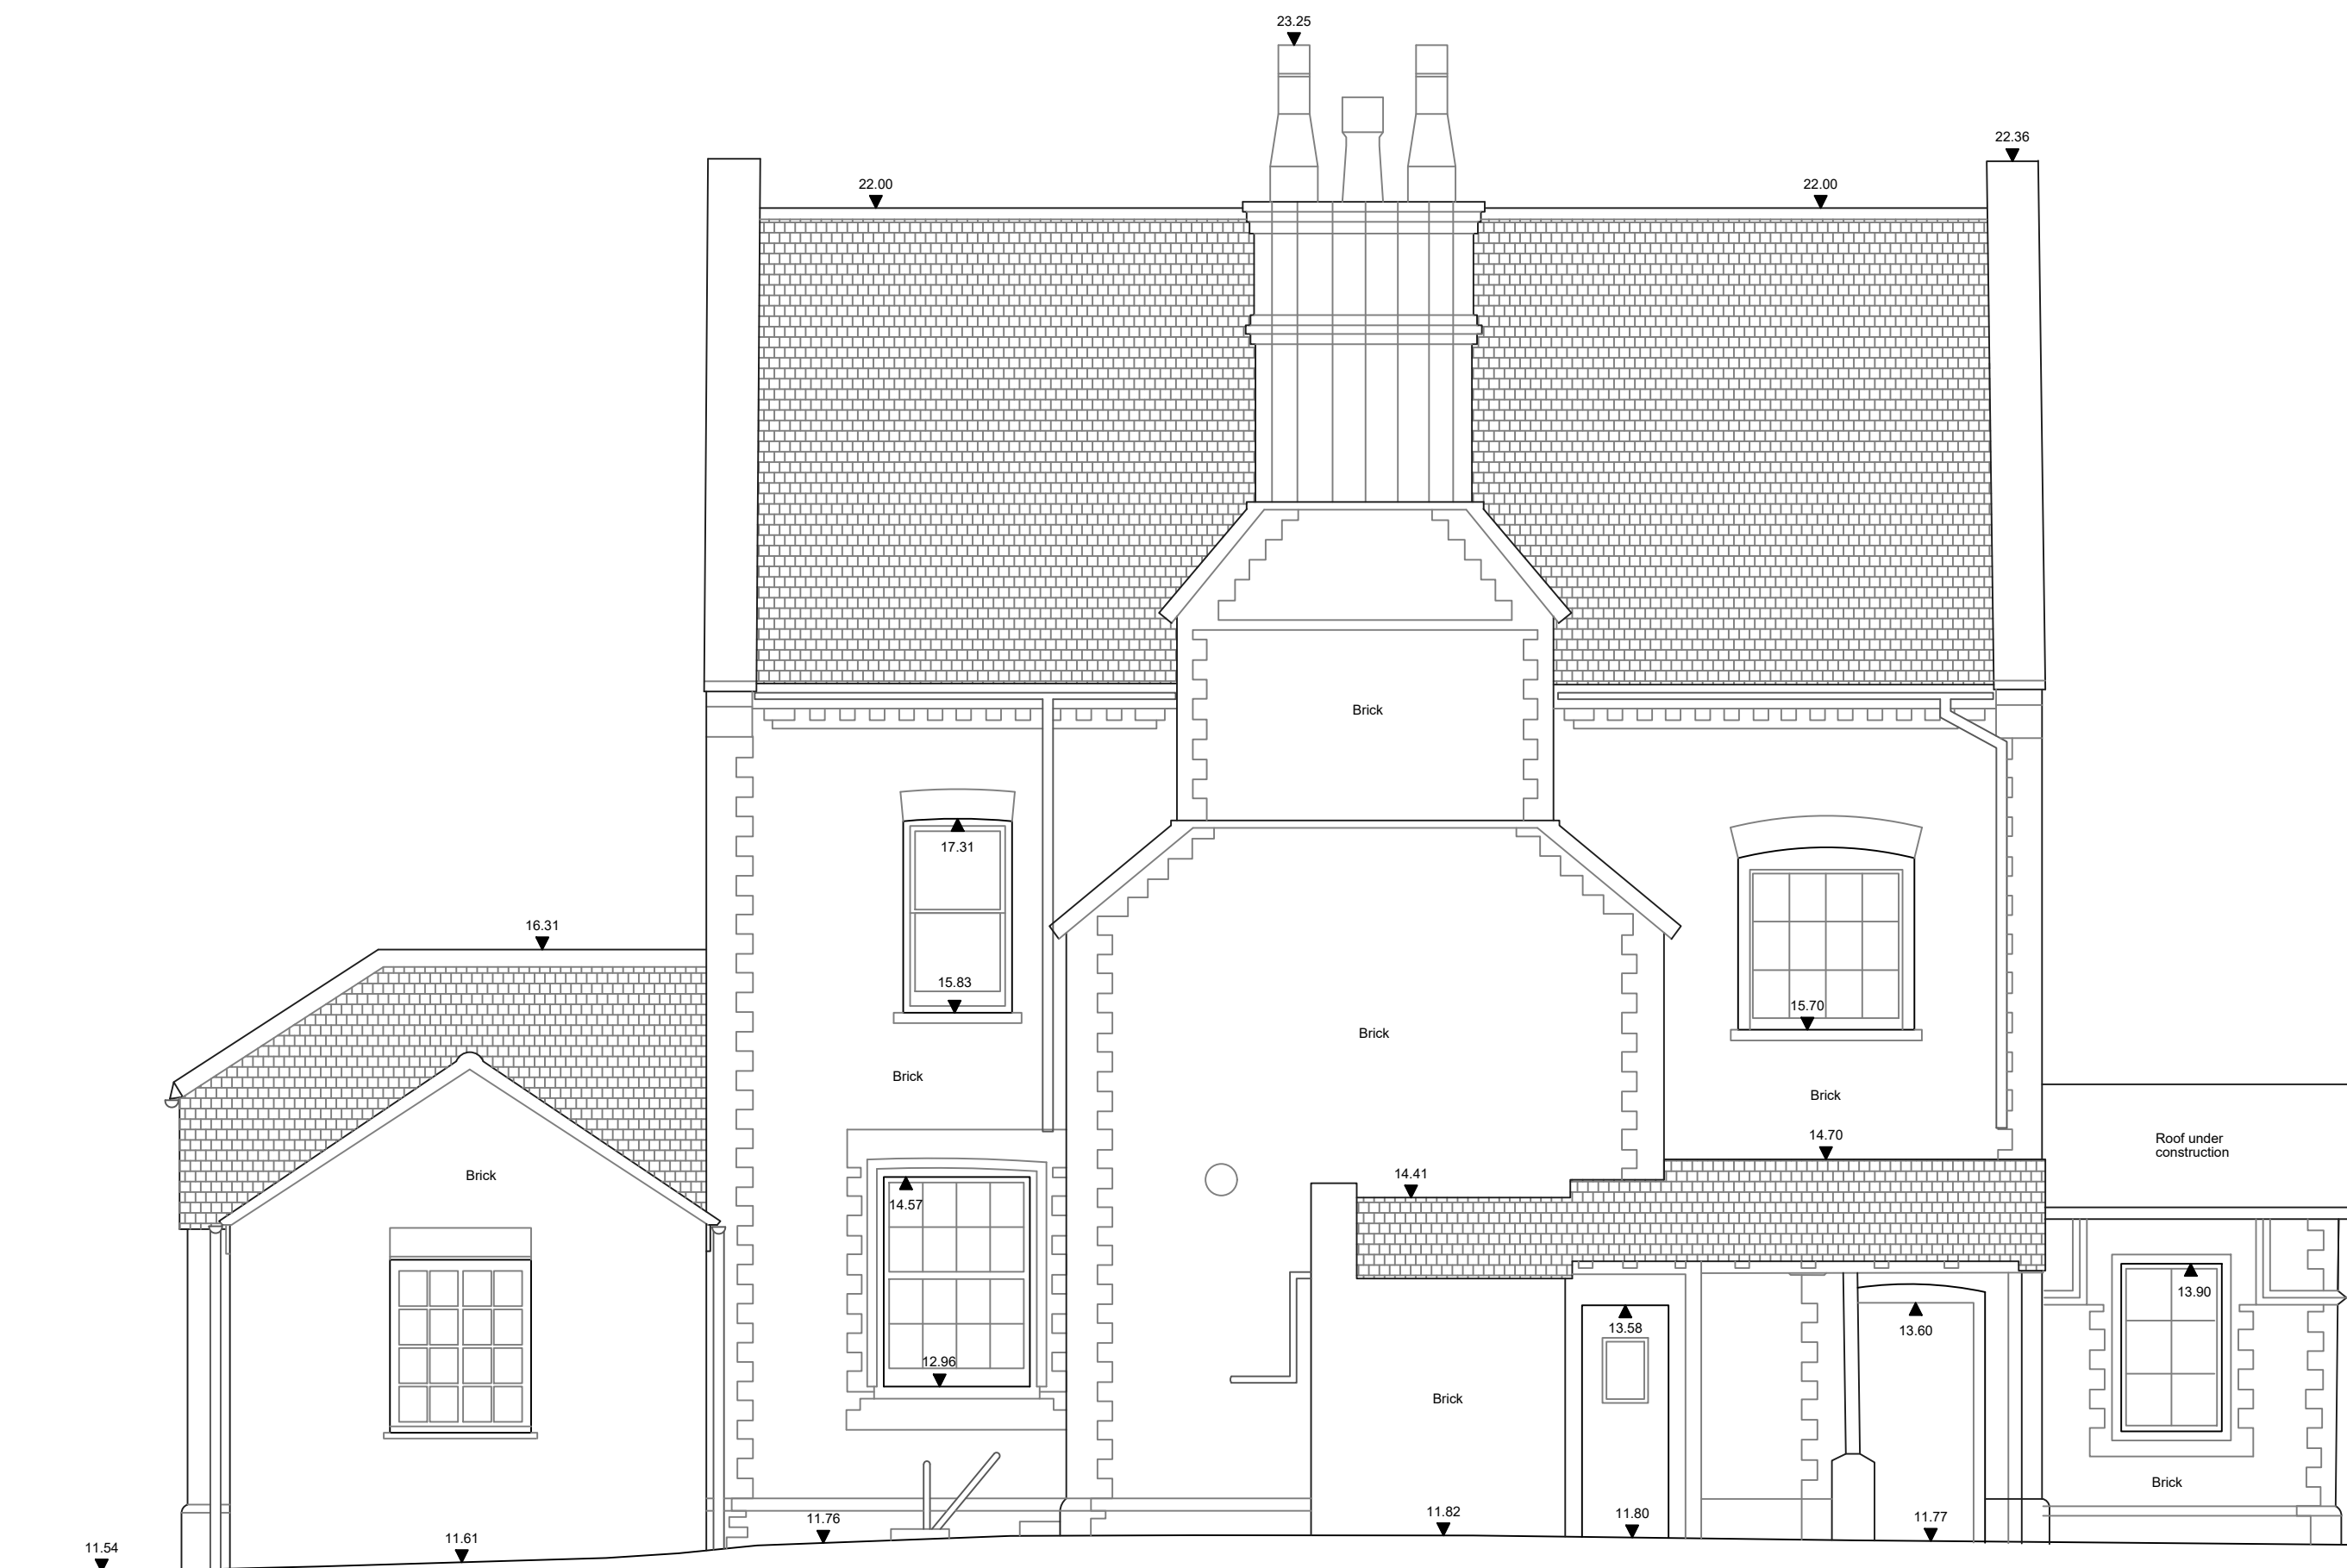

Datum 11.00

Elevation 4

Notes

1. The survey was carried out in December 2018.
2. Grid and levels based OS national grid. Obtained through GPS observation.
3. All values are displayed in metres.


Survey Key

BH	FLOOR TO BEAM HEIGHT
BL	UNDERSIDE OF BEAM LEVEL
C	CILL LEVEL
C-H	CILL TO HEAD HEIGHT
CL	COVER LEVEL
COL	COLUMN
CT	CEILING TYPE
DH	DOOR HEAD HEIGHT
F-C	FLOOR TO CILL HEIGHT
+FL	FLOOR LEVEL
FT	FLOOR TYPE
GV	GAS VALVE
GY	GULLY
H	HEAD LEVEL
MH	MANHOLE COVER
RAD	RADIATOR
RS	ROLLER SHUTTER
RWP	RAIN WATER PIPE
S/C	SLOPED CEILING
SCL	SLOPED CEILING LEVEL
+SF	SOFFIT LEVEL
SP	SIGN POST
SV	STOP VALVE
TP	TACTILE PAVING
T/R	TOWEL RAIL
TW	TOP OF WALL LEVEL
2.30	CEILING HEIGHT
2.30	FALSE CEILING HEIGHT
	SLIDING DOOR

ISSUE/ REVISION

Rev	Date	Status/ Amendment	Drawn	Checked
-----	------	-------------------	-------	---------

Scale Bar

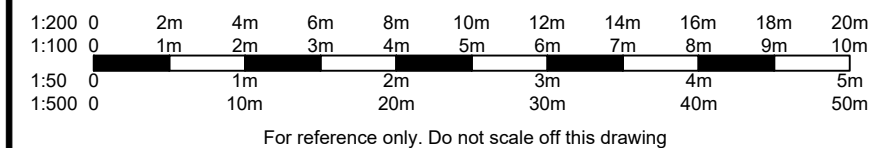

T: 01525 300721 E: info@besgeo.co.uk W: www.besgeo.co.uk

Client:

Project: **The Manor House, Bedhampton.**

Title: **Elevations 1 & 2**

Sheet Number:

Status: **Draft**

Checked: **BS**

Drawn: **CE**

Date: **23/01/2019**

Scale: **1:50 @ A1**

Project No: **BES18190** Drg No: **5** Rev: **B**

TOPOGRAPHICAL SURVEYS GPS MEASURED BUILDING SURVEYS
3D LASER SCANNING AS-BUILT SURVEYS AREA MEASUREMENTS