

Notes


- The survey was carried out in December 2018.
- Grid and levels based OS national grid. Obtained through GPS observation.
- All values are displayed in metres.

Survey Key

- BH FLOOR TO BEAM HEIGHT
BL UNDERSIDE OF BEAM LEVEL
C CILL LEVEL
C-H CILL TO HEAD HEIGHT
CL COVER LEVEL
COL COLUMN
CT CEILING TYPE
DH DOOR HEAD HEIGHT
F-C FLOOR TO CILL HEIGHT
+FL FLOOR LEVEL
FT FLOOR TYPE
GV GAS VALVE
GY GULLY
H HEAD LEVEL
MH MANHOLE COVER
RAD RADIATOR
RS ROLLER SHUTTER
RWP RAIN WATER PIPE
S/C SLOPED CEILING
SCL SLOPED CEILING LEVEL
+SF SOFFIT LEVEL
SP SIGN POST
SV STOP VALVE
TP TACTILE PAVING
T/R TOWEL RAIL
TW TOP OF WALL LEVEL
2.30 CEILING HEIGHT
2.30 FALSE CEILING HEIGHT
SLIDING DOOR

ISSUE/ REVISION

Rev	Date	Status/ Amendment	Drawn	Checked

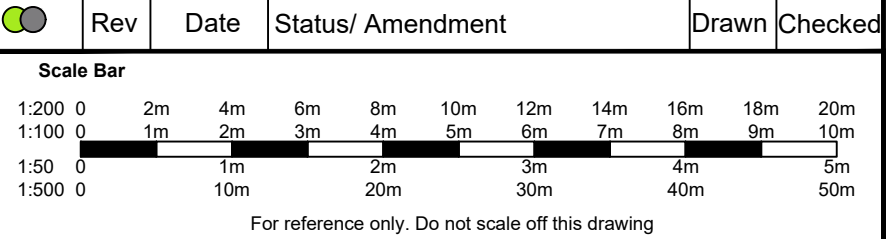

T: 01525 300721 E: info@besgeo.co.uk W: www.besgeo.co.uk

Client:

Project: **The Manor House, Bedhampton.**

Title: **Section A - A & B - B**

Sheet Number:

Status: **Draft**

Checked: **BS**


Drawn: **CE**

Date: **23/01/2019**


Scale: **1:50 @ A1**

Project No: **BES18190** Drg No: **6** Rev: **B**

TOPOGRAPHICAL SURVEYS GPS MEASURED BUILDING SURVEYS
3D LASER SCANNING AS-BUILT SURVEYS AREA MEASUREMENTS

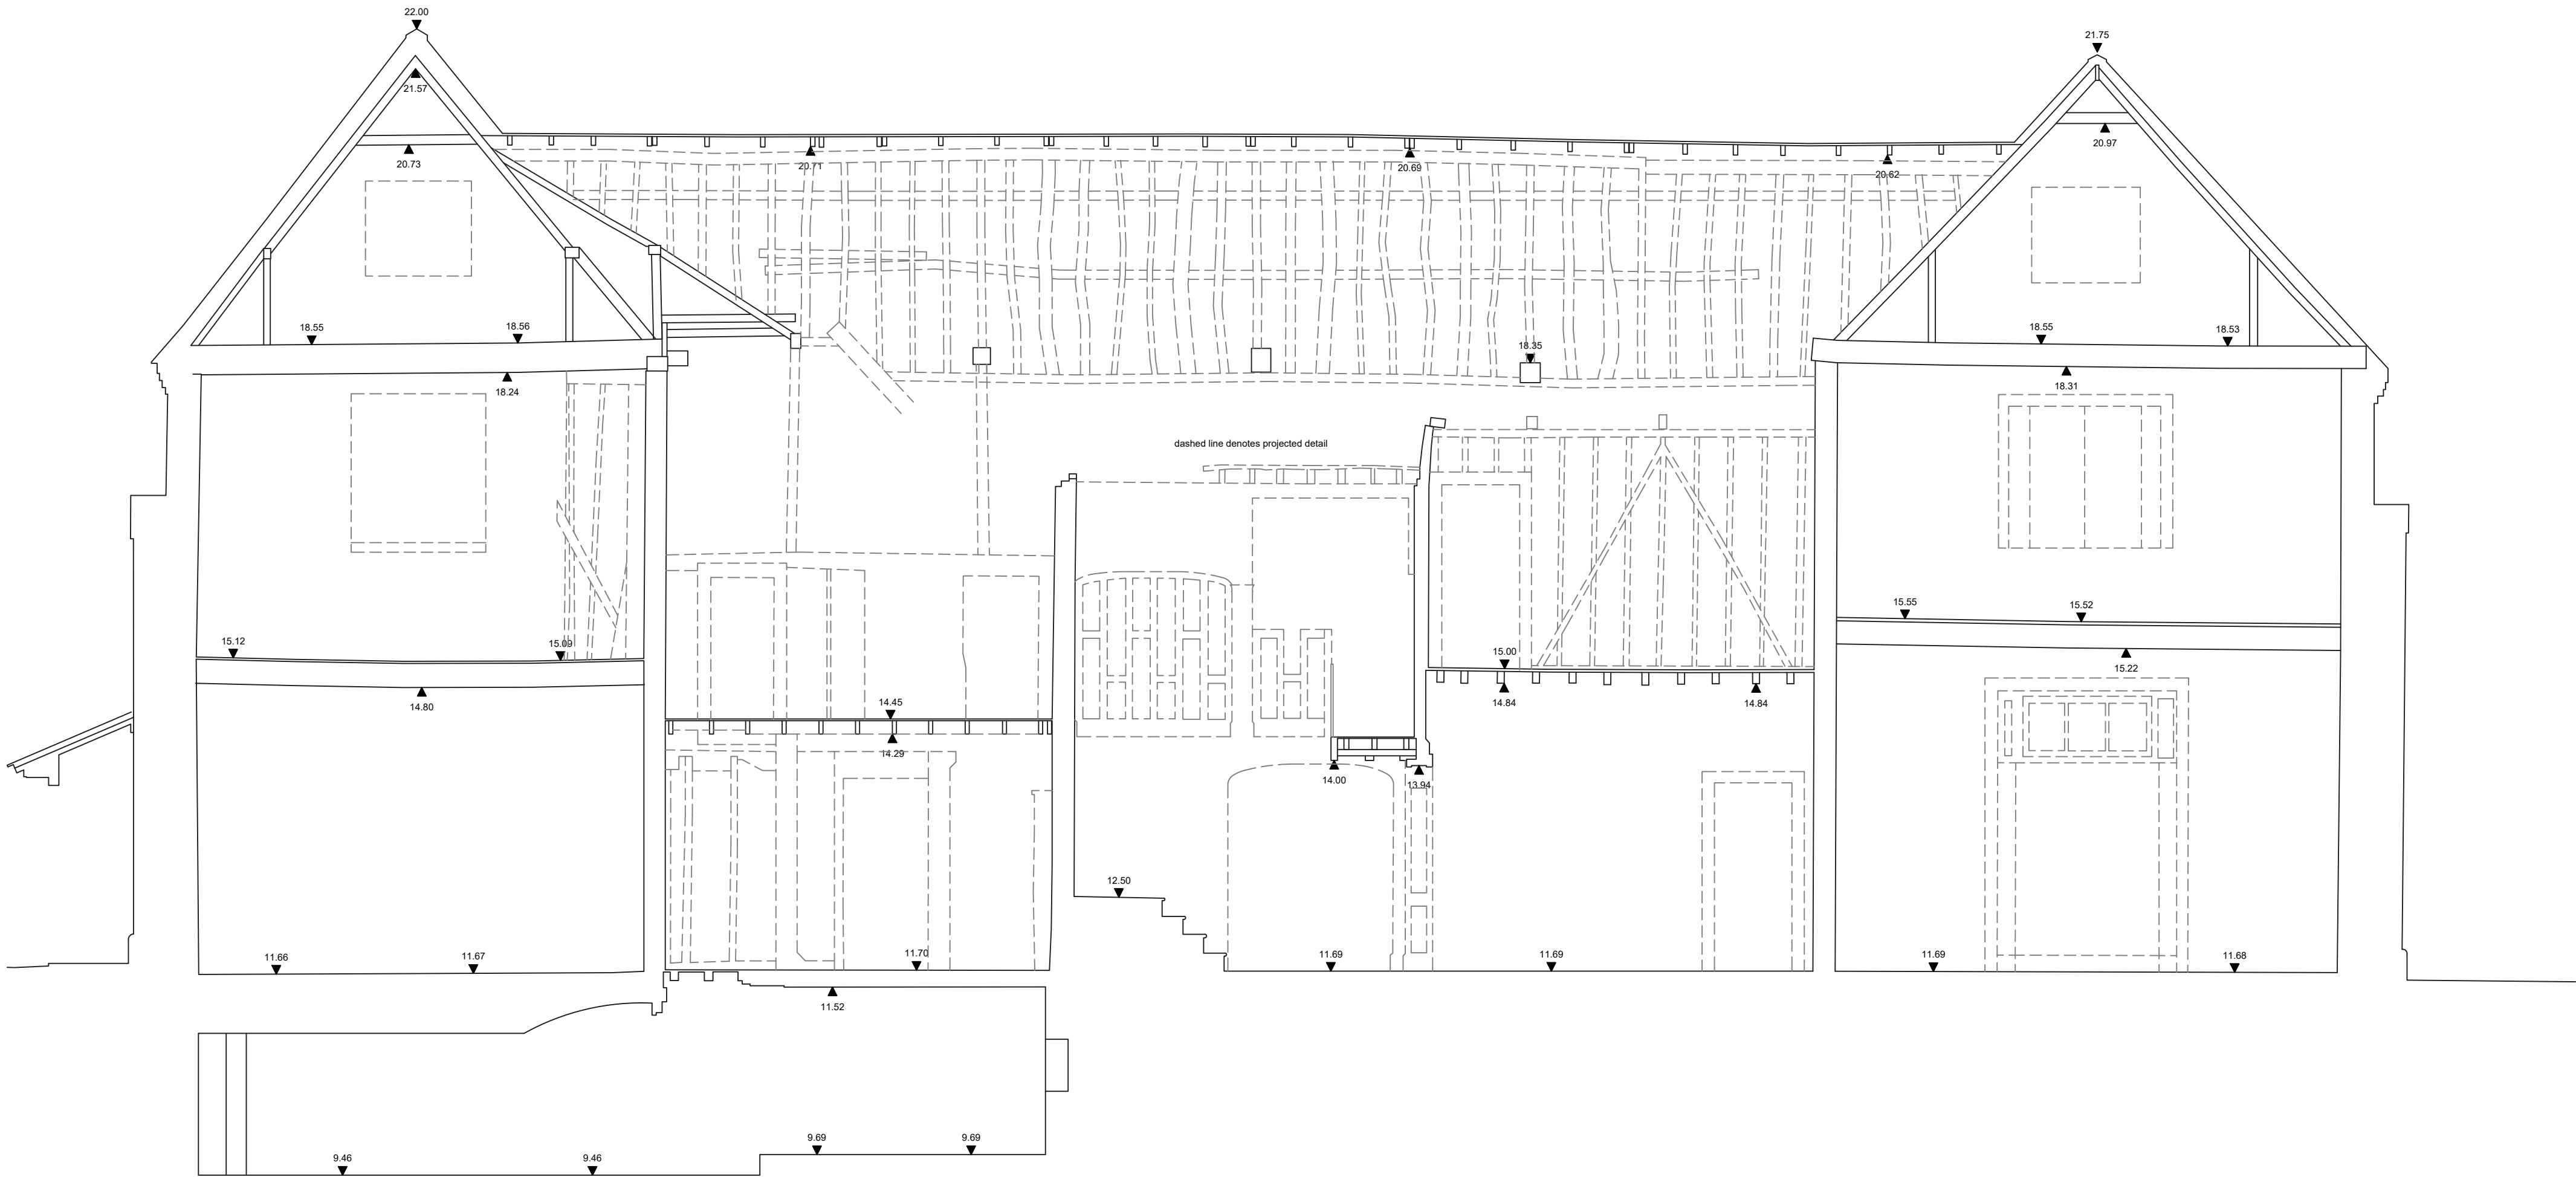

Section A-A

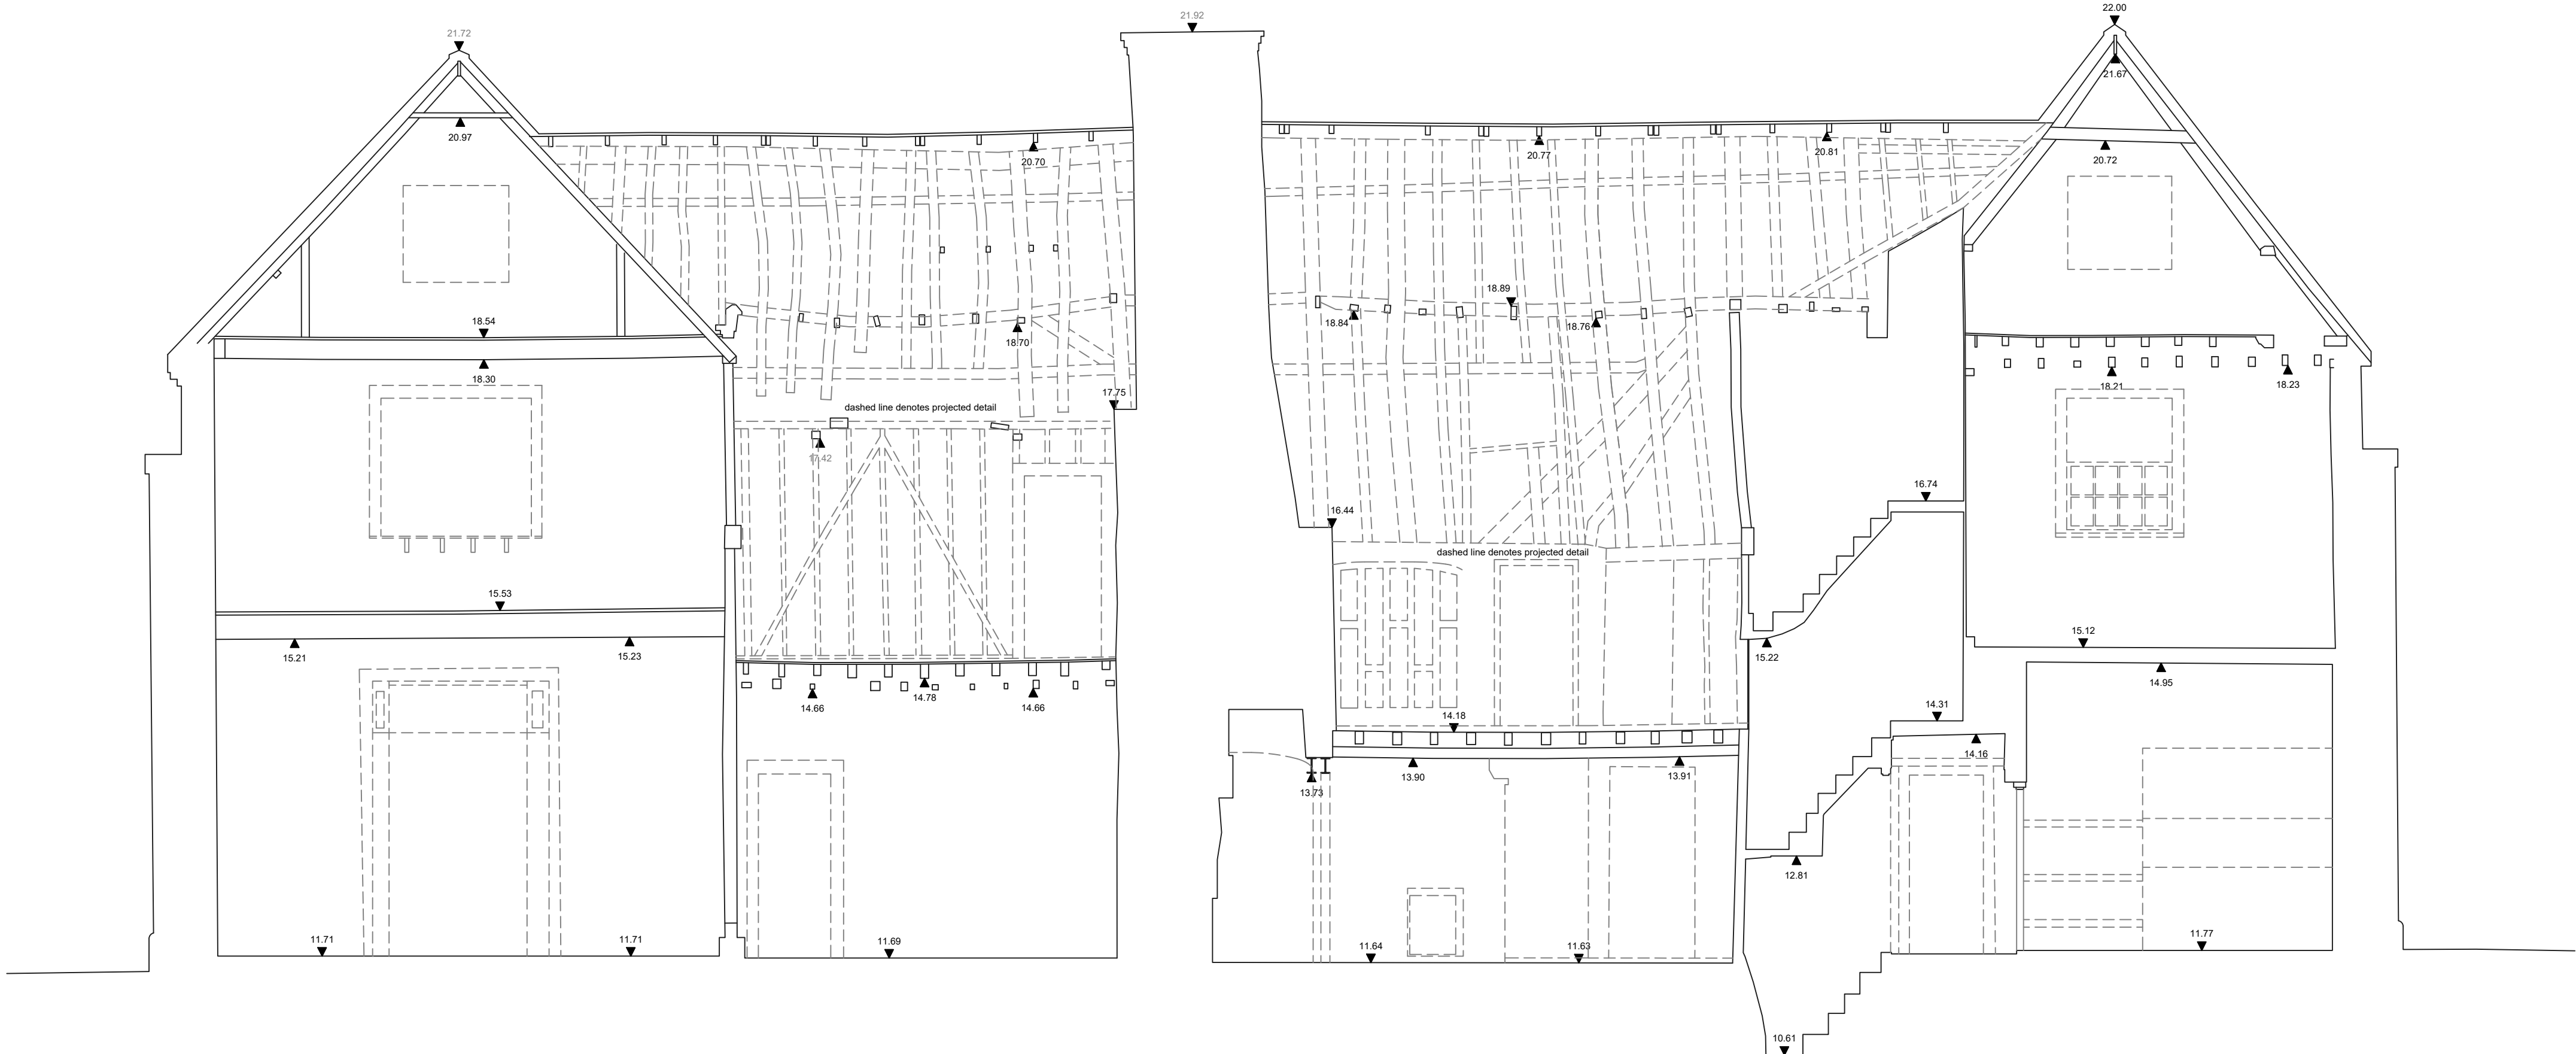

Section B-B

Datum 9.00

Datum 9.00