

MARK UP BY THE
GREEN OAK CARPENTRY CO LTD.

Notes


1. The survey was carried out in December 2018.
2. Grid and levels based OS national grid. Obtained through GPS observation.
3. All values are displayed in metres.

Survey Key

BH	FLOOR TO BEAM HEIGHT
BL	UNDERSIDE OF BEAM LEVEL
C	CILL LEVEL
CH	CILL TO HEAD HEIGHT
CL	COVER LEVEL
COL	COLUMN
CT	CEILING TYPE
DH	DOOR HEAD HEIGHT
F-C	FLOOR TO CILL HEIGHT
FL	FLOOR LEVEL
FT	FLOOR TYPE
GV	GAS VALVE
GY	GULLY
H	HEAD LEVEL
HC	HEAD COVER
RAD	RADIATOR
RS	ROLLER SHUTTER
RVP	RAIN WATER PIPE
S/C	SLOPED CEILING
SCL	SLOPED CEILING LEVEL
SF	SCOFF LEVEL
SP	SKIN POST
SV	STOP VALVE
TP	TACTILE PAVING
T/R	TOWEL RAIL
TV	TOP OF WALL LEVEL
CH	CEILING HEIGHT
CH	FALSE CEILING HEIGHT
CH	SLIDING DOOR

ISSUE/ REVISION

Rev	Date	Status/ Amendment	Drawn/Checked

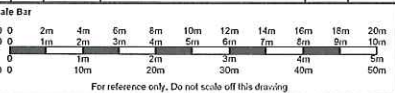

T: 01525 300721 E: info@besgeo.co.uk W: www.besgeo.co.uk

Client:

Project: The Manor House,
Bedhampton.

Title: Ground Floor Plan

Sheet Number:

Status: Draft


Checked: BS

Drawn: CE

Date: 23/01/2019 Scale: 1:50 @ A1

Project No: BES18190 Drg No: 2 Rev: B

TOPOGRAPHICAL SURVEYS GPS MEASURED BUILDING SURVEYS
3D LASER SCANNING AS-BUILT SURVEYS AREA MEASUREMENTS

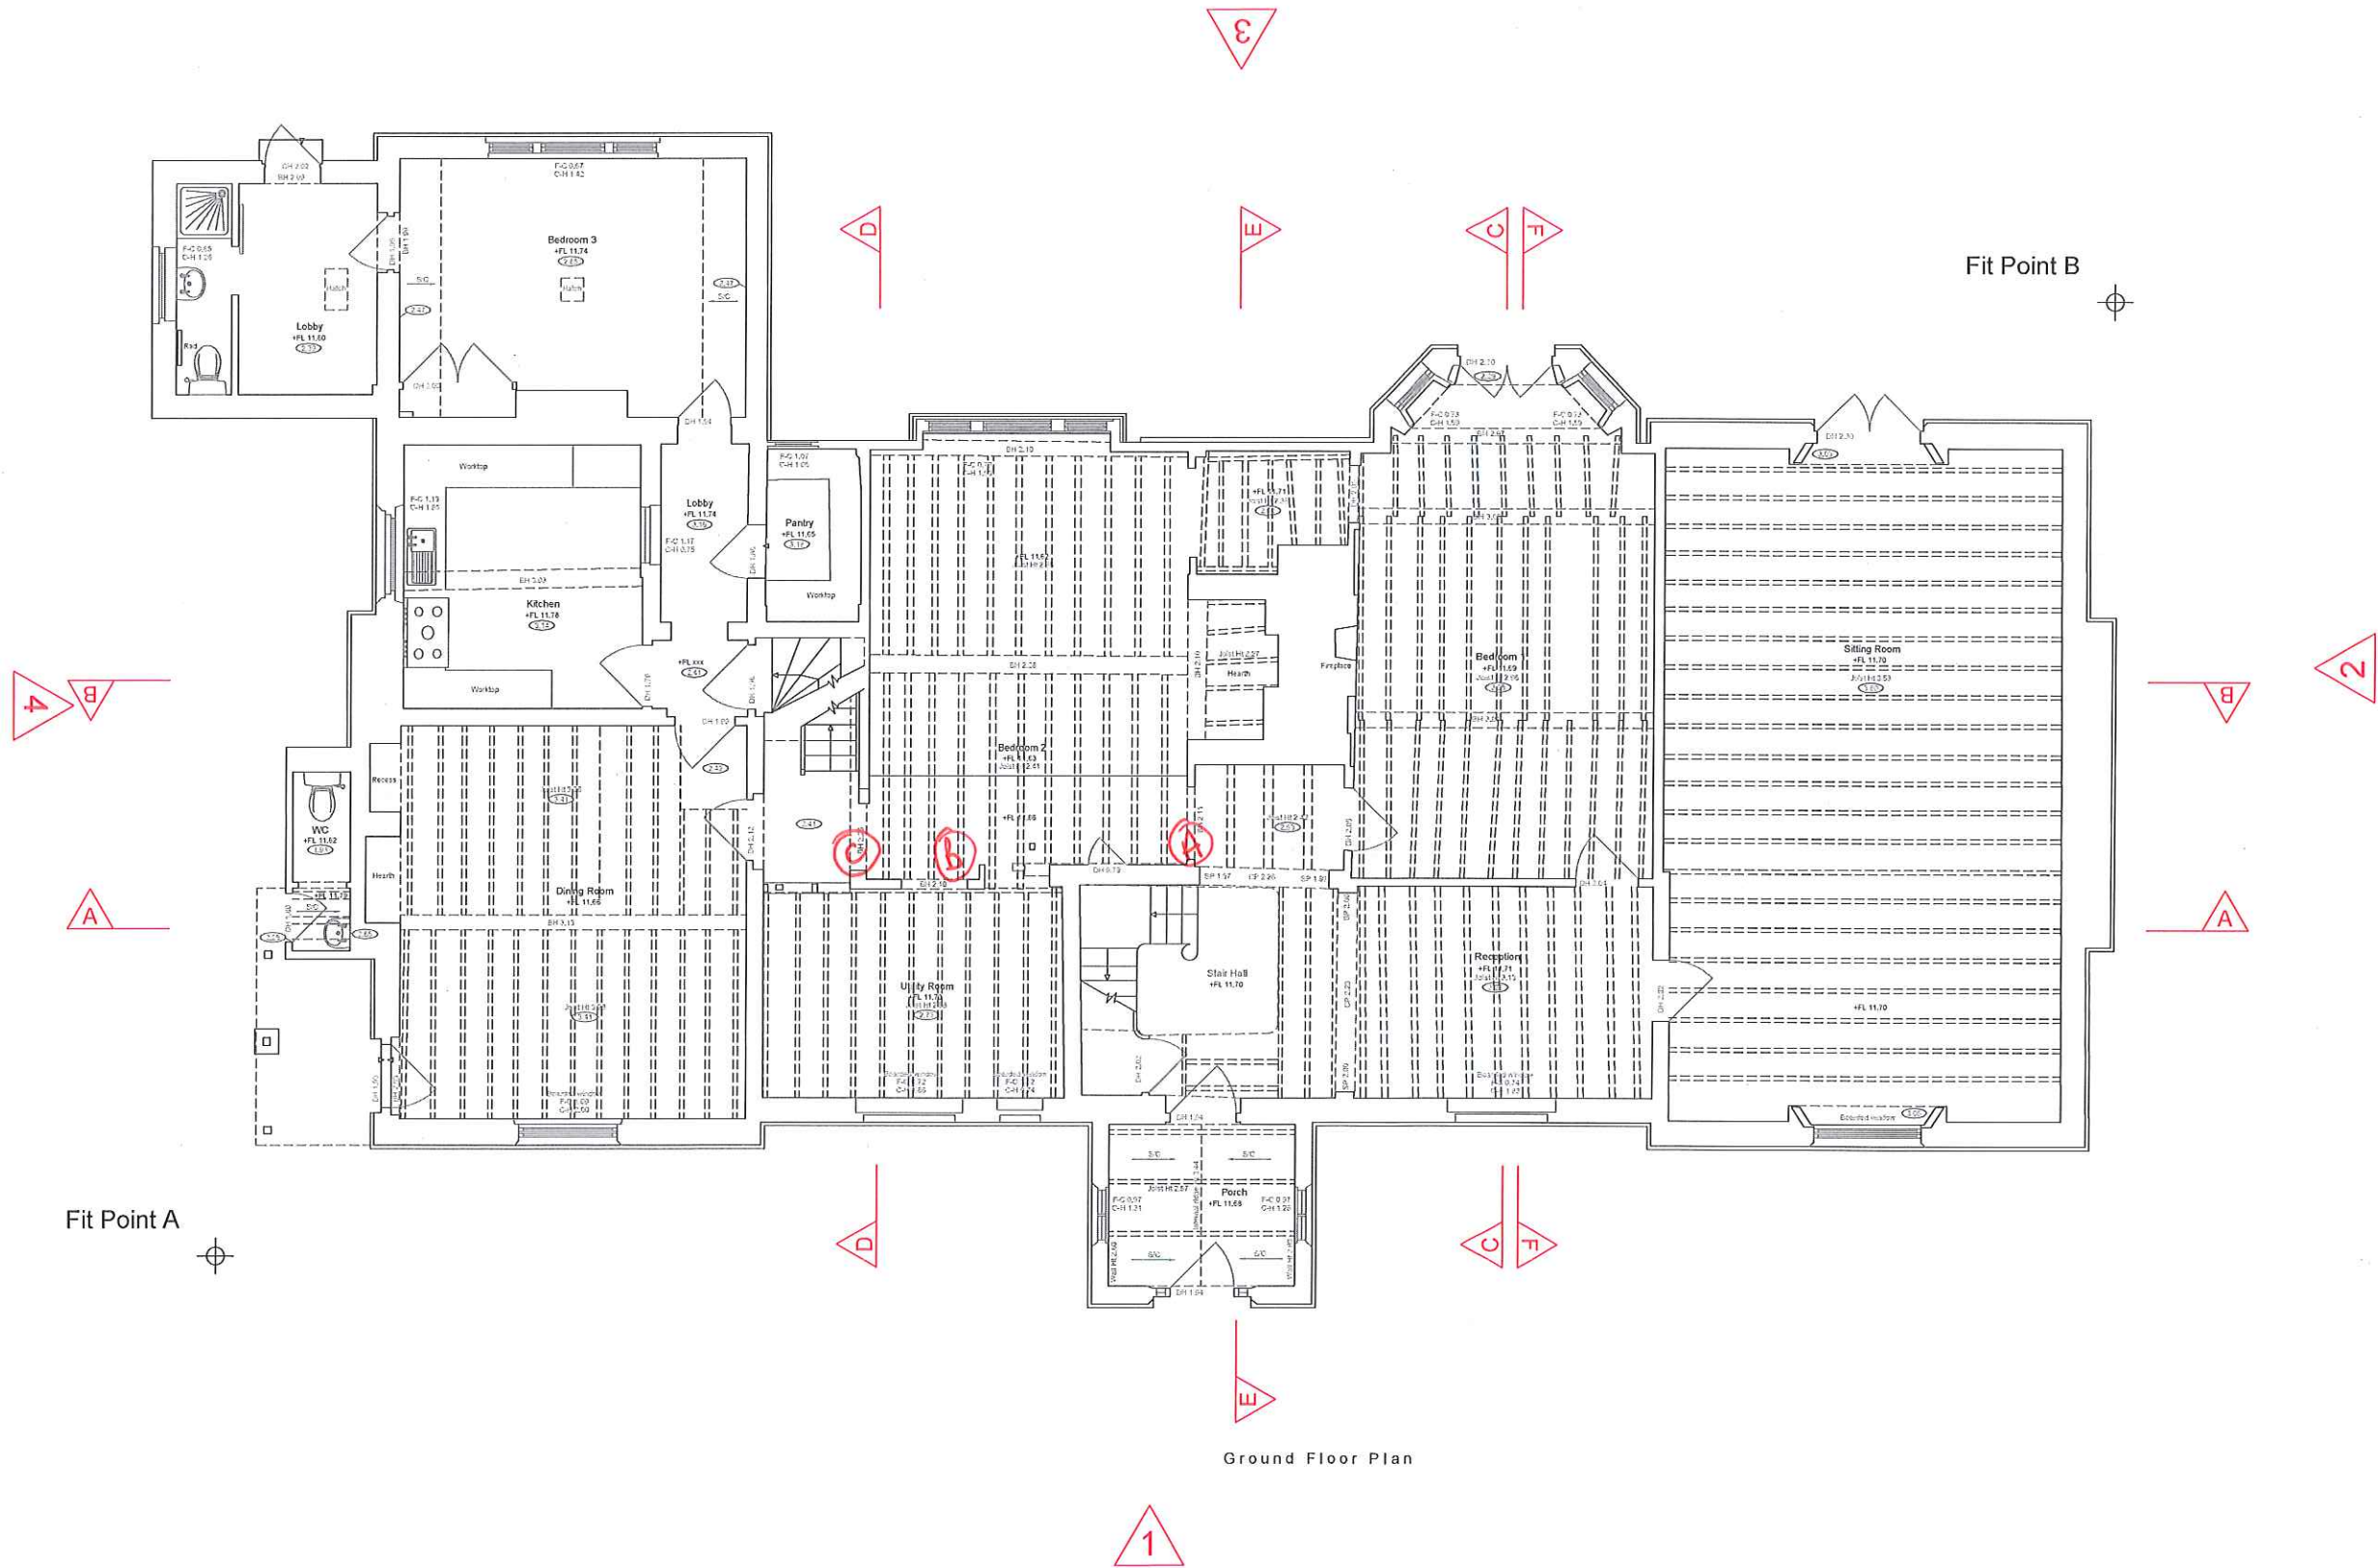

Fit Point A

Fit Point B

Ground Floor Plan

