


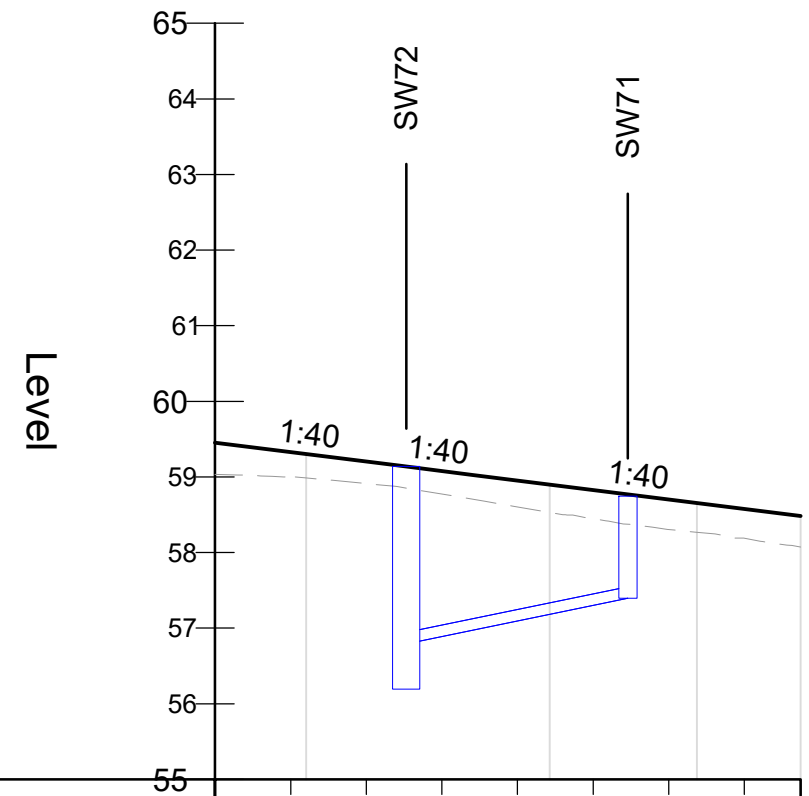

CHAINAGE	00.000	05.000	10.000	15.000	20.000	25.000	30.000	35.000	38.721
EXISTING LEVELS	59.033	58.913	58.774	58.601	58.446	58.306	58.168	58.074	
PROPOSED LEVELS	59.450	59.326	59.202	59.078	58.953	58.828	58.703	58.578	58.485
LEVEL DIFFERENCE	0.417	0.289	0.304	0.352	0.382	0.397	0.390	0.411	
VERTICAL GEOMETRY	G=1:40 L=12.268 G=1:40 L=4.800 G=1:40 L=21.664								
HORIZONTAL GEOMETRY	R: 8.511 L: 6.023 L=16.111 R: 12.400 L: 9.759 L=6.848								
FOUL WATER COVER LEVEL									
FOULWATER INVERT LEVEL									
FOULWATER DETAILS									
FOULWATER LENGTHS									
STORMWATER COVER LEVEL			CL: 59.140				CL: 58.747		
STORMWATER INVERT LEVEL			IL: 56.792			IL: 57.597			
STORMWATER DETAILS			PIPE 10.000 DIA 150 @ 1:25 CIRC CLAY BEDDING CLASS S						
STORMWATER LENGTHS			14.90						

1BRD14
SCALE: H 1:500,V 1:100. DATUM: 55.000

- NOTES
- THIS DRAWING IS TO BE READ IN CONJUNCTION WITH "SEWERS FOR ADOPTION 7th EDITION - A DESIGN AND CONSTRUCTION GUIDE FOR DEVELOPERS" PLUS ALL OTHER RELATED DOCUMENTS ISSUED BY THE ENGINEER.
 - IF THERE IS ANY AMBIGUITY BETWEEN THE DRAWINGS, THE CONTRACTOR SHALL IMMEDIATELY INFORM THE ENGINEER.
 - DO NOT SCALE FROM THIS DRAWING. WORK FROM FIGURED DIMENSIONS ONLY.
 - ALL DIMENSIONS SHOWN ON THIS DRAWING ARE IN METRES.
 - ALL DIMENSIONS, LEVELS AND SURVEY GRID CO-ORDINATES ARE TO BE CHECKED ON SITE AND THE ENGINEER NOTIFIED IMMEDIATELY OF ANY DISCREPANCIES PRIOR TO THE COMMENCEMENT OF THE WORKS.
 - NO DEVIATION FROM THE DETAILS SHOWN ON THIS DRAWING IS PERMITTED WITHOUT PERMISSION FROM THE ENGINEER.
 - CONTRACTOR TO ENSURE SMOOTH TRANSITION IN FINISHED SURFACE LEVELS BETWEEN EXISTING AND PROPOSED LEVELS.
 - FOR ADAPTABLE DRAINAGE CONSTRUCTION DETAILS REFER TO DRAWING 17-110/2012.
 - FOR HIGHWAY CONSTRUCTION DETAILS REFER TO DRAWING NUMBER 17-110/2014.
 - LATERALS TO PRIVATE AREAS NOT SHOWN ON THIS DRAWING. REFER TO ENGINEERING LAYOUTS FOR LOCATIONS AND DETAILS.

- LEGEND
- EXISTING GROUND PROFILE
 - PROPOSED ALIGNMENT PROFILE
 - FOUL WATER SEWER AND MANHOLE
 - SURFACE WATER SEWER AND MANHOLE
 - PROPOSED ROAD GRADIENT
 - EXTRA STRENGTH VITRIFIED CLAY WITH SPIGOT AND SOCKET FLEXIBLE JOINTS TO BS EN 295.
 - FLEXIBLE JOINTED CONCRETE PIPES TO BS EN 1916:2002/BS 5911_1:2002 CLASS 120

CAUTION TO BE TAKEN WHEN WORKING WITHIN CONFINED SPACES, REFER TO ODYSSEY'S DESIGNERS HEALTH AND SAFETY REPORT. CONTRACTOR TO UNDERTAKE RISK ASSESSMENT

CAUTION WHEN MANEUVERING DUE TO WEIGHT AND SIZE

TENDER
ISSUE

A	UPDATES TO SUIT AS BUILT INFORMATION	THR	RM	LH	25.06.19	
Rev	Amendments		Dm	Chk	App	Date

ODYSSEY

Tuscany House
White Hart Lane
Basingstoke
Hampshire RG21 4AF

Telephone: 01256 331144
Fax: 01256 331134
E: info@odysseyconsult.co.uk
W: www.odysseyconsult.co.uk

Job Title

WOODCROFT FARM, HAVANT
PHASE 1B

Drawing Title

LONGITUDINAL SECTION
SHEET 8 OF 8

Client

Scale	Date	Designed
AS SHOWN	MAR 2019	RM
Drawn	Checked	Approved
THR	RM	LH
Job No	Drawing No	Rev
17-110	17-110/2221	A