



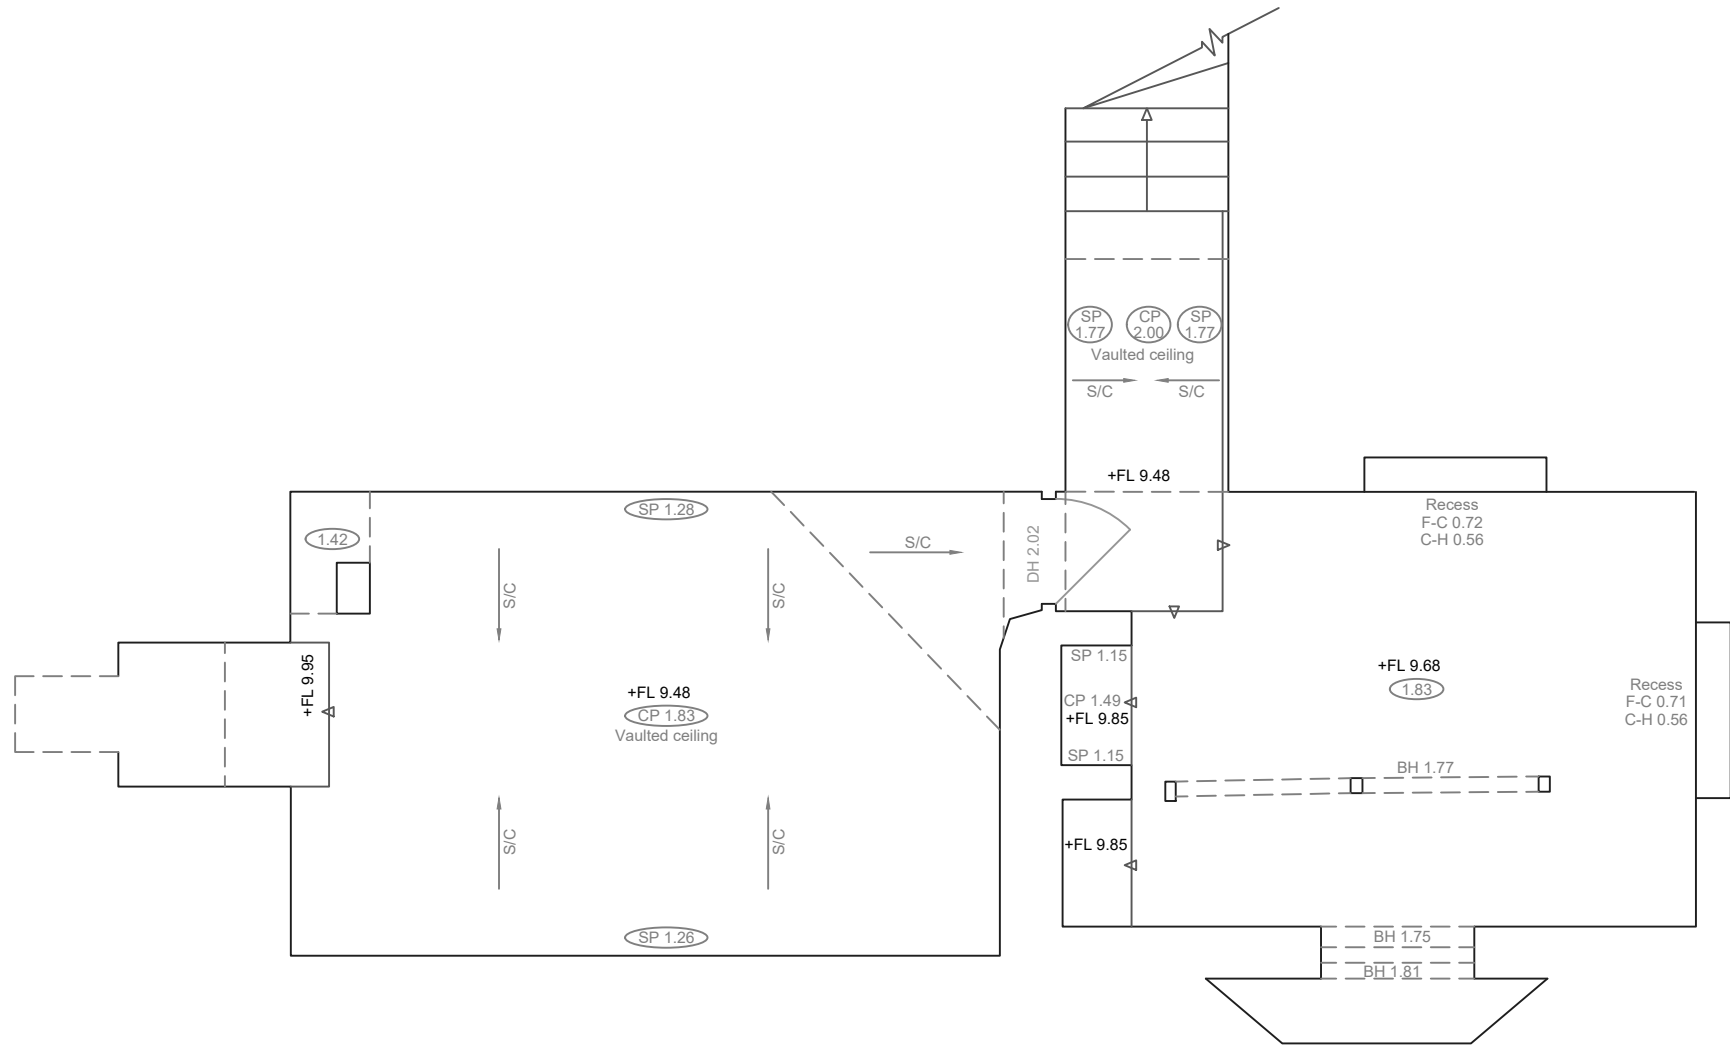

Fit Point A

Ground Floor Plan

Fit Point B

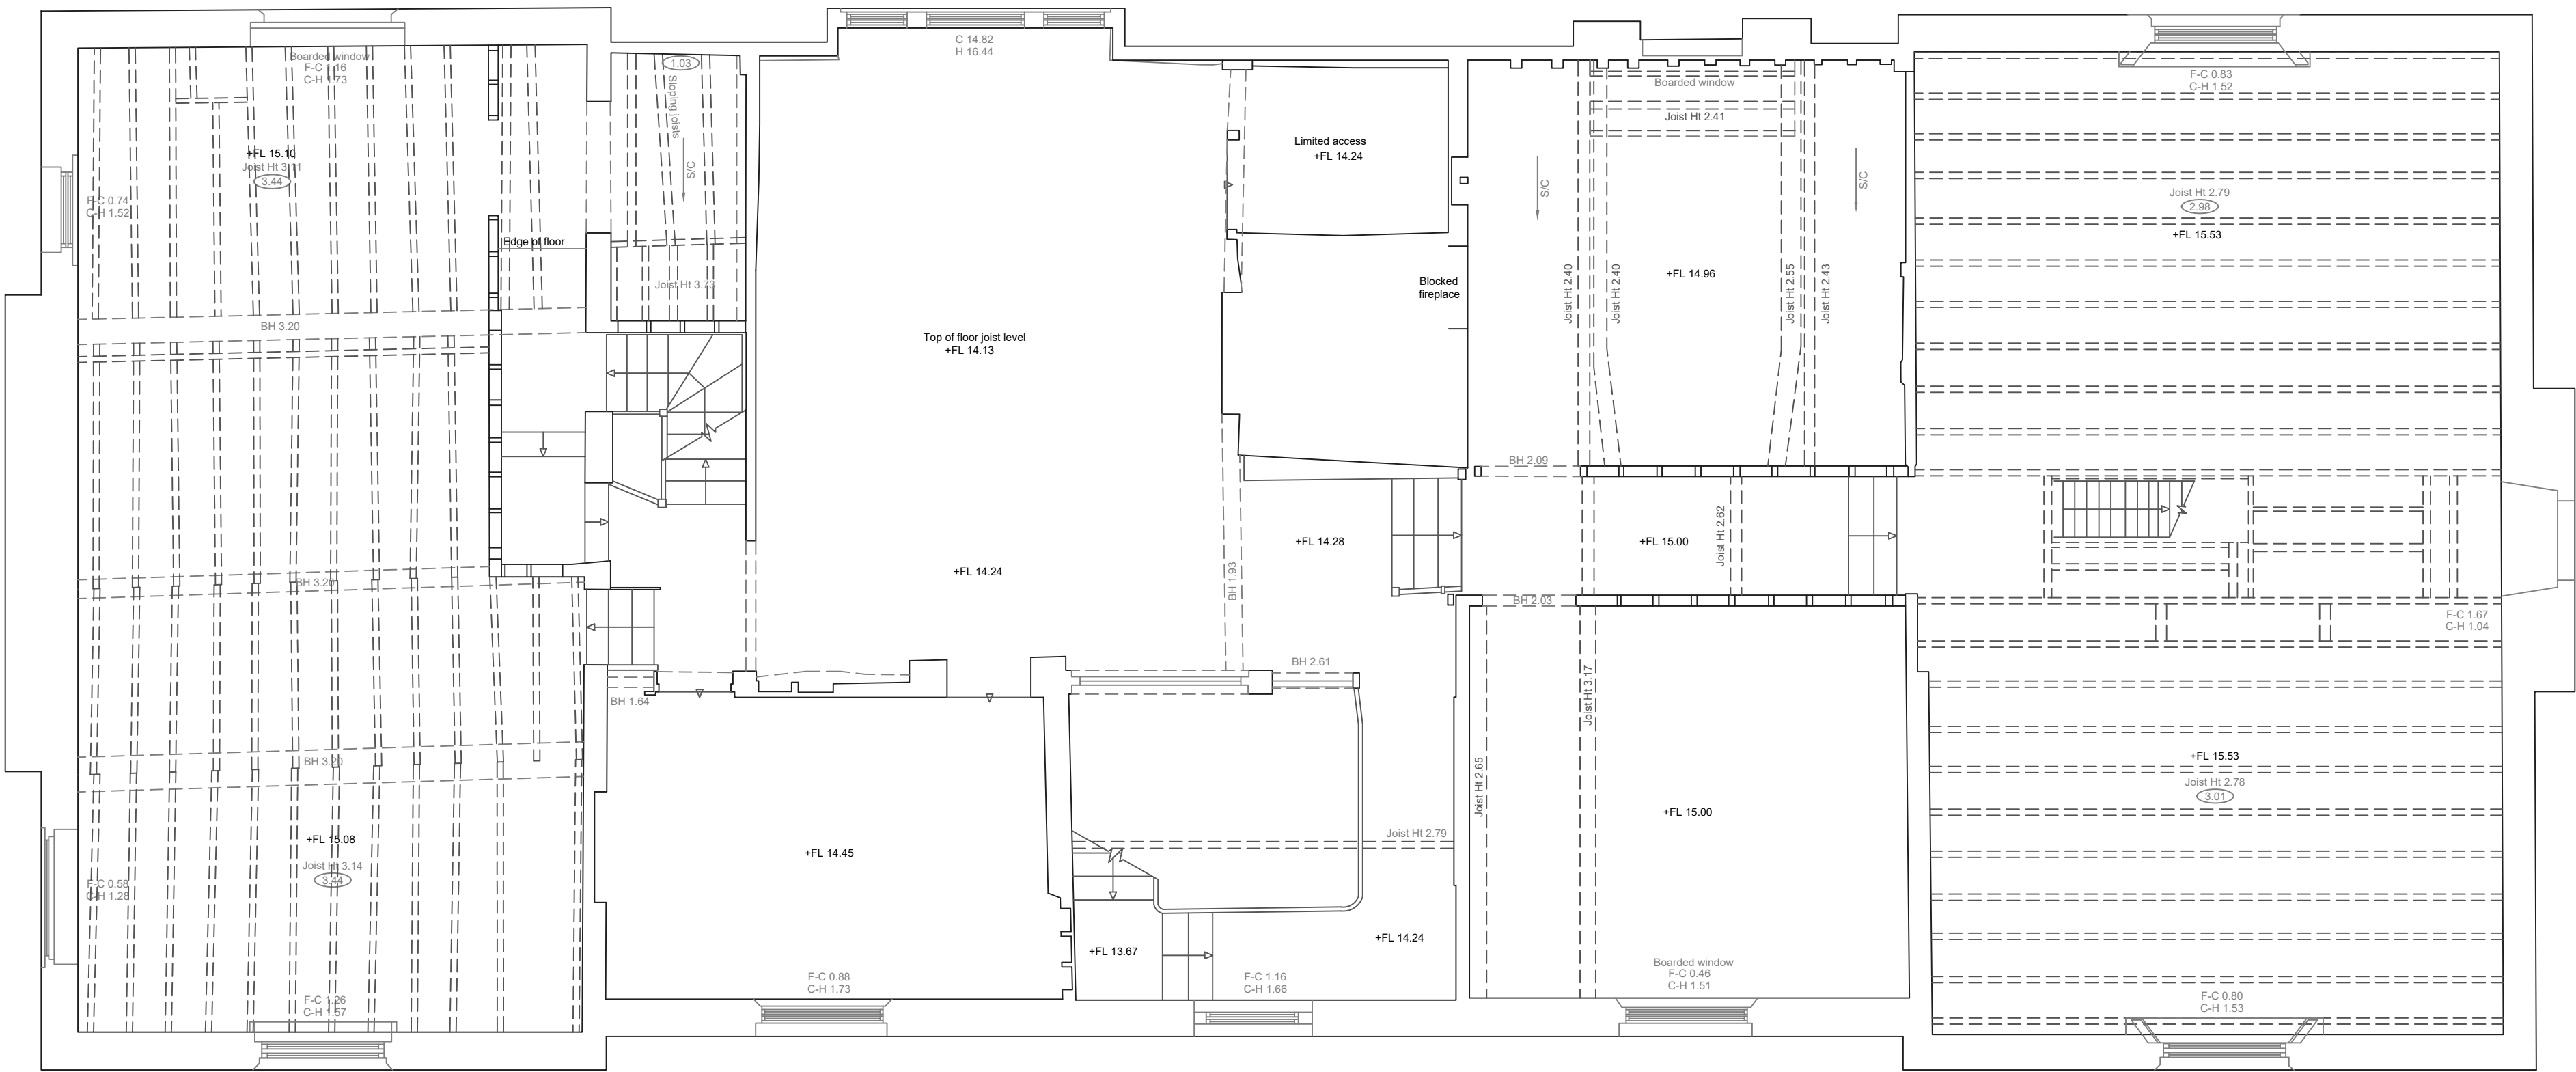

Fit Point A

First Floor Plan

Notes

- The survey was carried out in December 2018.
- Grid and levels based OS national grid. Obtained through GPS observation.
- All values are displayed in metres.


Survey Key

BH	FLOOR TO BEAM HEIGHT
BL	UNDERSIDE OF BEAM LEVEL
C	CILL LEVEL
C-H	CILL TO HEAD HEIGHT
CL	COVER LEVEL
COL	COLUMN
CT	CEILING TYPE
DH	DOOR HEAD HEIGHT
F-C	FLOOR TO CILL HEIGHT
+FL	FLOOR LEVEL
FT	FLOOR TYPE
GV	GAS VALVE
GY	GULLY
H	HEAD LEVEL
MH	MANHOLE COVER
RAD	RADIATOR
RS	ROLLER SHUTTER
RWP	RAIN WATER PIPE
S/C	SLOPED CEILING
SCL	SLOPED CEILING LEVEL
+SF	SOFFIT LEVEL
SP	SIGN POST
SV	STOP VALVE
TP	TACTILE PAVING
T/R	TOWEL RAIL
TW	TOP OF WALL LEVEL
2.30	CEILING HEIGHT
2.30	FALSE CEILING HEIGHT
2.30	SLIDING DOOR

ISSUE/ REVISION

Rev	Date	Status/ Amendment	Drawn	Checked

Scale Bar

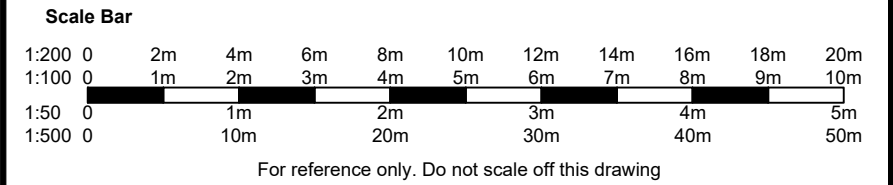

T: 01525 300721 E: info@besgeo.co.uk W: www.besgeo.co.uk

Client:

Project: **The Manor House, Bedhampton.**

Title: **Basement & First Floor Plans**

Sheet Number:

Status: **Draft**

Checked: **BS**

Drawn: **CE**

Date: **23/01/2019** Scale: **1:50 @ A1**

Project No: **BES18190** Drg No: **3** Rev: **B**

TOPOGRAPHICAL SURVEYS GPS MEASURED BUILDING SURVEYS
3D LASER SCANNING AS-BUILT SURVEYS AREA MEASUREMENTS