






West Elevation (to Station Road) - As Built

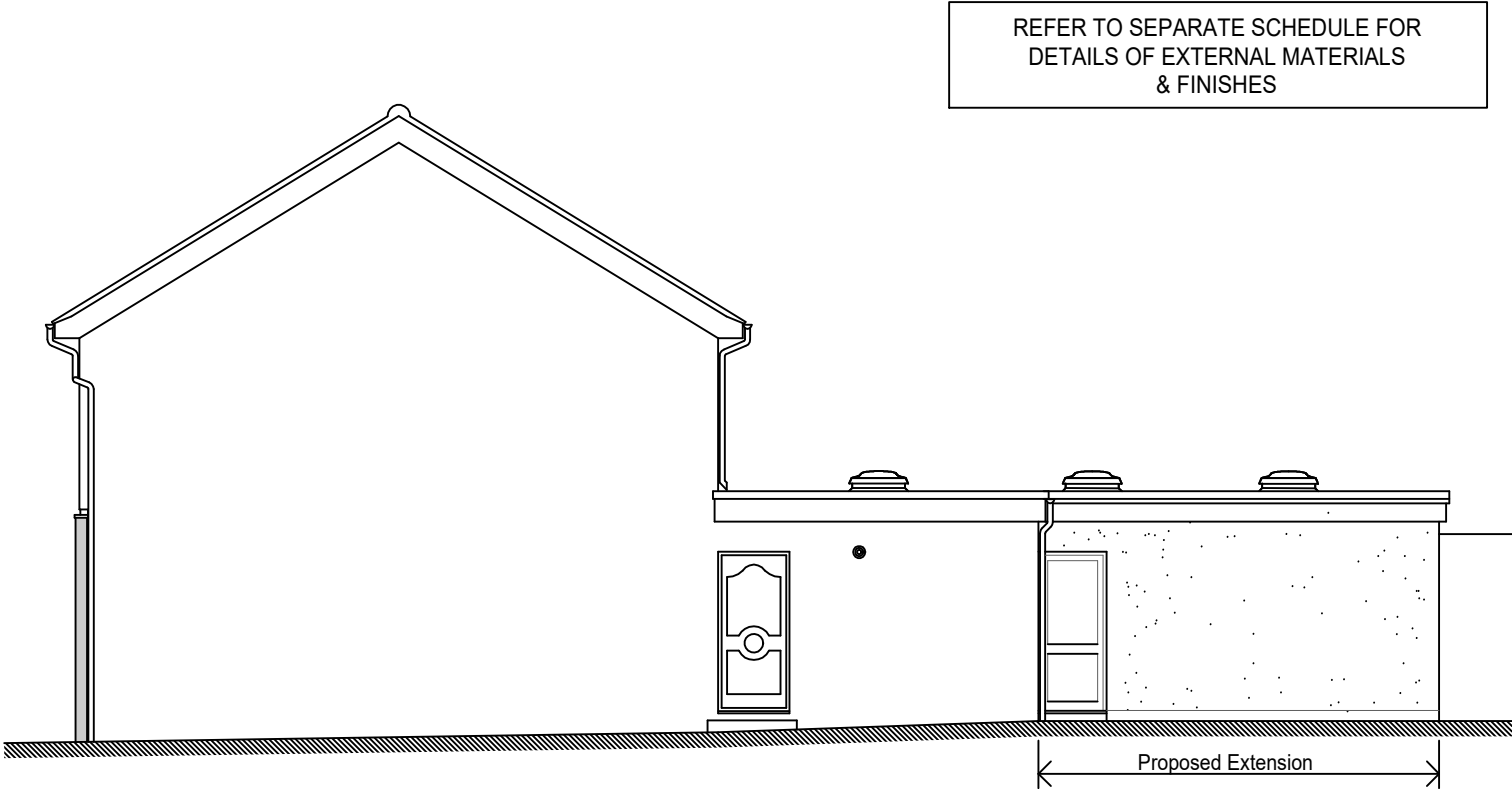


Proposed South Elevation

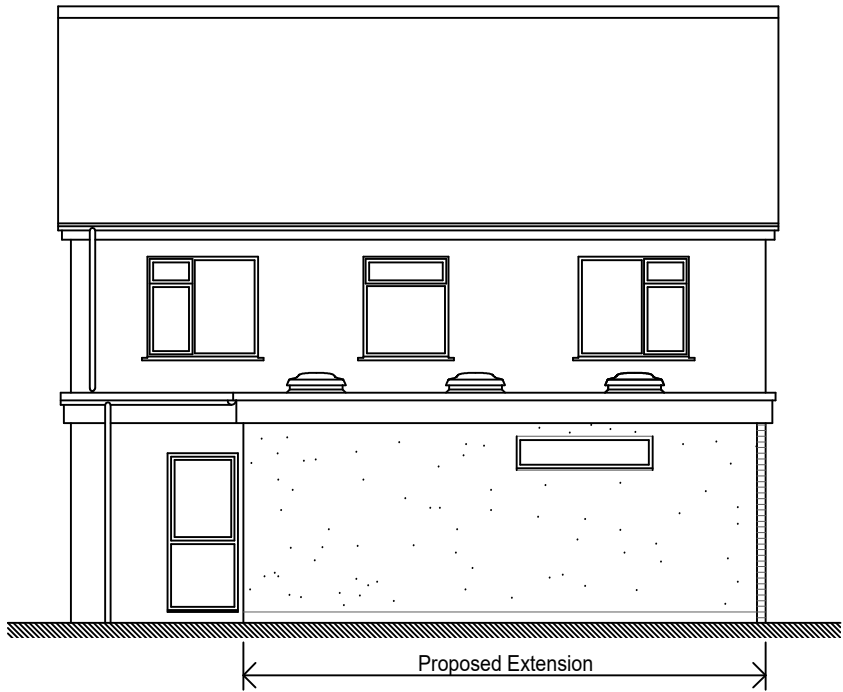

Proposed East Elevation

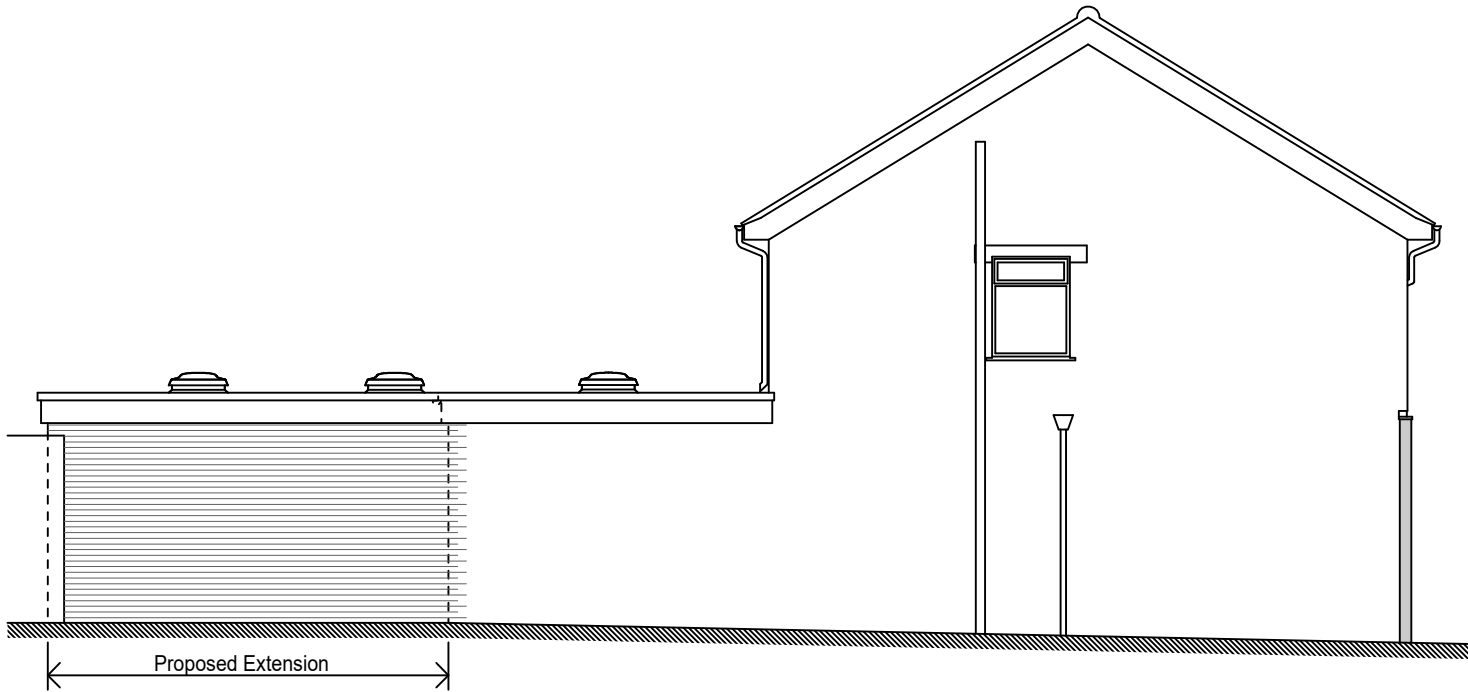

Proposed North Elevation

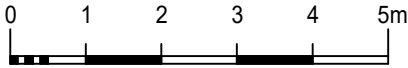

REFER TO SEPARATE SCHEDULE FOR
DETAILS OF EXTERNAL MATERIALS
& FINISHES

This drawing is the copyright of the Architect and must not be reproduced without permission, except by the Local Planning Authority for planning purposes. Figured dimensions to be taken in preference to scaled. Dimensions to be checked on site before work commences. No deviation from this drawing will be permitted without the prior written consent of the Architect. Ground floor slabs, foundations, structure, etc., and all work below ground is shown provisionally and inspection of ground conditions is essential prior to work commencing. Reassessment is essential when the ground conditions are apparent and redesign may be necessary in the light of soil conditions found. The responsibility for establishing the soil and subsoil conditions rests with the Contractor.	drawing	drawing no.				rev.	date	scale(s)	sheet size	
	PROPOSED ELEVATIONS WITH ENLARGED EXTENSION	21701/115					DEC 2019	1:100	A3	
		client								
		T & S DICKINSON								
	project	project								
CONVERSION TO DENTAL SURGERY AT FORMER BEAUTY SALON, 32 STATION ROAD HAYLING ISLAND, HAMPSHIRE PO11 0EG	Jeffrey Douglas Chartered Architect									
	60a Simsb Lane Hayling Island Hampshire PO11 0EH									
	Tel: (023) 9246 8889 E-mail: jdo@jeffreydouglas.co.uk									
										