

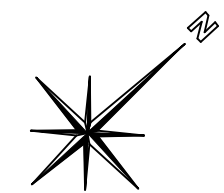
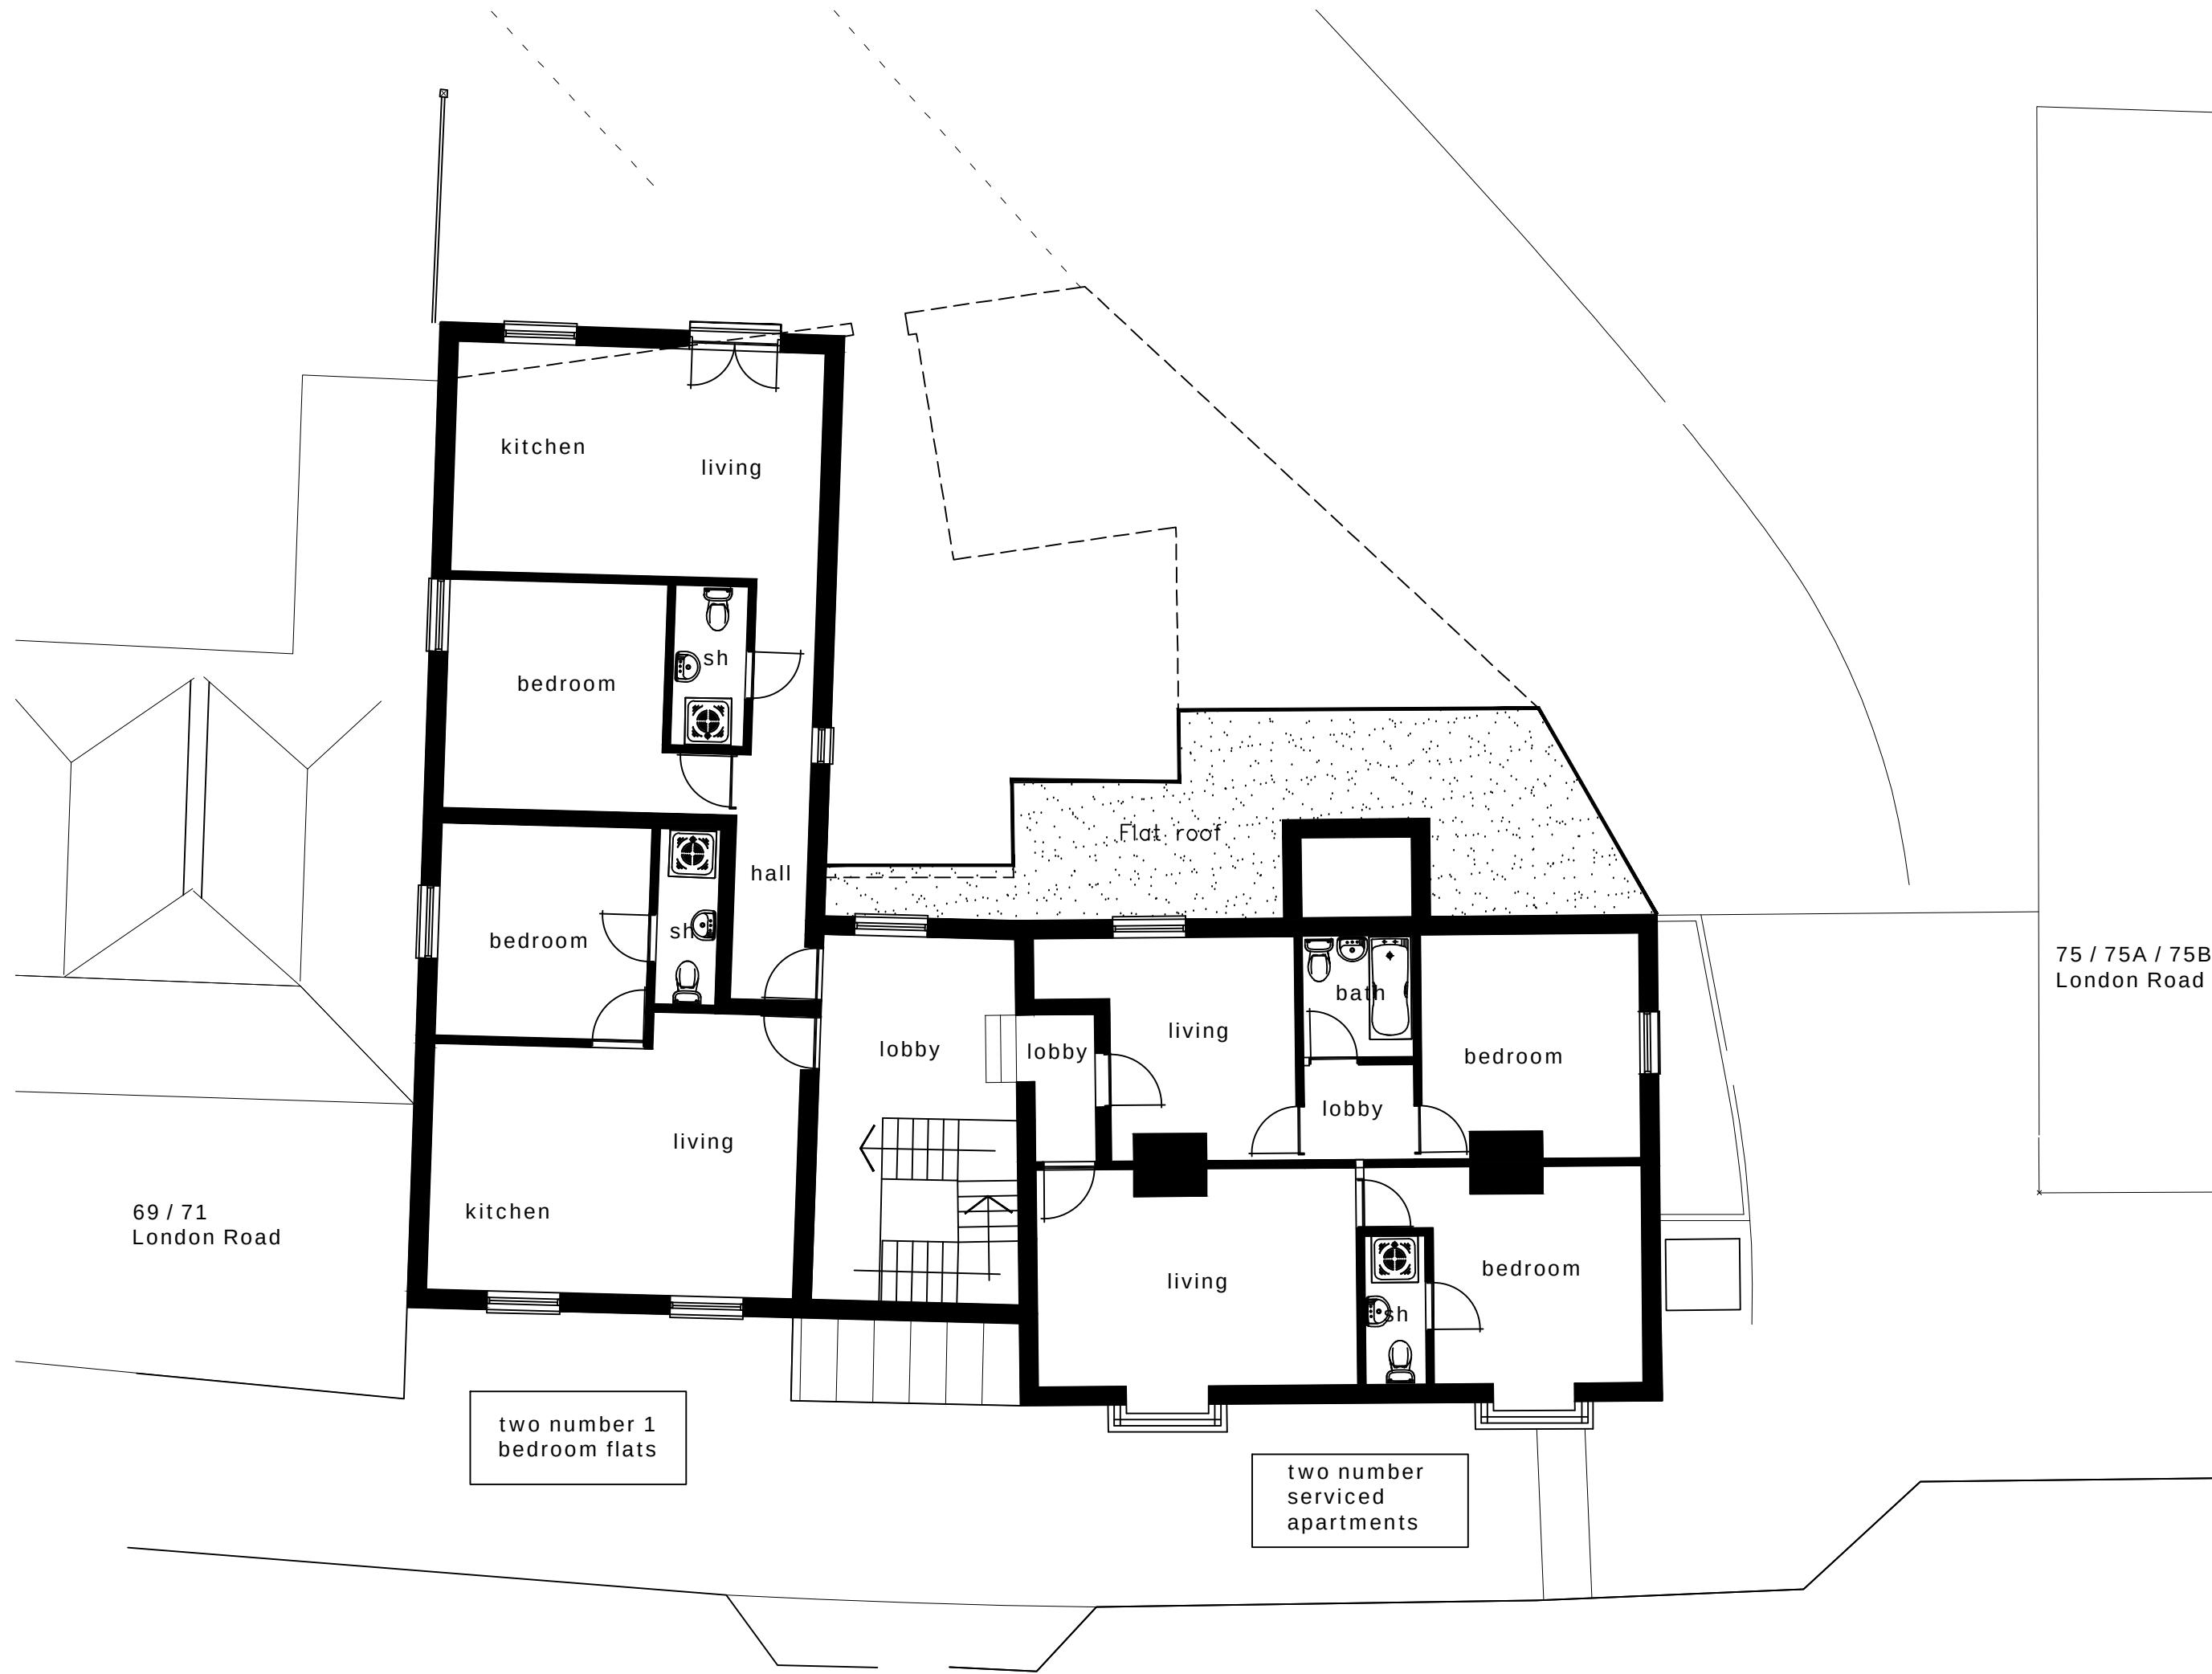


As approved layout - PP/17/01355
FIRST FLOOR SCALE 1:100

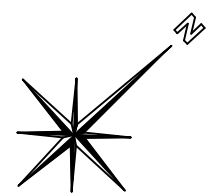

As approved layout - PP/17/01355
FIRST FLOOR

As constructed layout
FIRST FLOOR SCALE 1:100

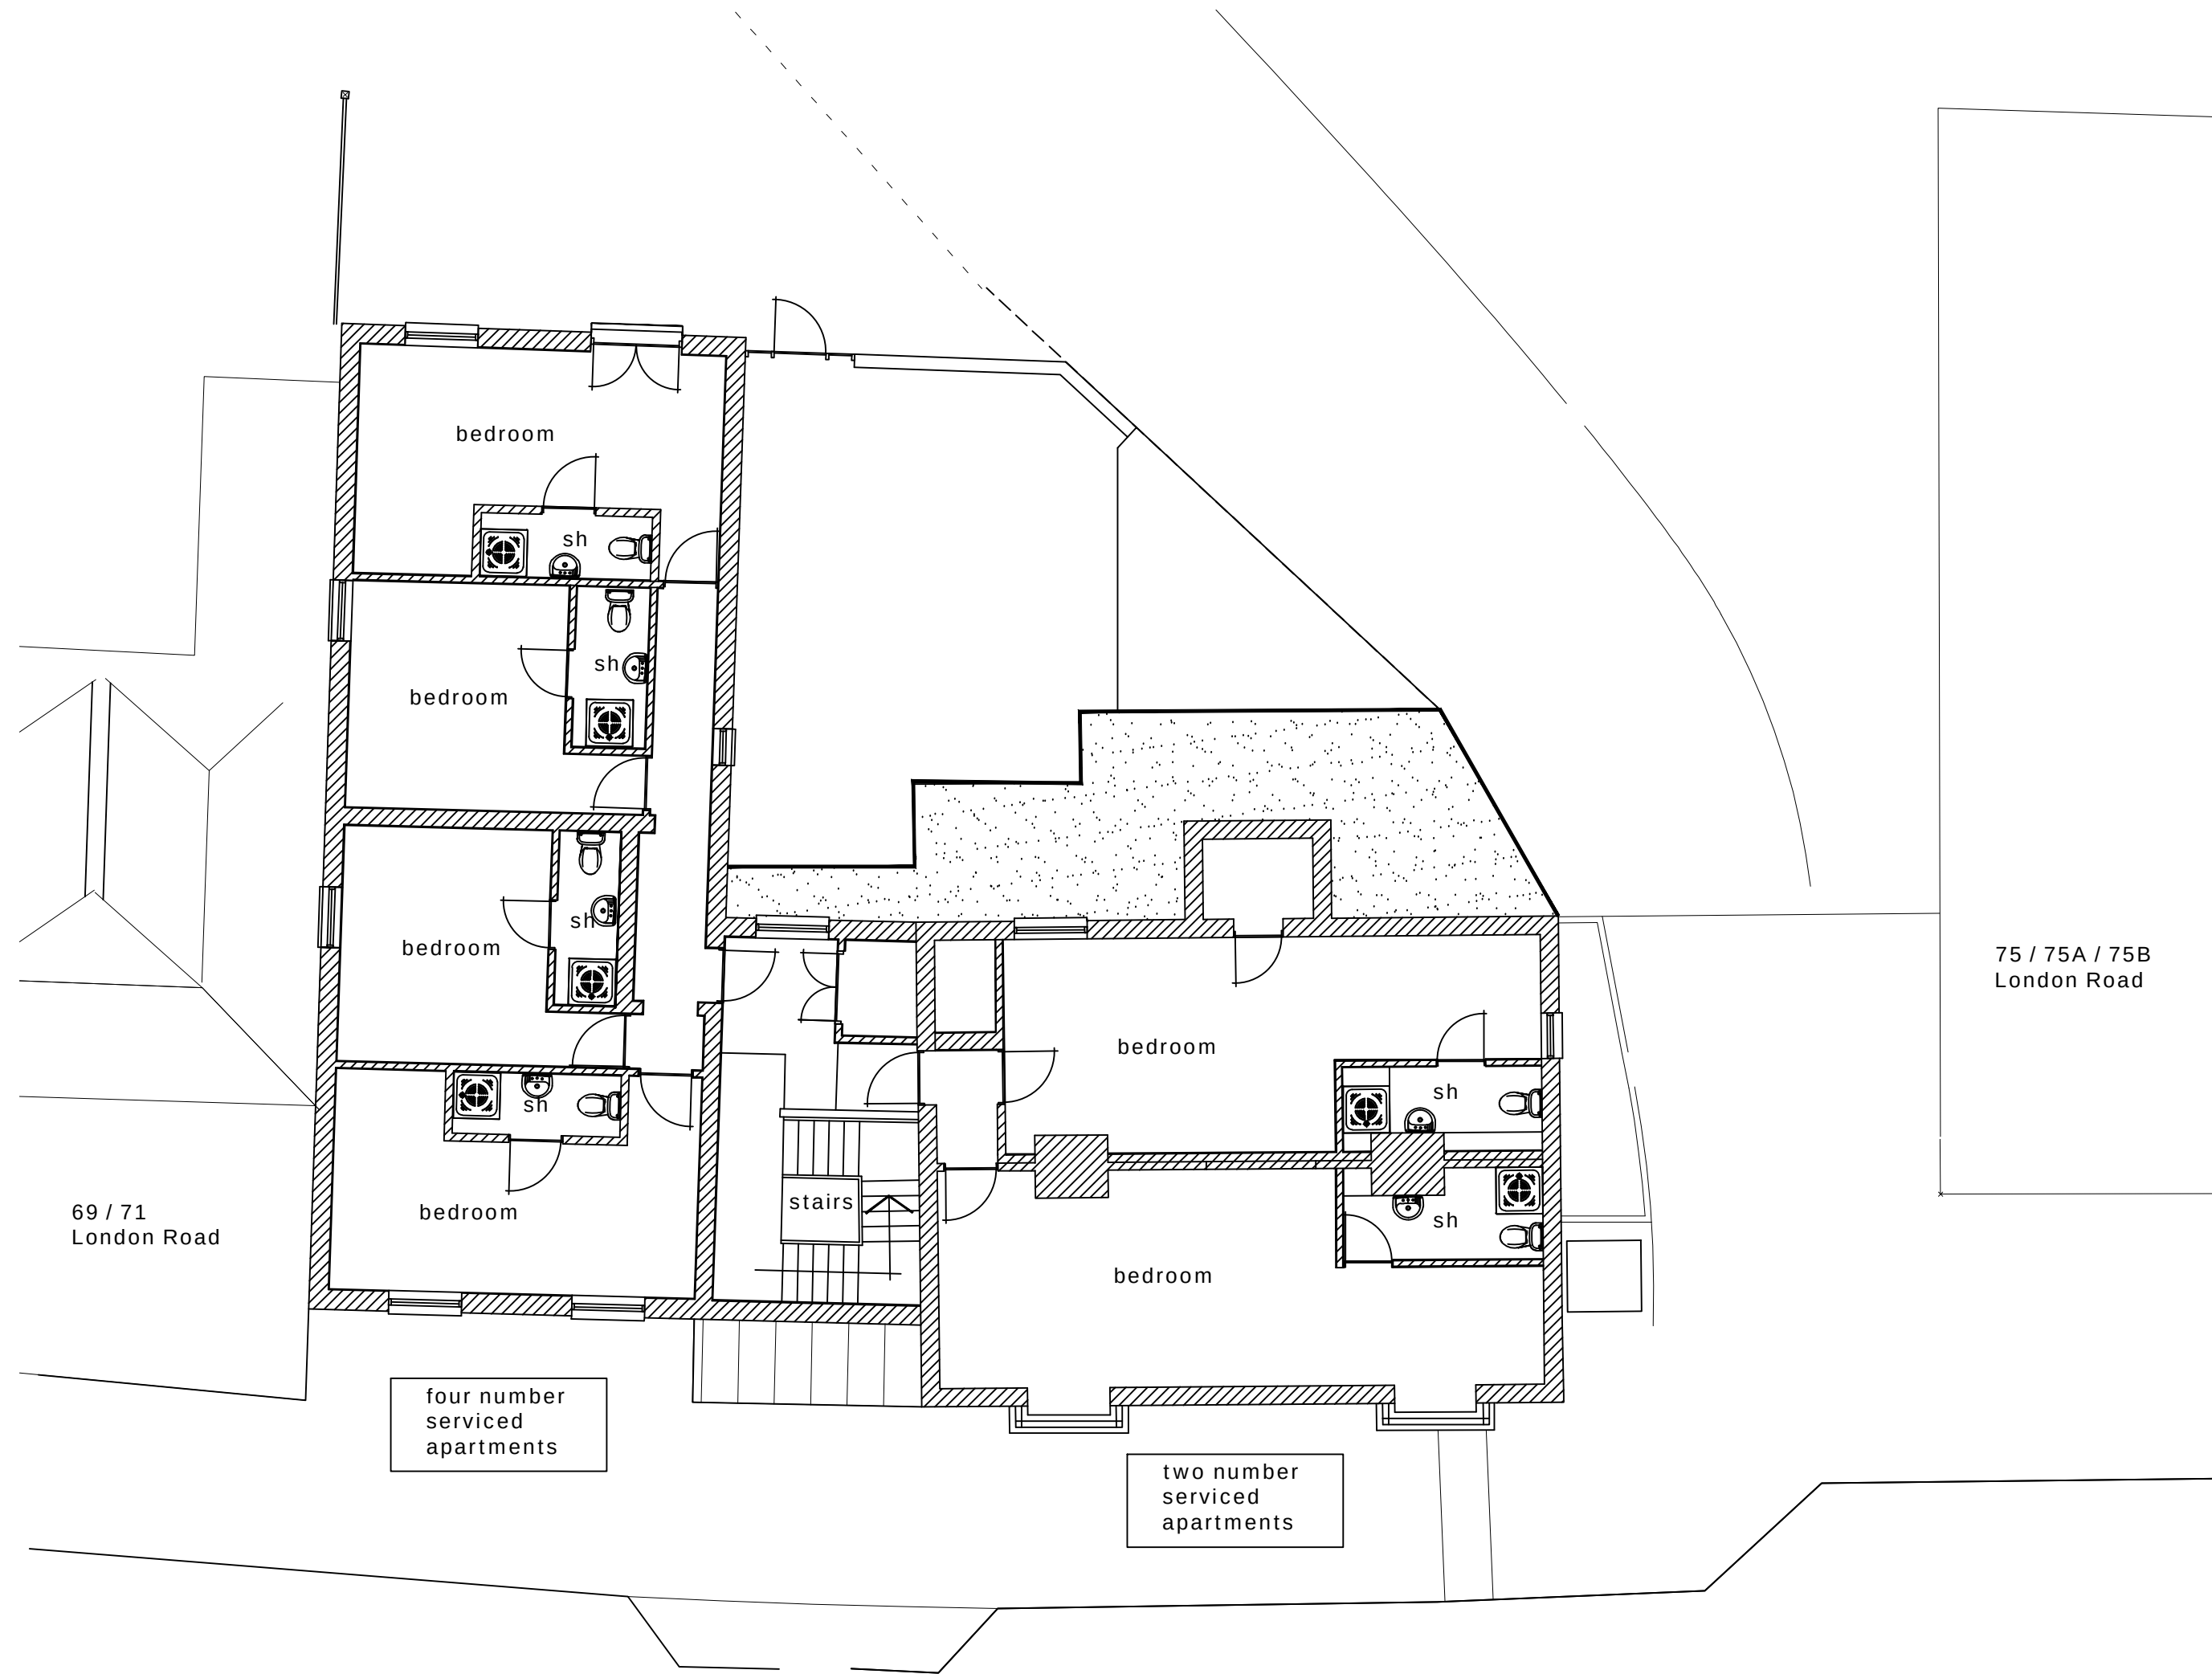

As constructed layout
FIRST FLOOR

NOTES:
The design and construction of this project shall be in accordance with the current Building Regulations & NHBC Standards. These notes & drawings have been prepared solely for the purpose of Planning & Building Regulation approval.

Do not scale from this drawing unless for Planning purposes. All dimensions to be checked on-site and any alterations to be approved by the Architect and/or client prior to any work commencing.

Ordnance Survey Licence No: 100047591

This drawing to be copyright and to be read in conjunction with all other drawings

AMENDMENTS:

KEY:



CLIENT NAME
& ADDRESS

M Forfar Ltd
13 Castle Road
Southsea
Hampshire
PO5 3DE

PROJECT
ADDRESS

The Wellington Public House
73 London Road
Waterlooville
PO7 7EX

DRAWING DETAILS

AS APPROVED / BUILT DRAWING

First Floor Layout

PROJECT No 898	DWG No 20	REV No
SCALE 1:100 @ A1	DRAWN BWH	DATE: 21/10/19



**B H
ARCHITECTURE Ltd**
Heath Cottage
Newlands Lane
Purbrook
Waterlooville
Hants
PO7 5SQ
Tel: 023 9223 2322
Mob: 07747 771808
E-mail: bernard@bernardharding.com