




AS-INSTALLED FRONT ELEVATION

Scale 1:50

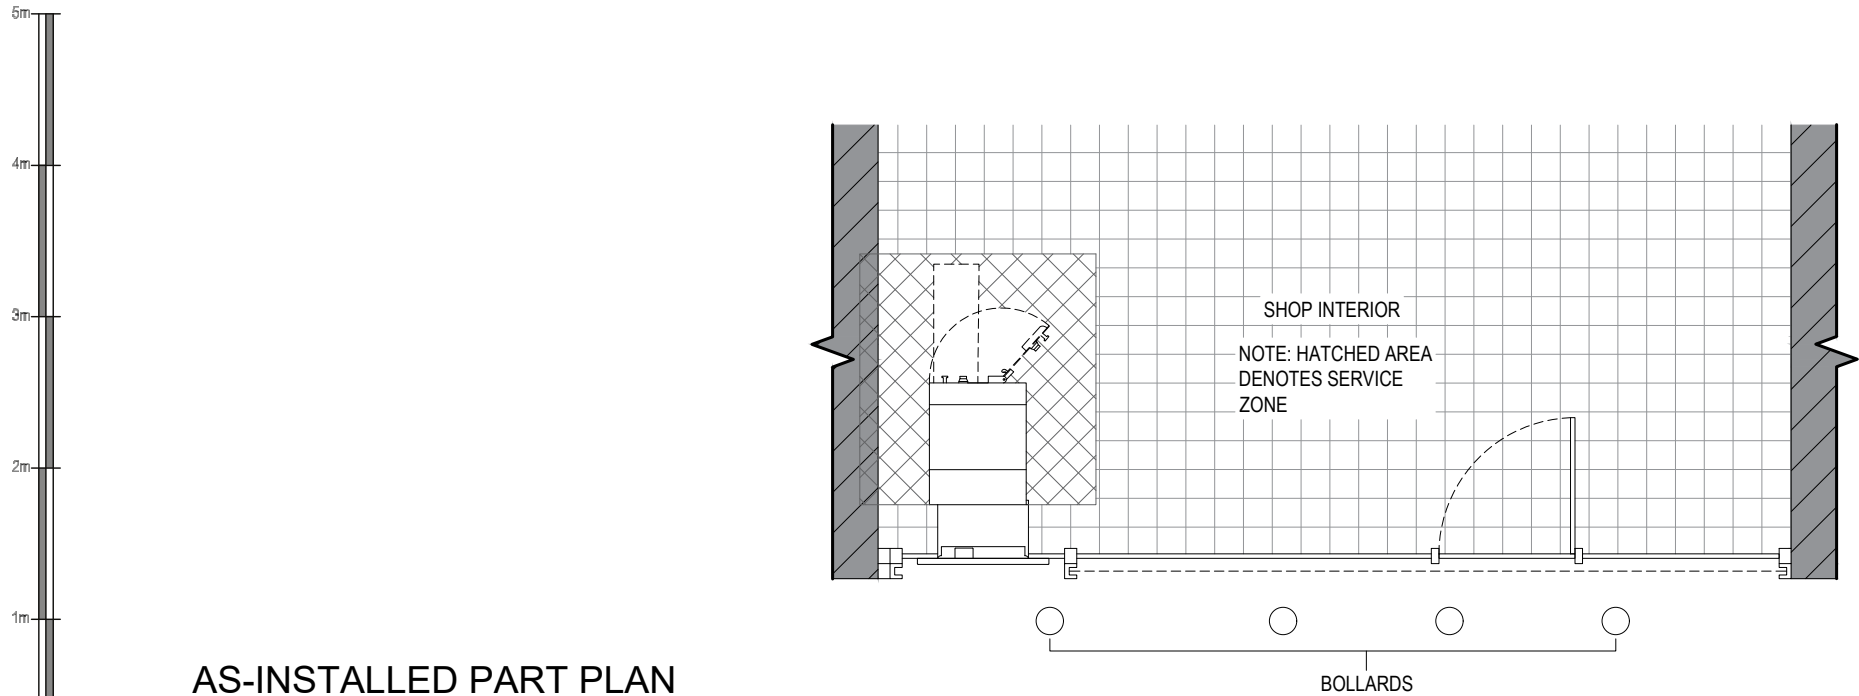

AS-INSTALLED PART PLAN

Scale 1:50

Date: Comments: By:

GENERAL NOTES:
 1) All dimensions in millimeters unless otherwise stated.

Site:
 Best One Waterlooville,
 2a Hambledon Road,
 Waterlooville,
 PO7 6XE

Drawing Title:
 As-Installed Plan and Elevation

Ref: T019458_AI	Date: 08/11/2019	Rev:
Scale: 1:50	Paper: A3	Date Rev: