



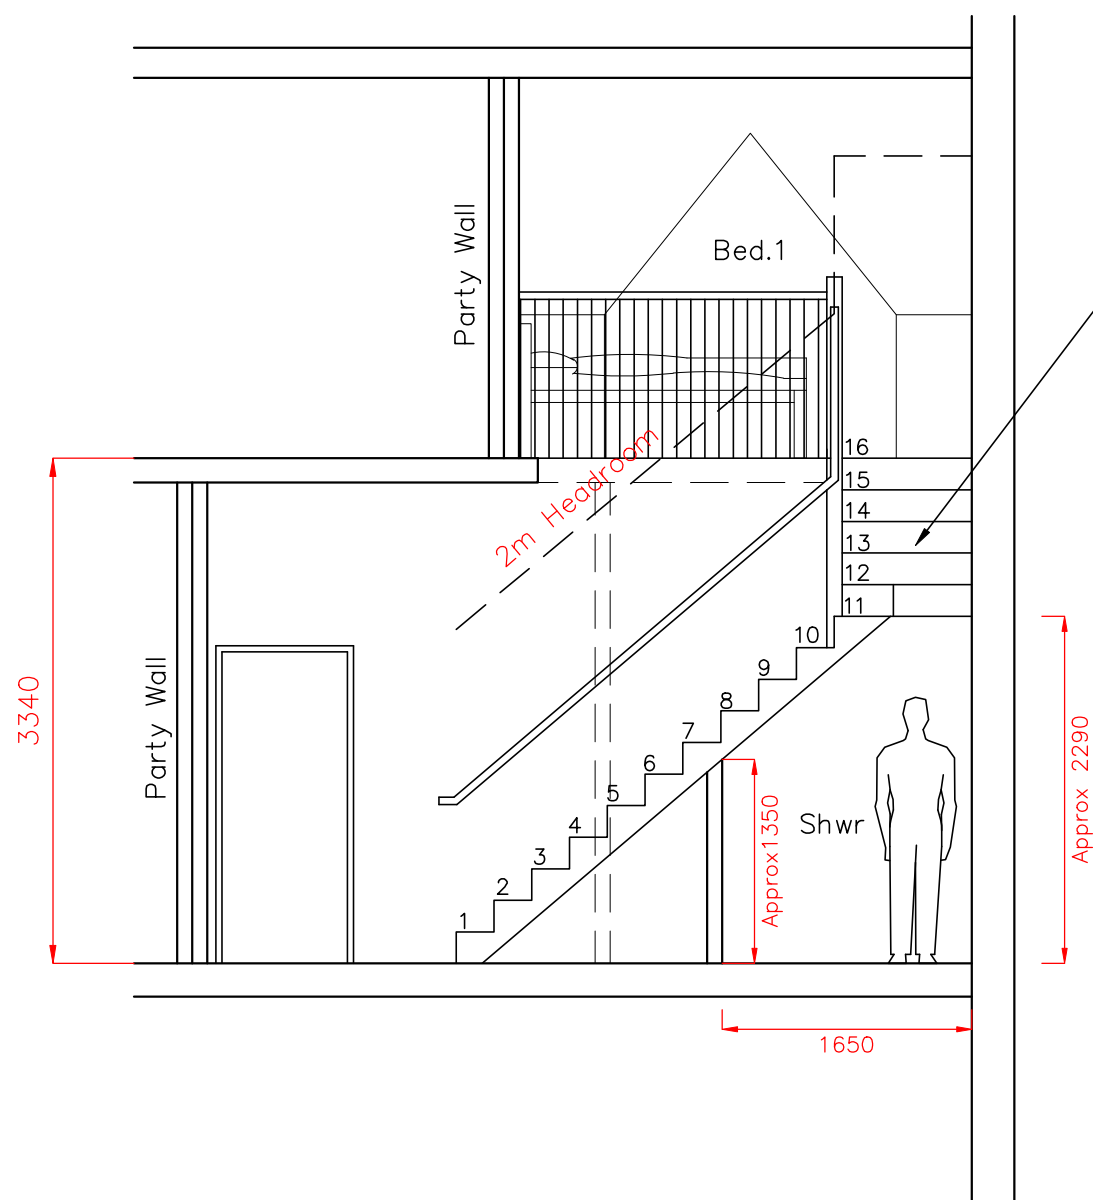


Proposed Stairs:  
Rise: 208.75mm  
Going: 250mm  
Width: 850mm  
Treads: 16  
Angle: 40°

Approx 2290

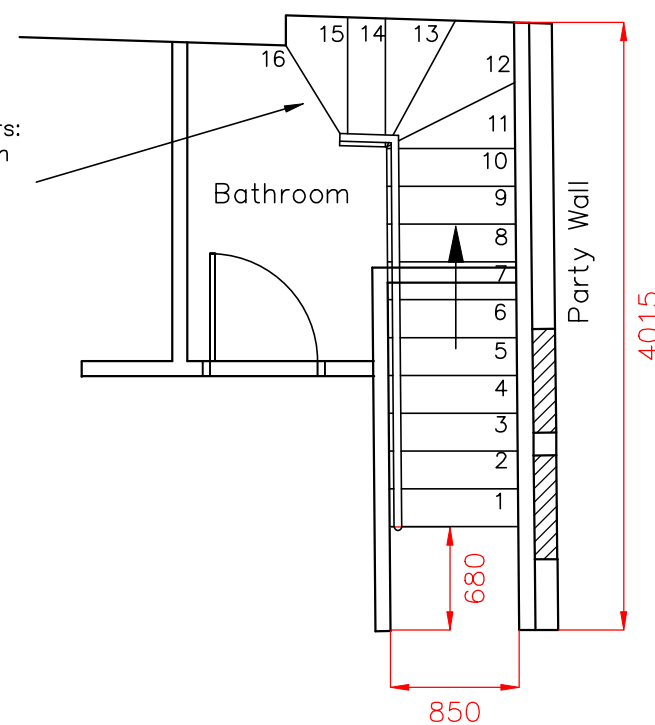

As Built Staircase  
First Floor Level

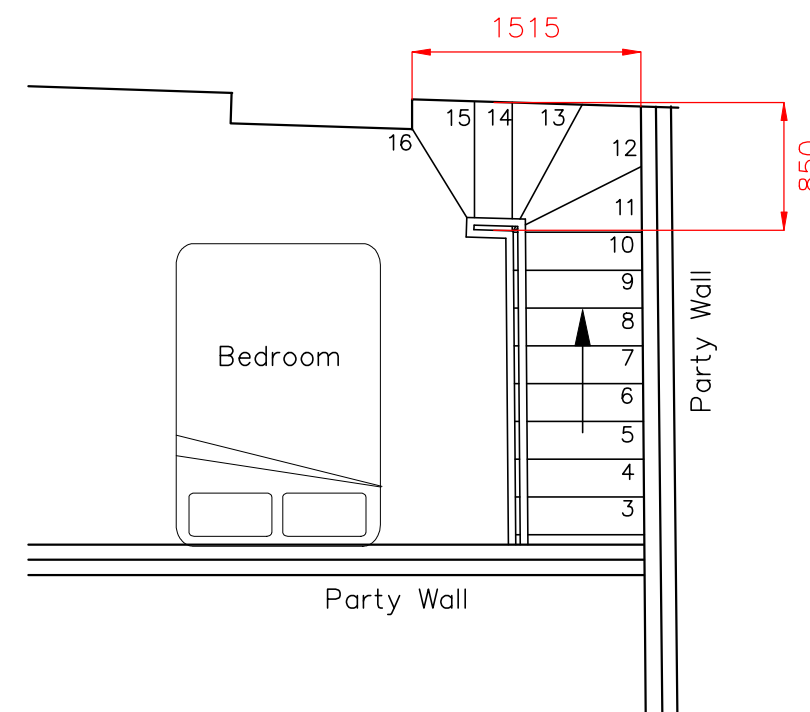

As Built Staircase  
Second Floor Level

**CAAD**

Critchley Architecture And Design Ltd.

Contact: 02392 474 919 | info@caad.online

The Old Brewery, 15E South Street, Havant, PO9 1BU



## Flat 1 Staircase Details: As Built 2019

### Revisions

- a) Note/Date/Initial
- b)
- c)
- d)

Flats 1-5  
White Hart Court  
1 East Street  
Havant  
PO9 1AA

Scale A1=1:25, A3=1:50  
Drawn SAR  
Date 29/03/19

17094-661<sup>0</sup>

5m

10m

15m

20m