




Existing Hallway Survey

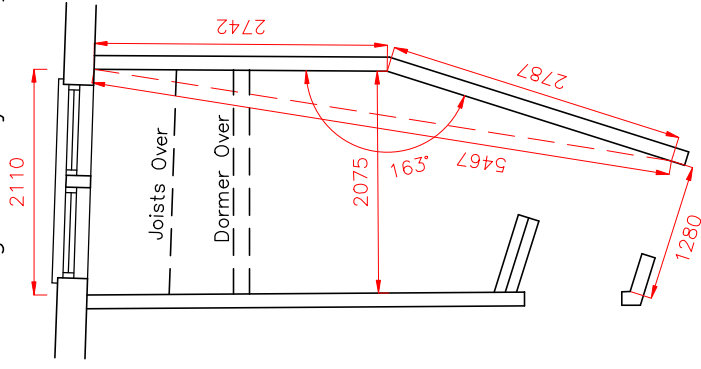


Ad Built Staircase FF

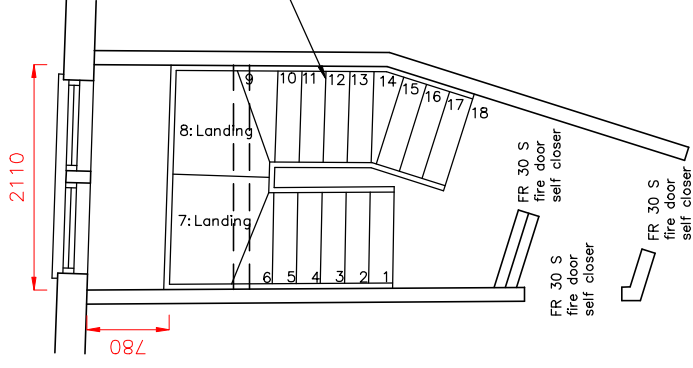

Existing Staircase
Ground to First

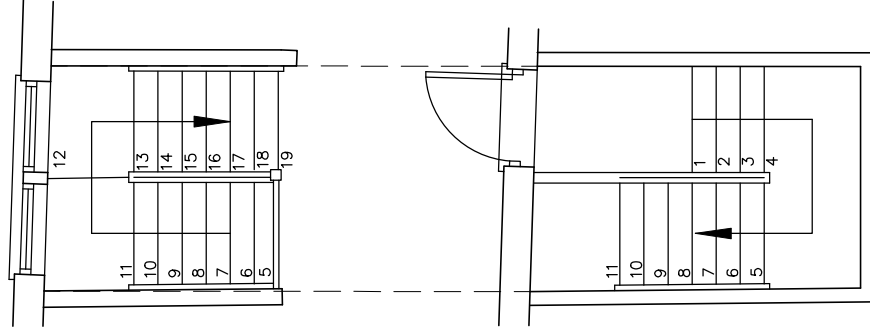

As Built Staircase SF

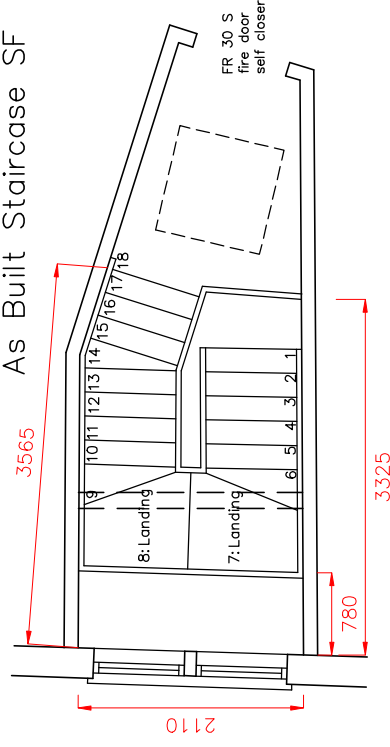

As Built Section

