



DRIFTWOOD CAFE, 44 HIGH STREET, EMSWORTH
AS BUILT

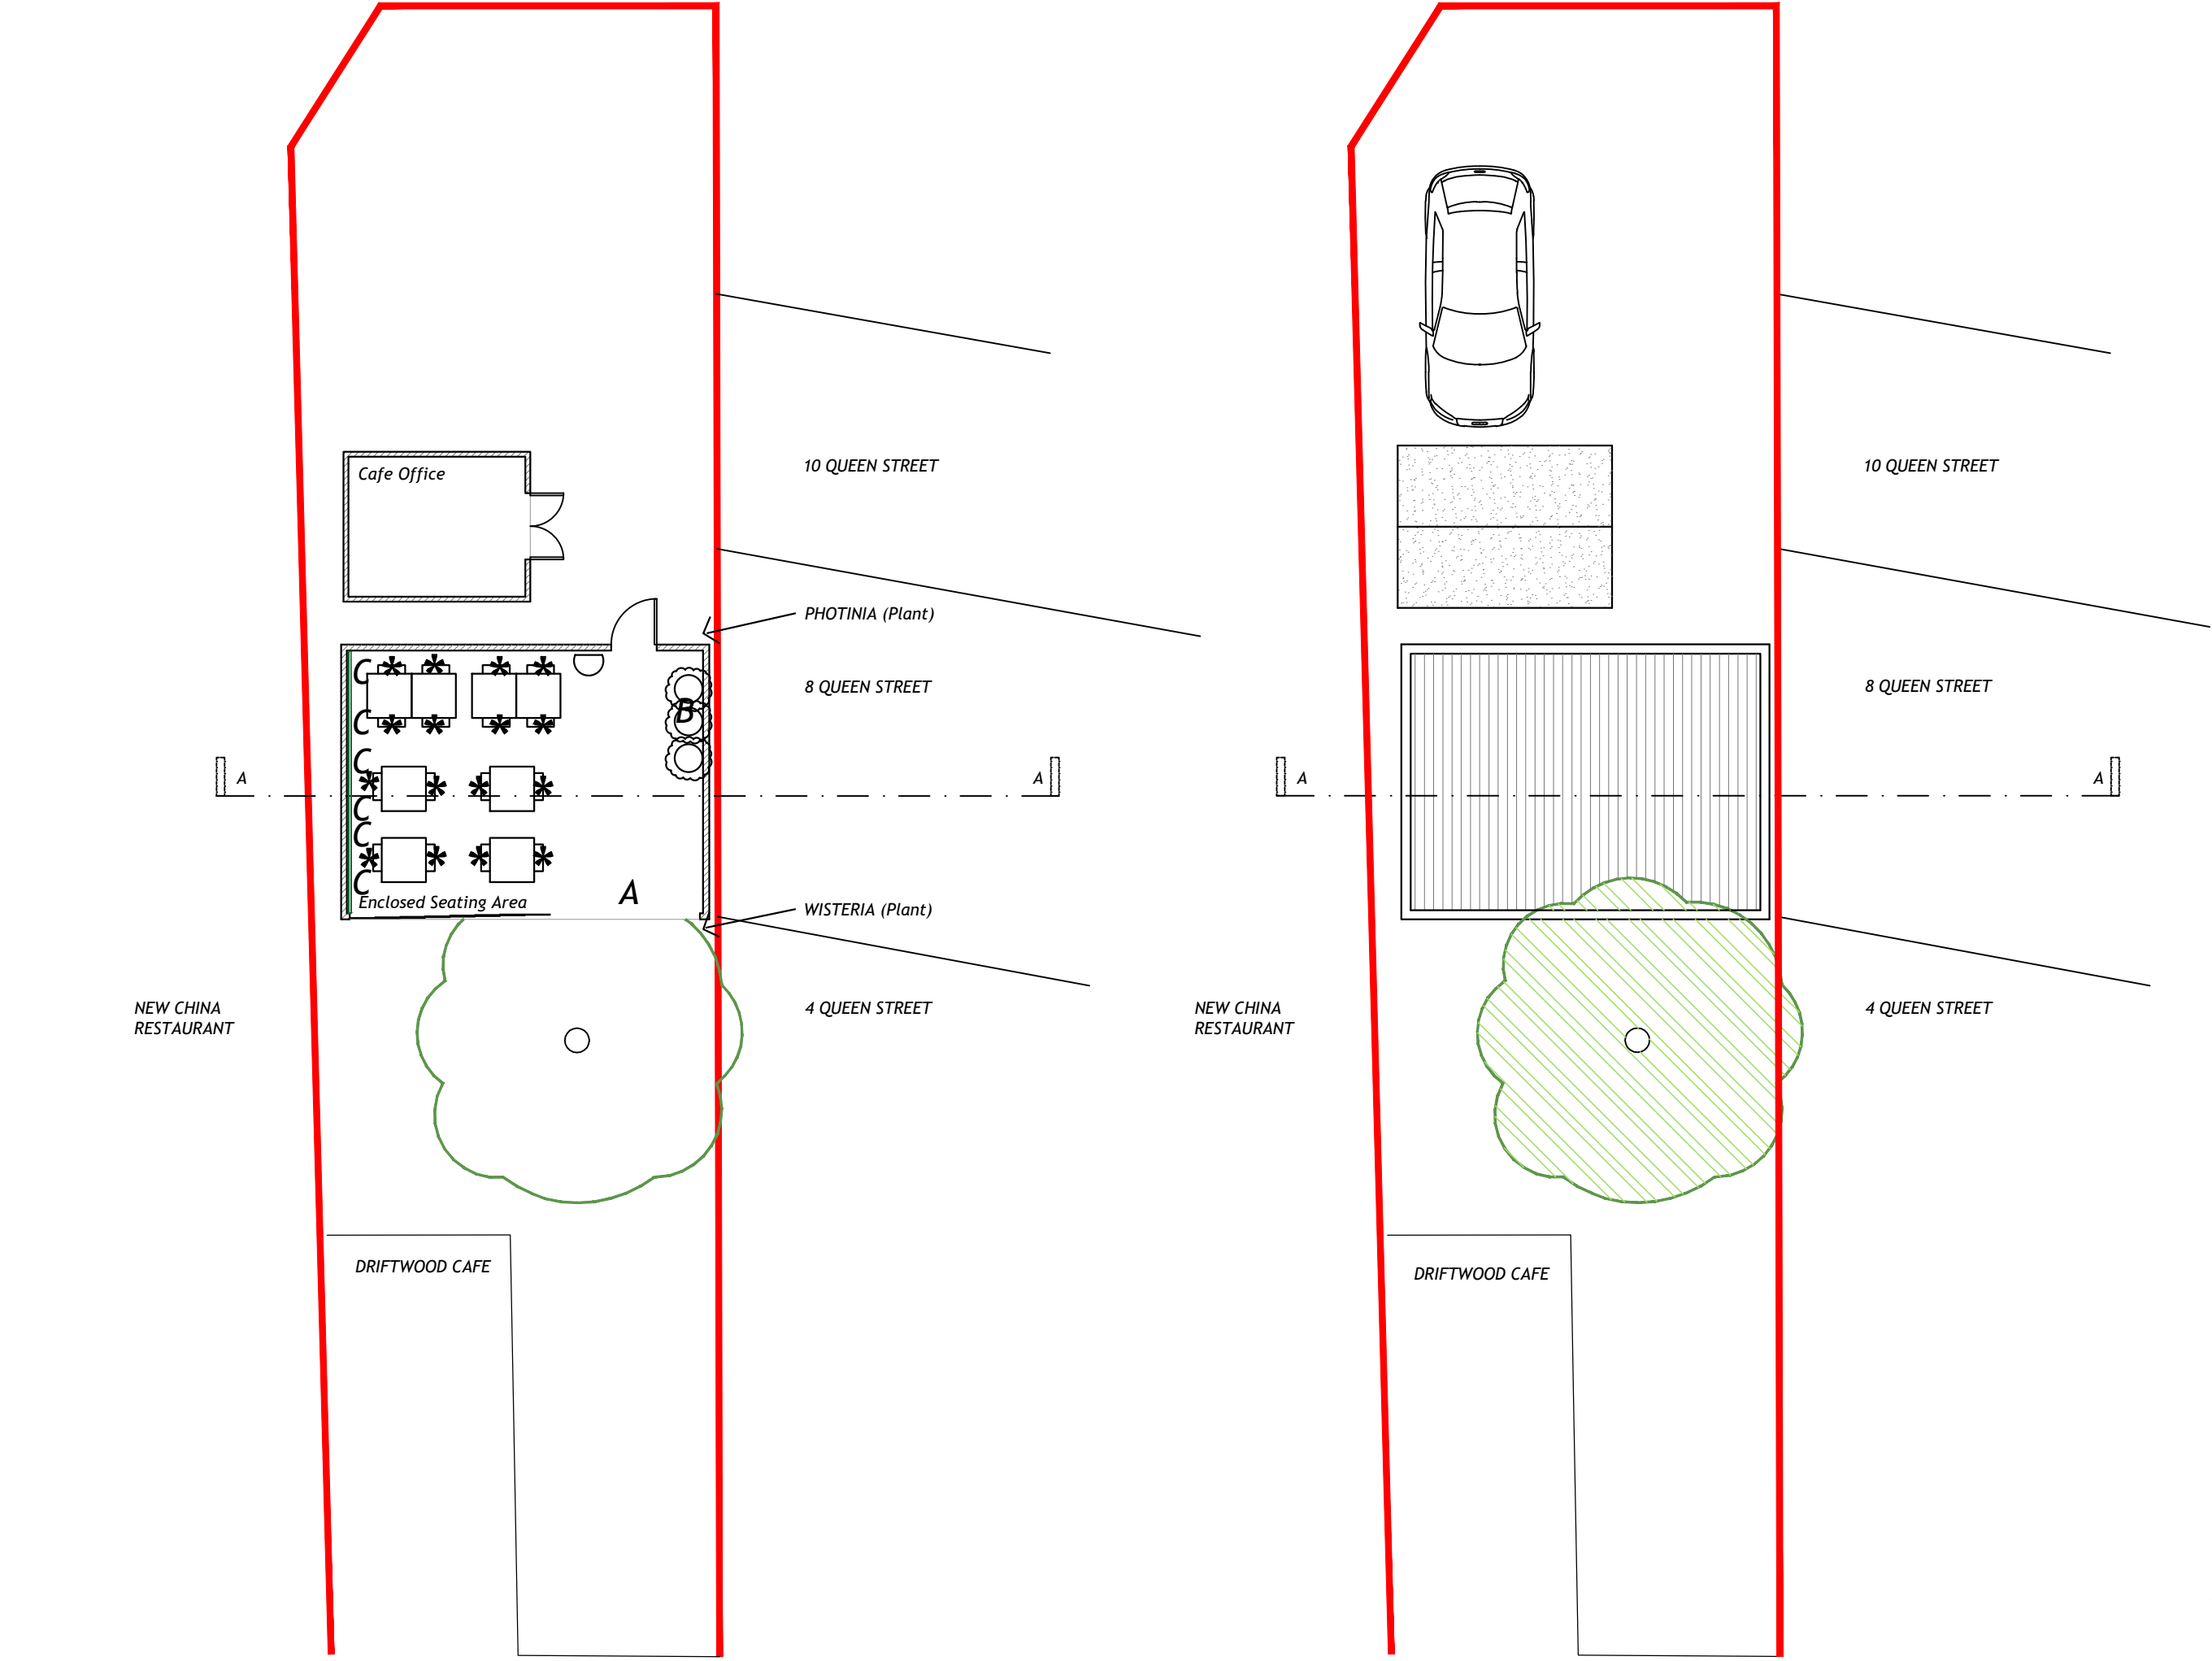


GROUND FLOOR PLAN
1:100

ROOF PLAN
1:100

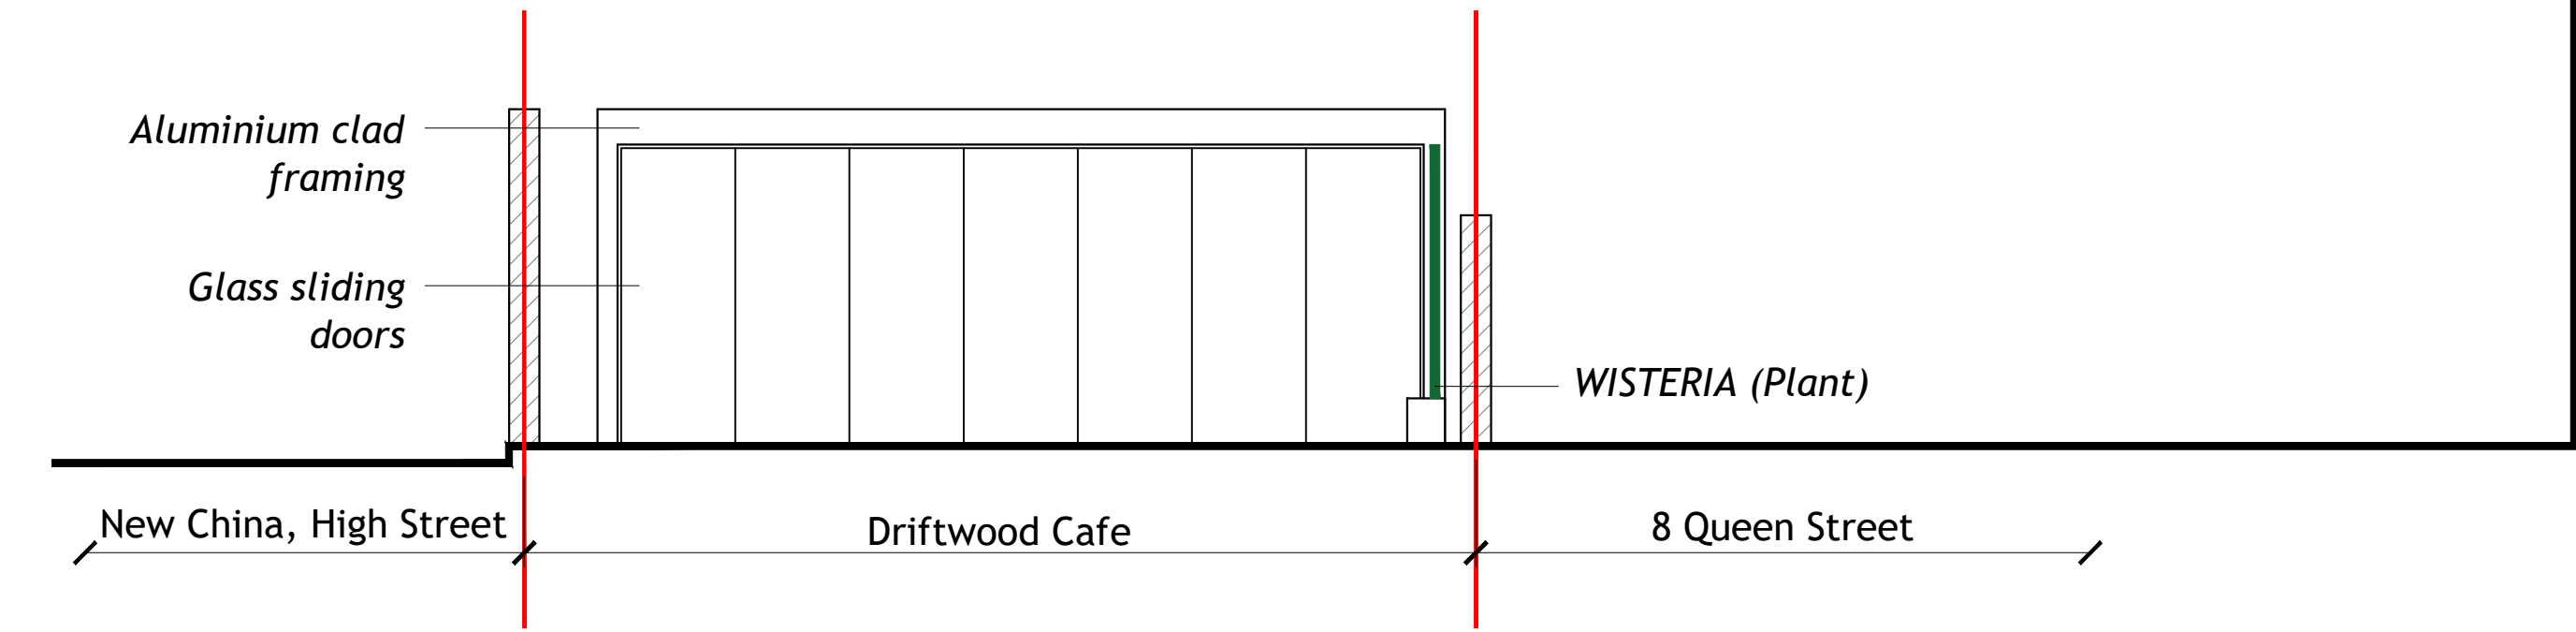

FRONT ELEVATION
[west] 1:100

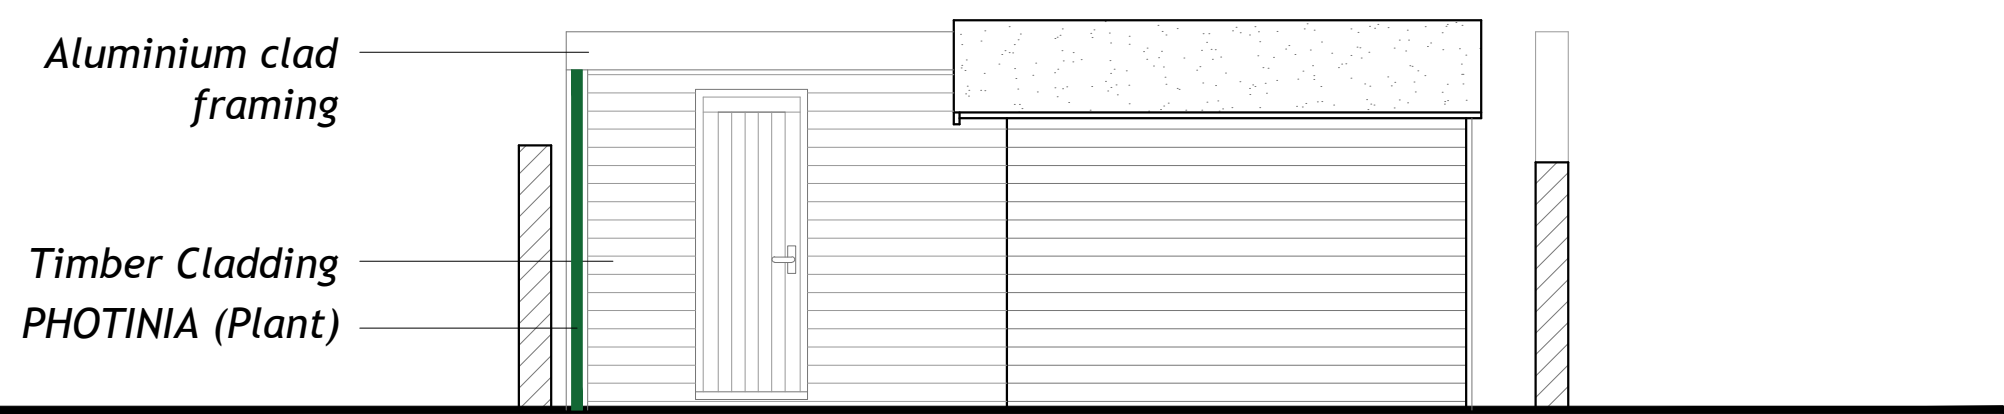


REAR ELEVATION
[east] 1:100




SOUTH ELEVATION
[Viewed from 8 Queen Street]
1:50


6/8 Queen Street

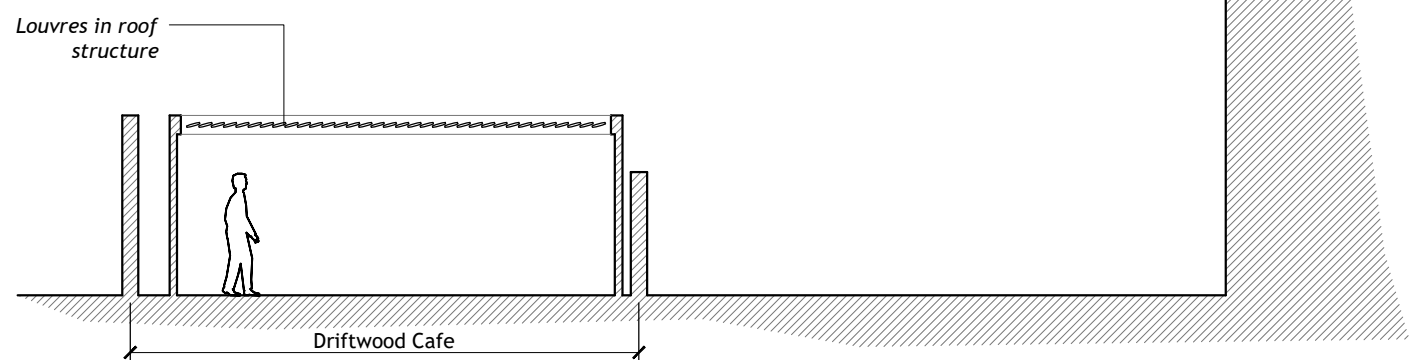


SECTION A-A
1:100

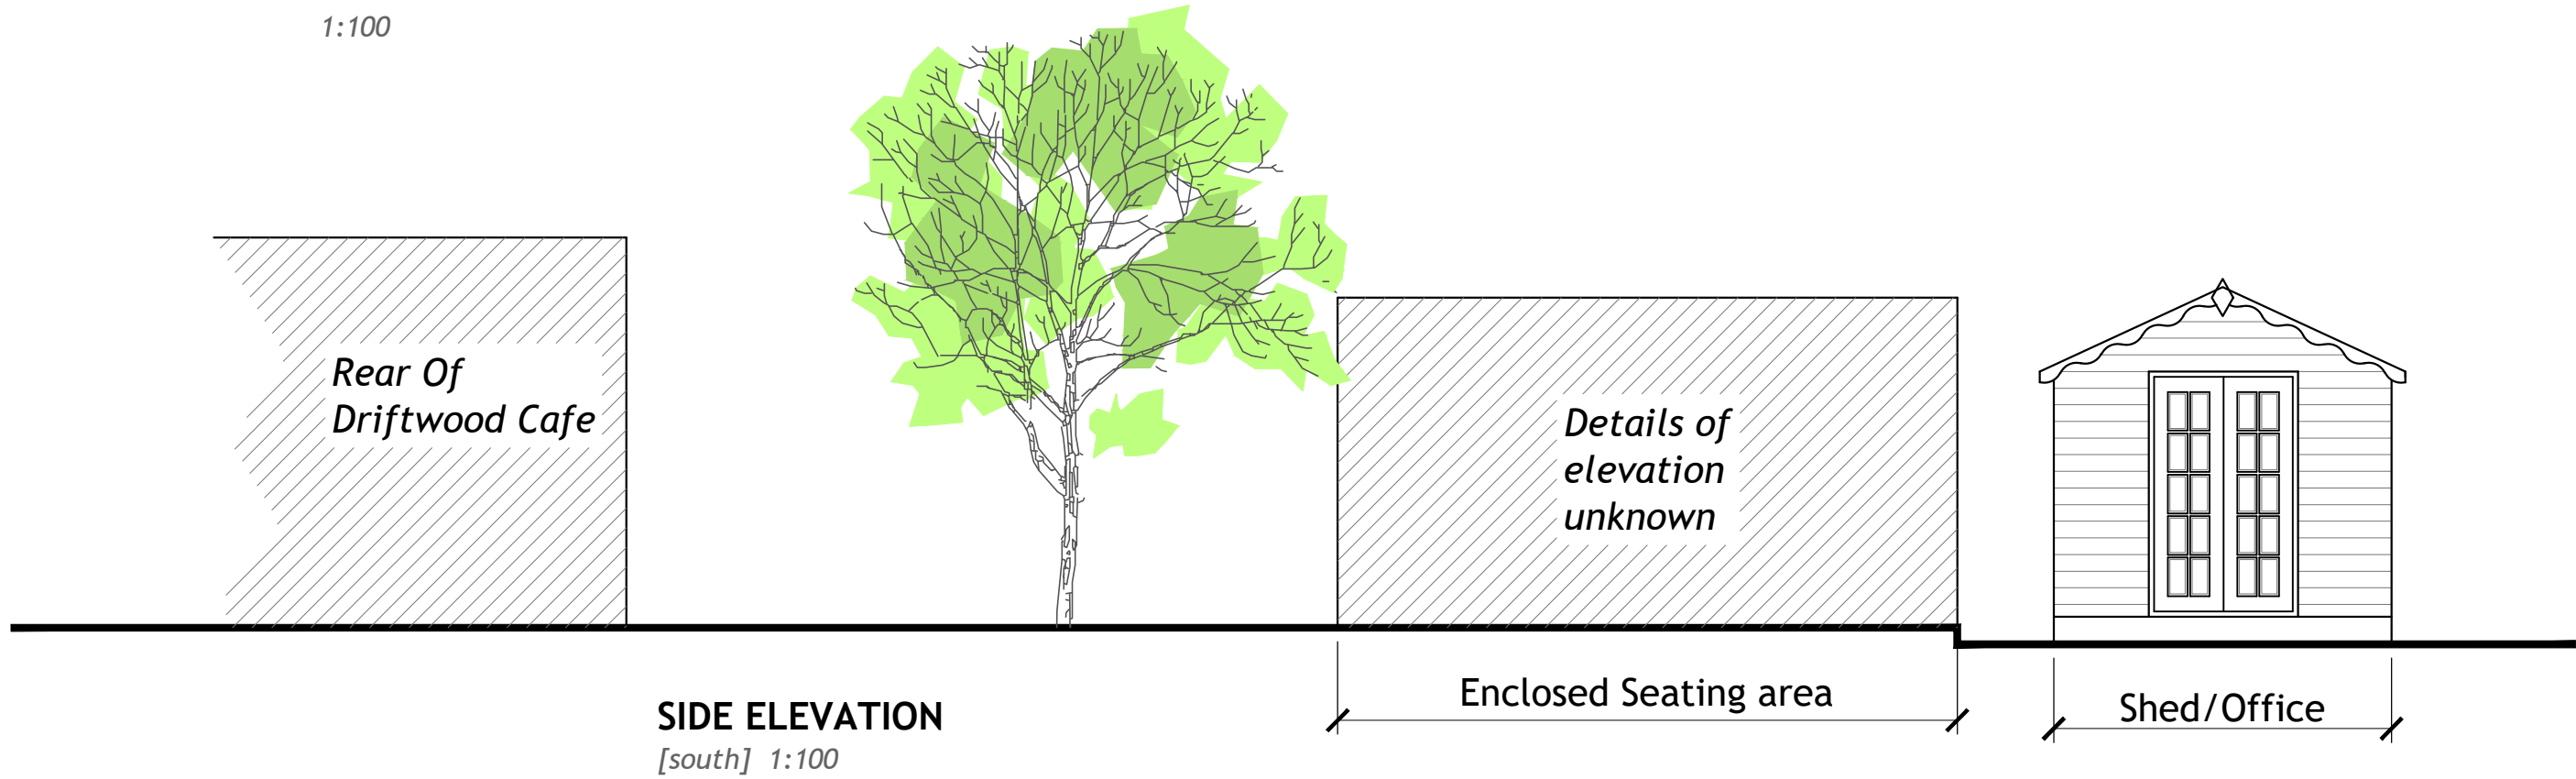

SIDE ELEVATION
[south] 1:100

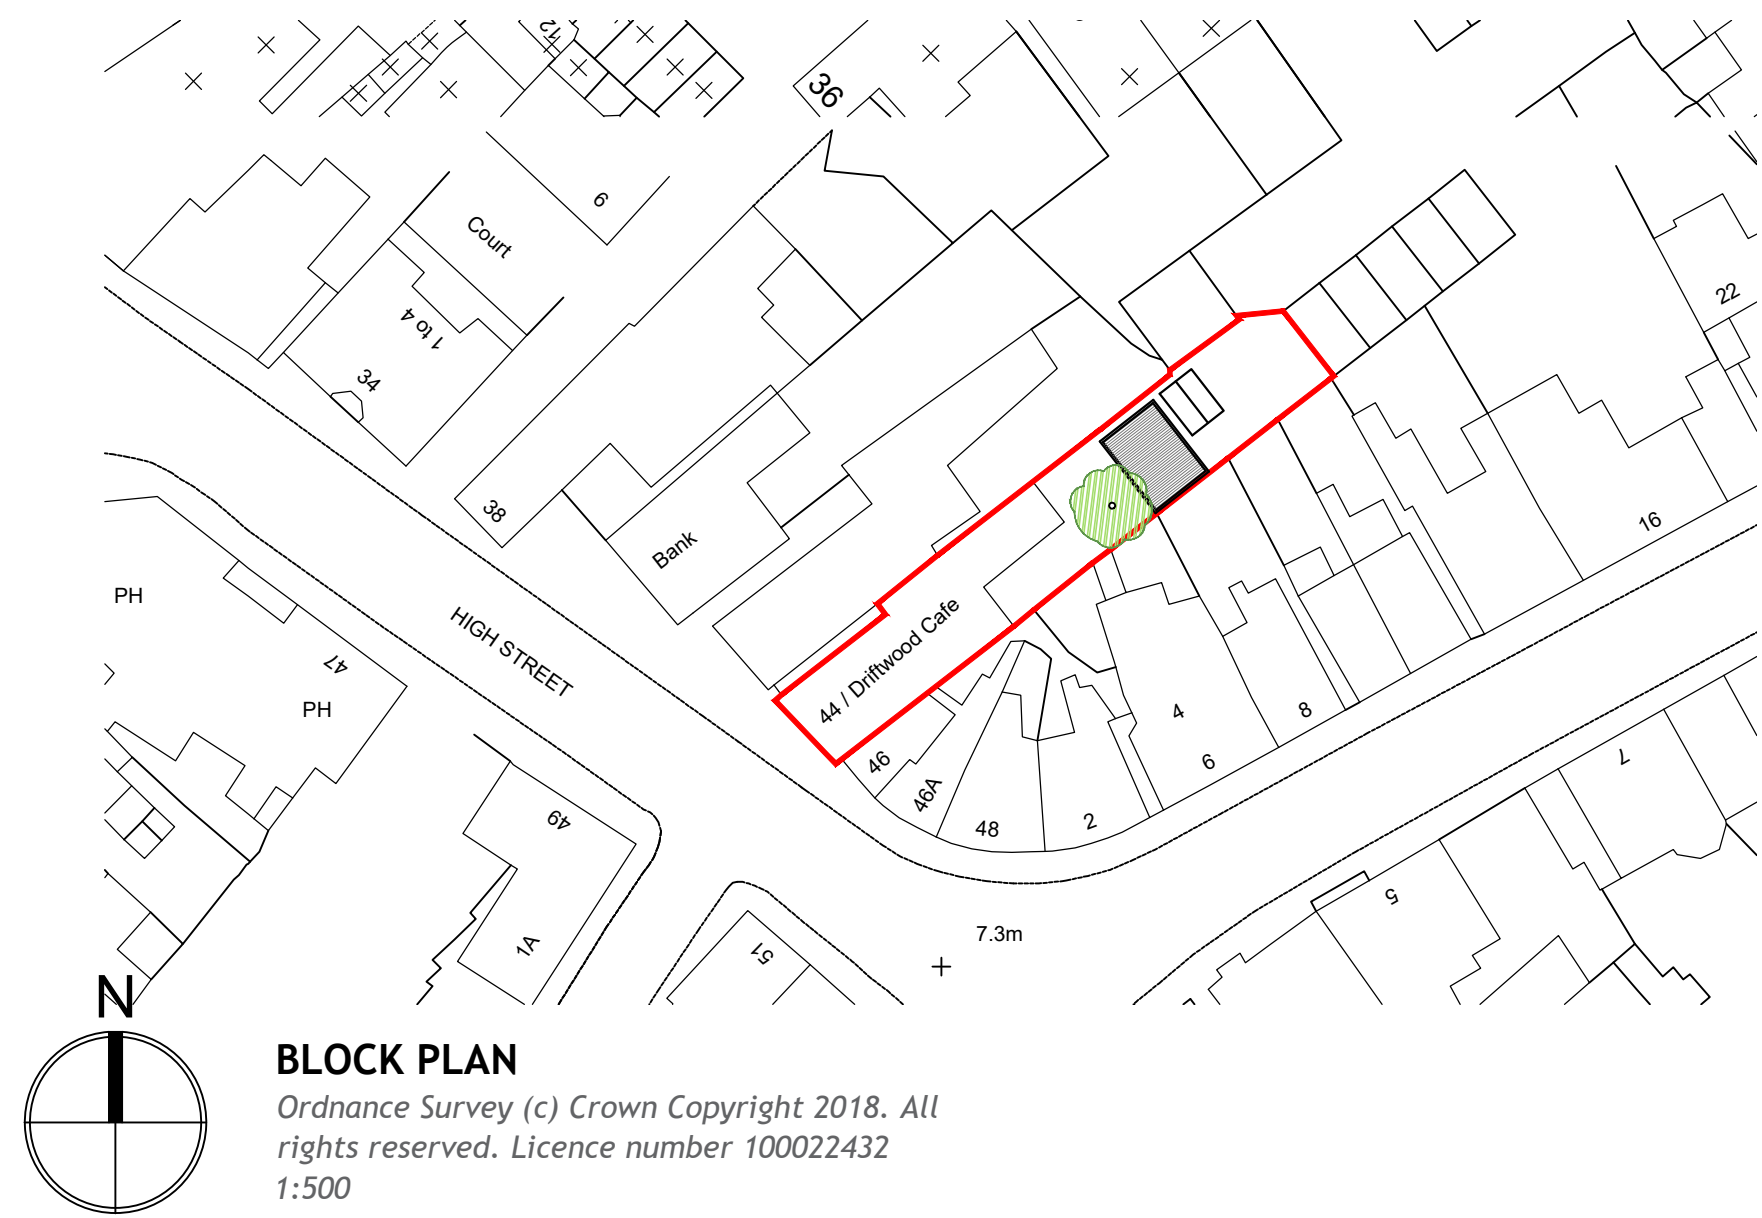

BLOCK PLAN
Ordnance Survey (c) Crown Copyright 2018. All rights reserved. Licence number 100022432
1:500

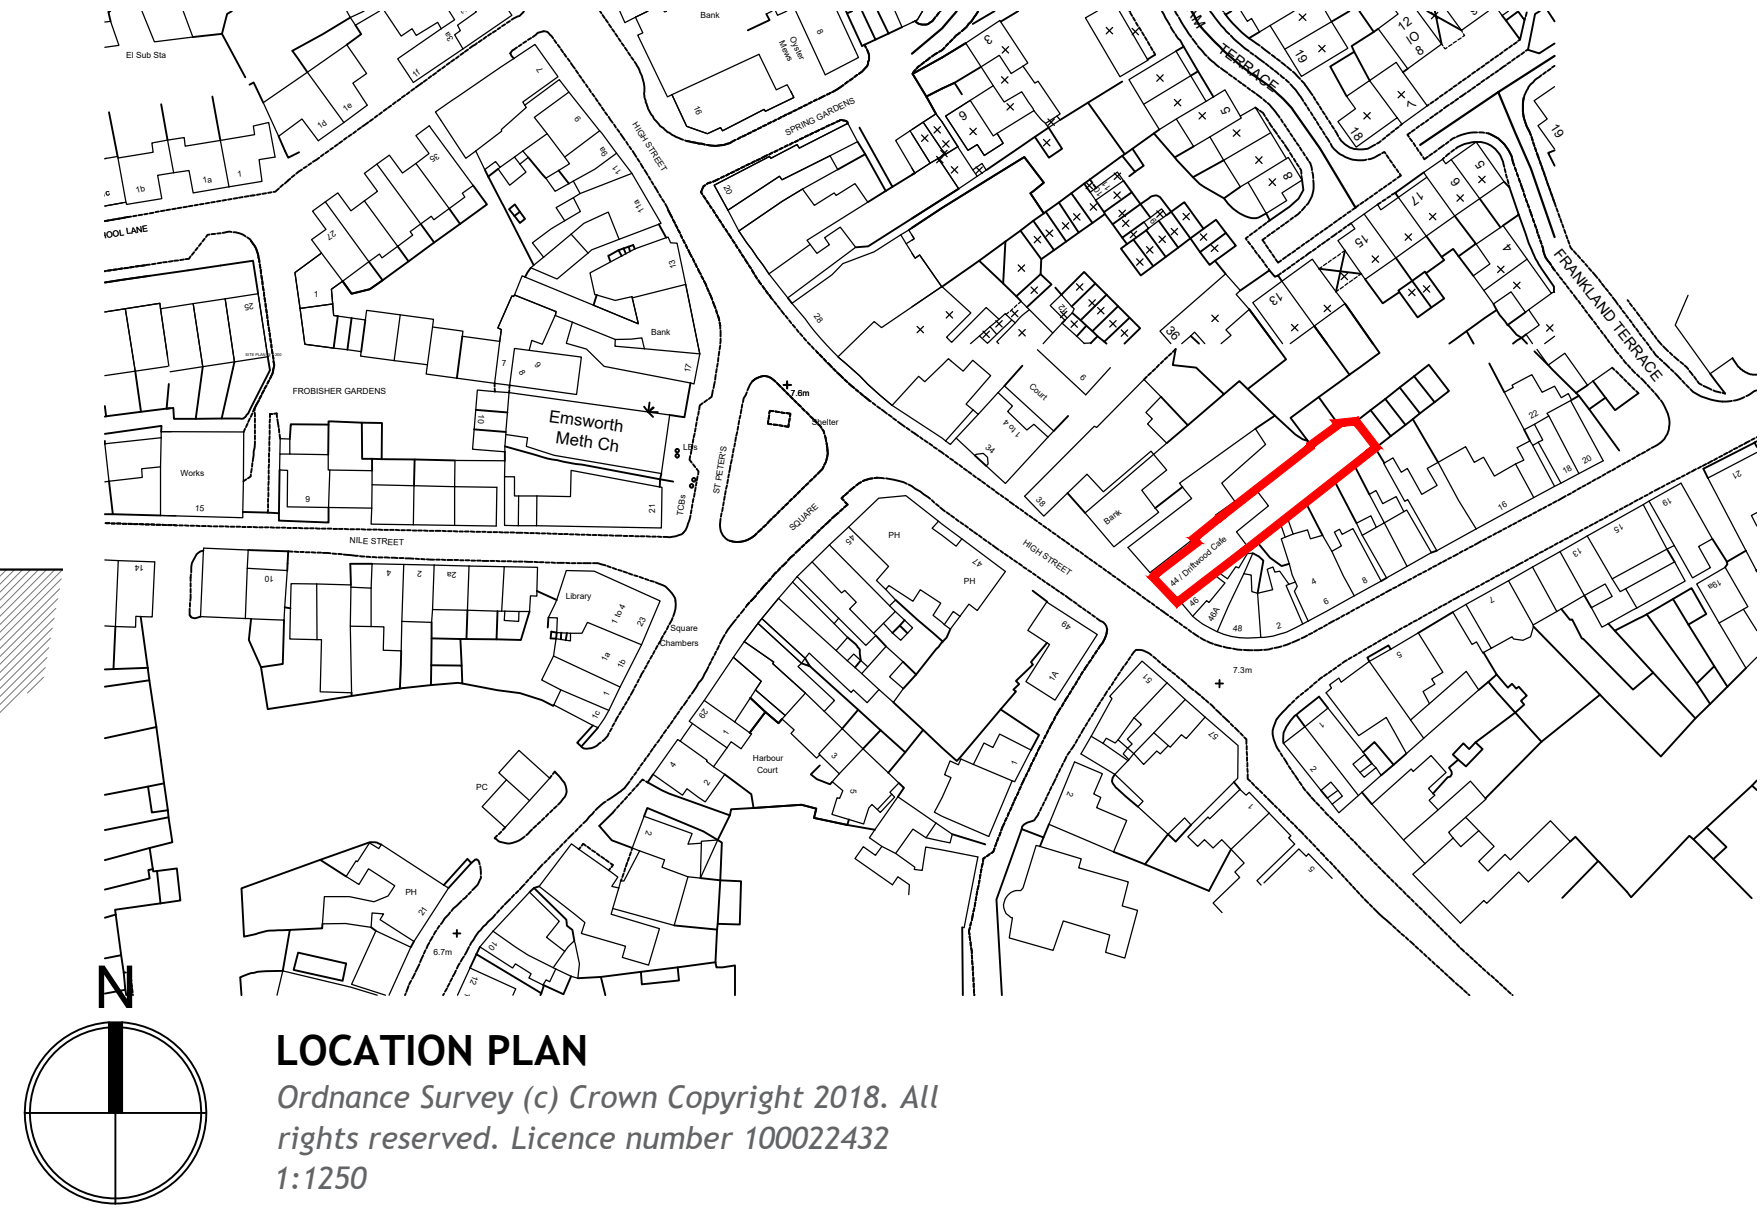

LOCATION PLAN
Ordnance Survey (c) Crown Copyright 2018. All rights reserved. Licence number 100022432
1:1250

NOTES:
Dimensions to be checked on site before commencing work. Any discrepancies shall be reported to the architect immediately.
Do not scale from these drawings except for planning purposes.
Use figured dimensions only.
Where applicable this drawing is to be read in conjunction with other consultants' drawings.
All drawings to be read in conjunction with specification and all other drawings including structural engineer and mechanical and electrical drawings / specification

C	15/05	REVISIONS TO DRAWINGS	TW
REV	DATE	AMENDMENT	DRAWN
hd architects www.hdarchitects.co.uk mail@hdarchitects.co.uk			
PROJECT Driftwood Cafe 44 Highstreet Emsworth, PO10 7BT PO10 7AW			
DRAWING As Built Plans As Built Elevations As Built Section As Built Location and Block Plan		SCALE as noted @A1	
DATE July 2018		DRAWN JF	
DRAWING NUMBER 18112-02		REVISION C	