




CAD

Critchley Architecture And Design Ltd.
Contact: 02392 474 919 | info@cad.online

The Old Brewery, 15E South Street, Havant, PO9 1BU

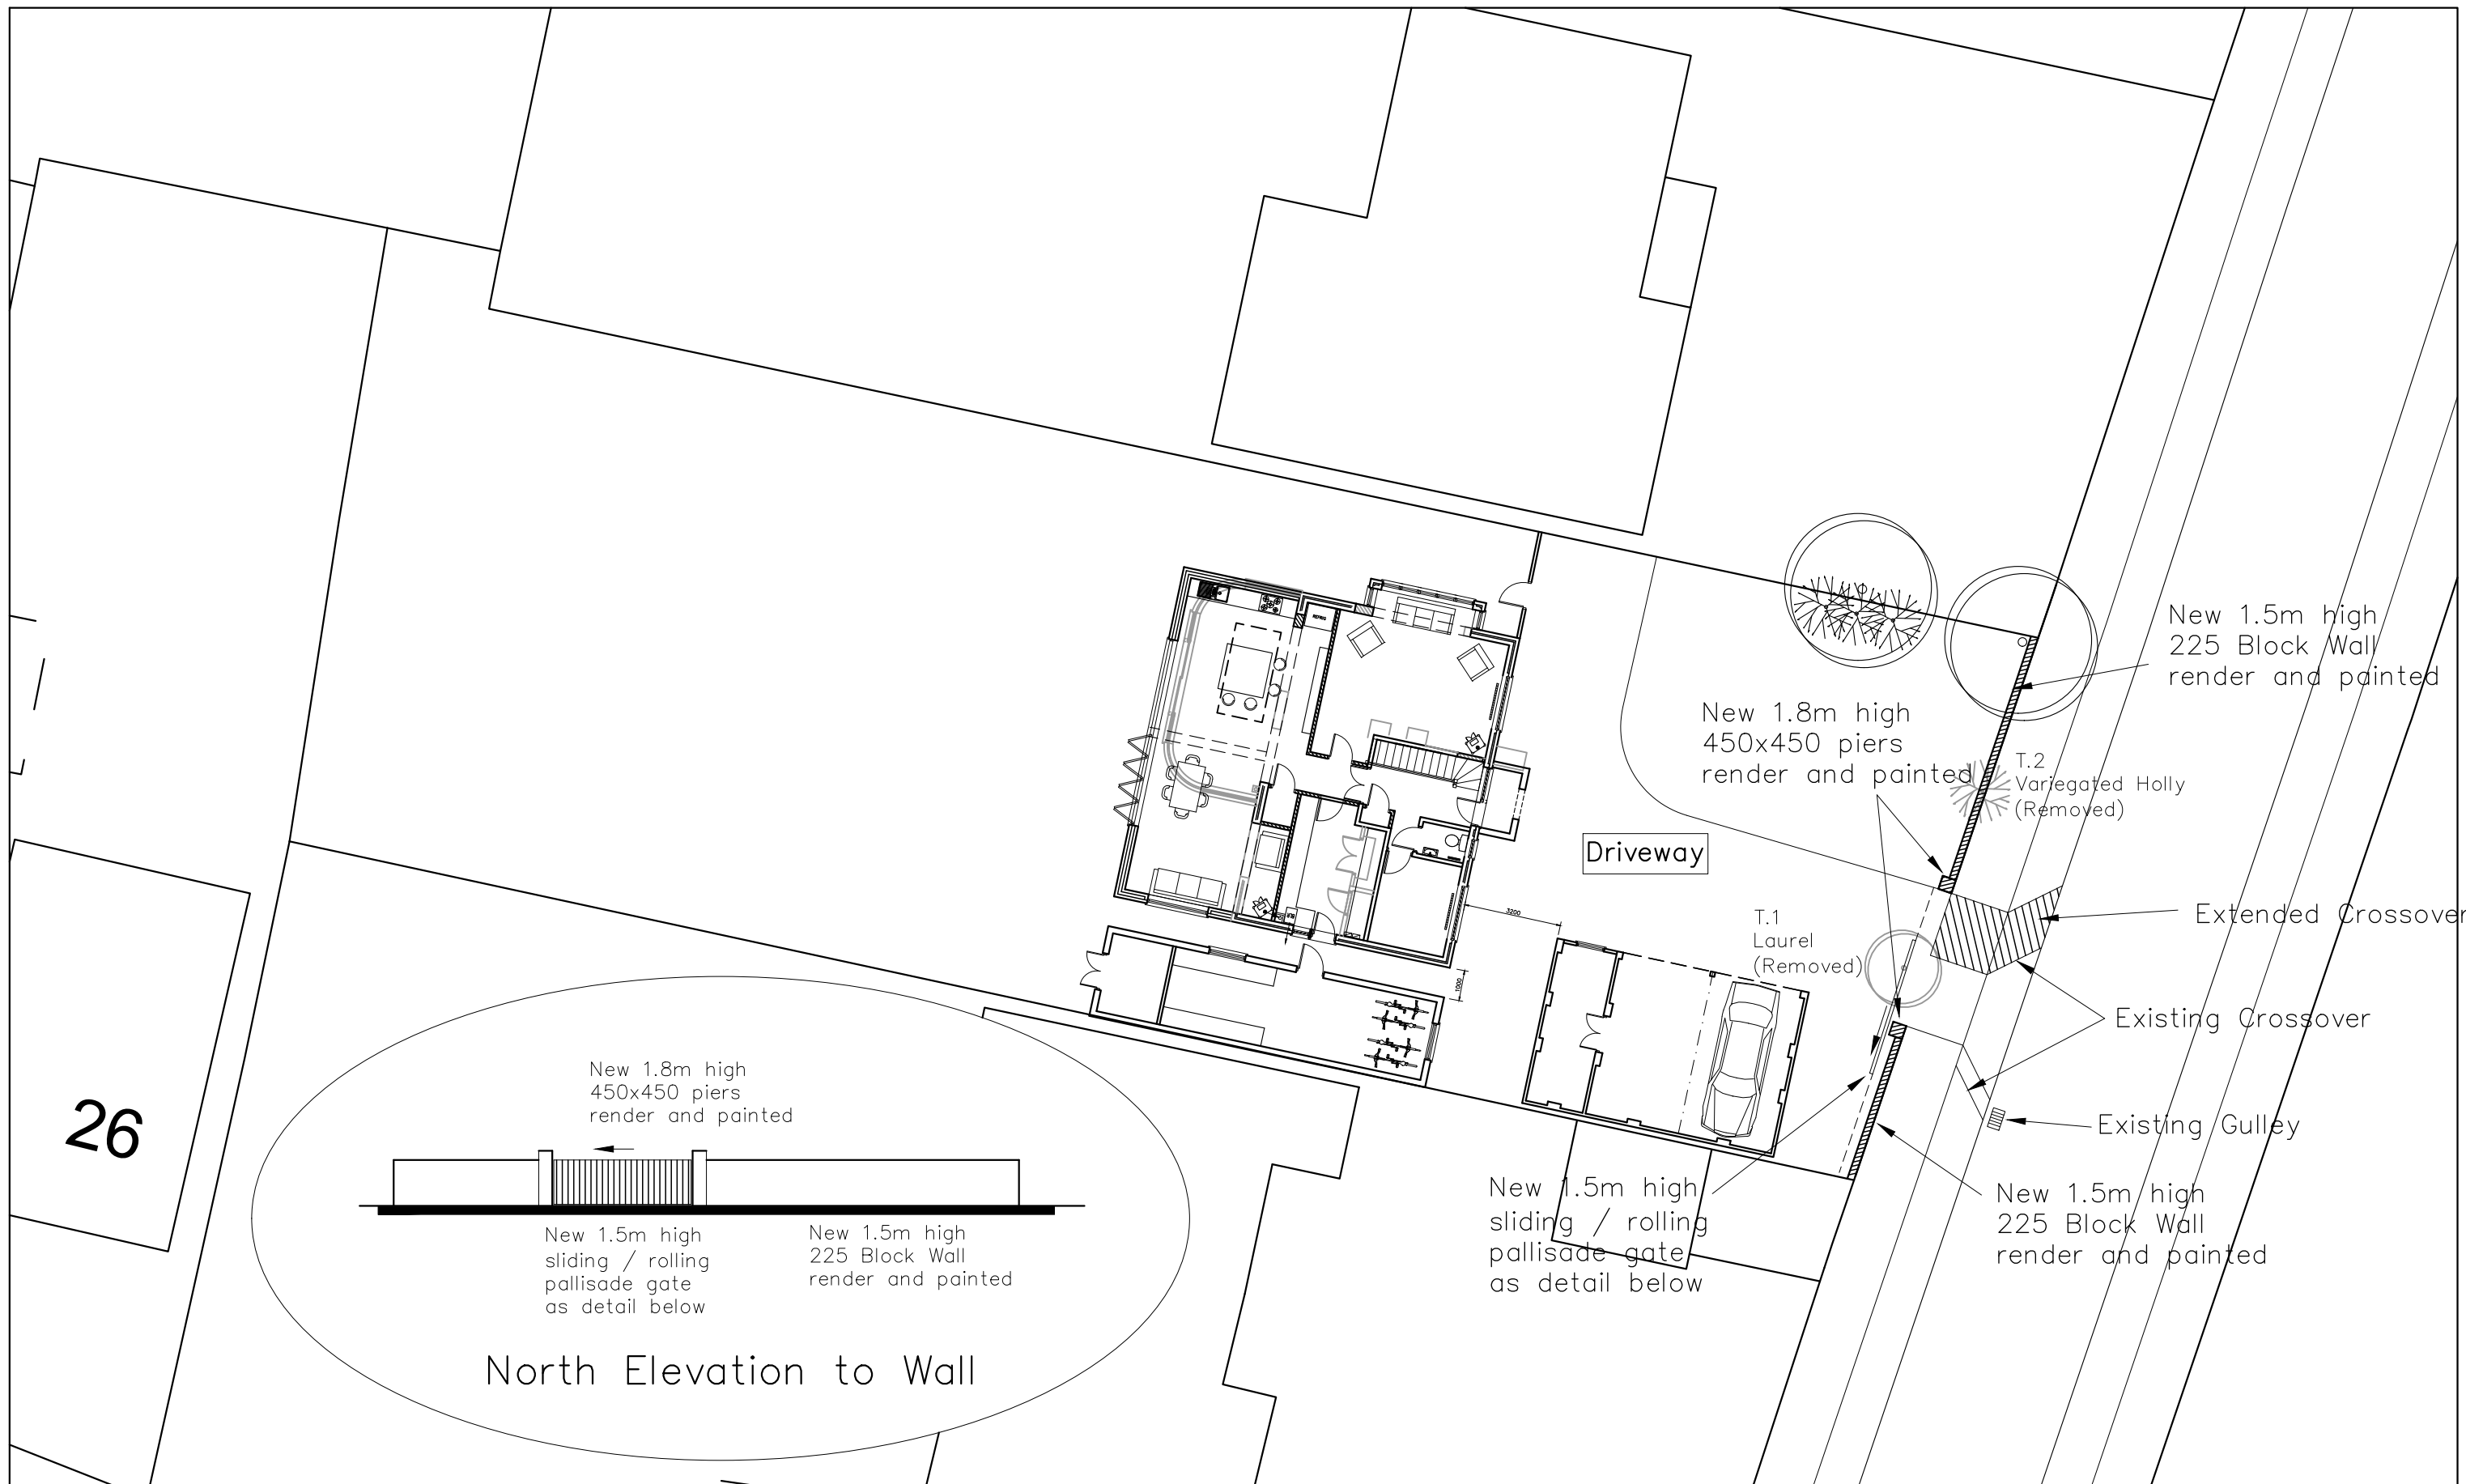

As Built Site Plan

Revisions

- a) Elevation added. 09/07/19
- b)
- c)
- d)

32 Victoria Ave
Hayling Island
PO11 9AJ

Scale A1=1:100, A3=1:200
Drawn CAL/MHC
03/07/19

1449-113^A

20m

40m

60m

80m