



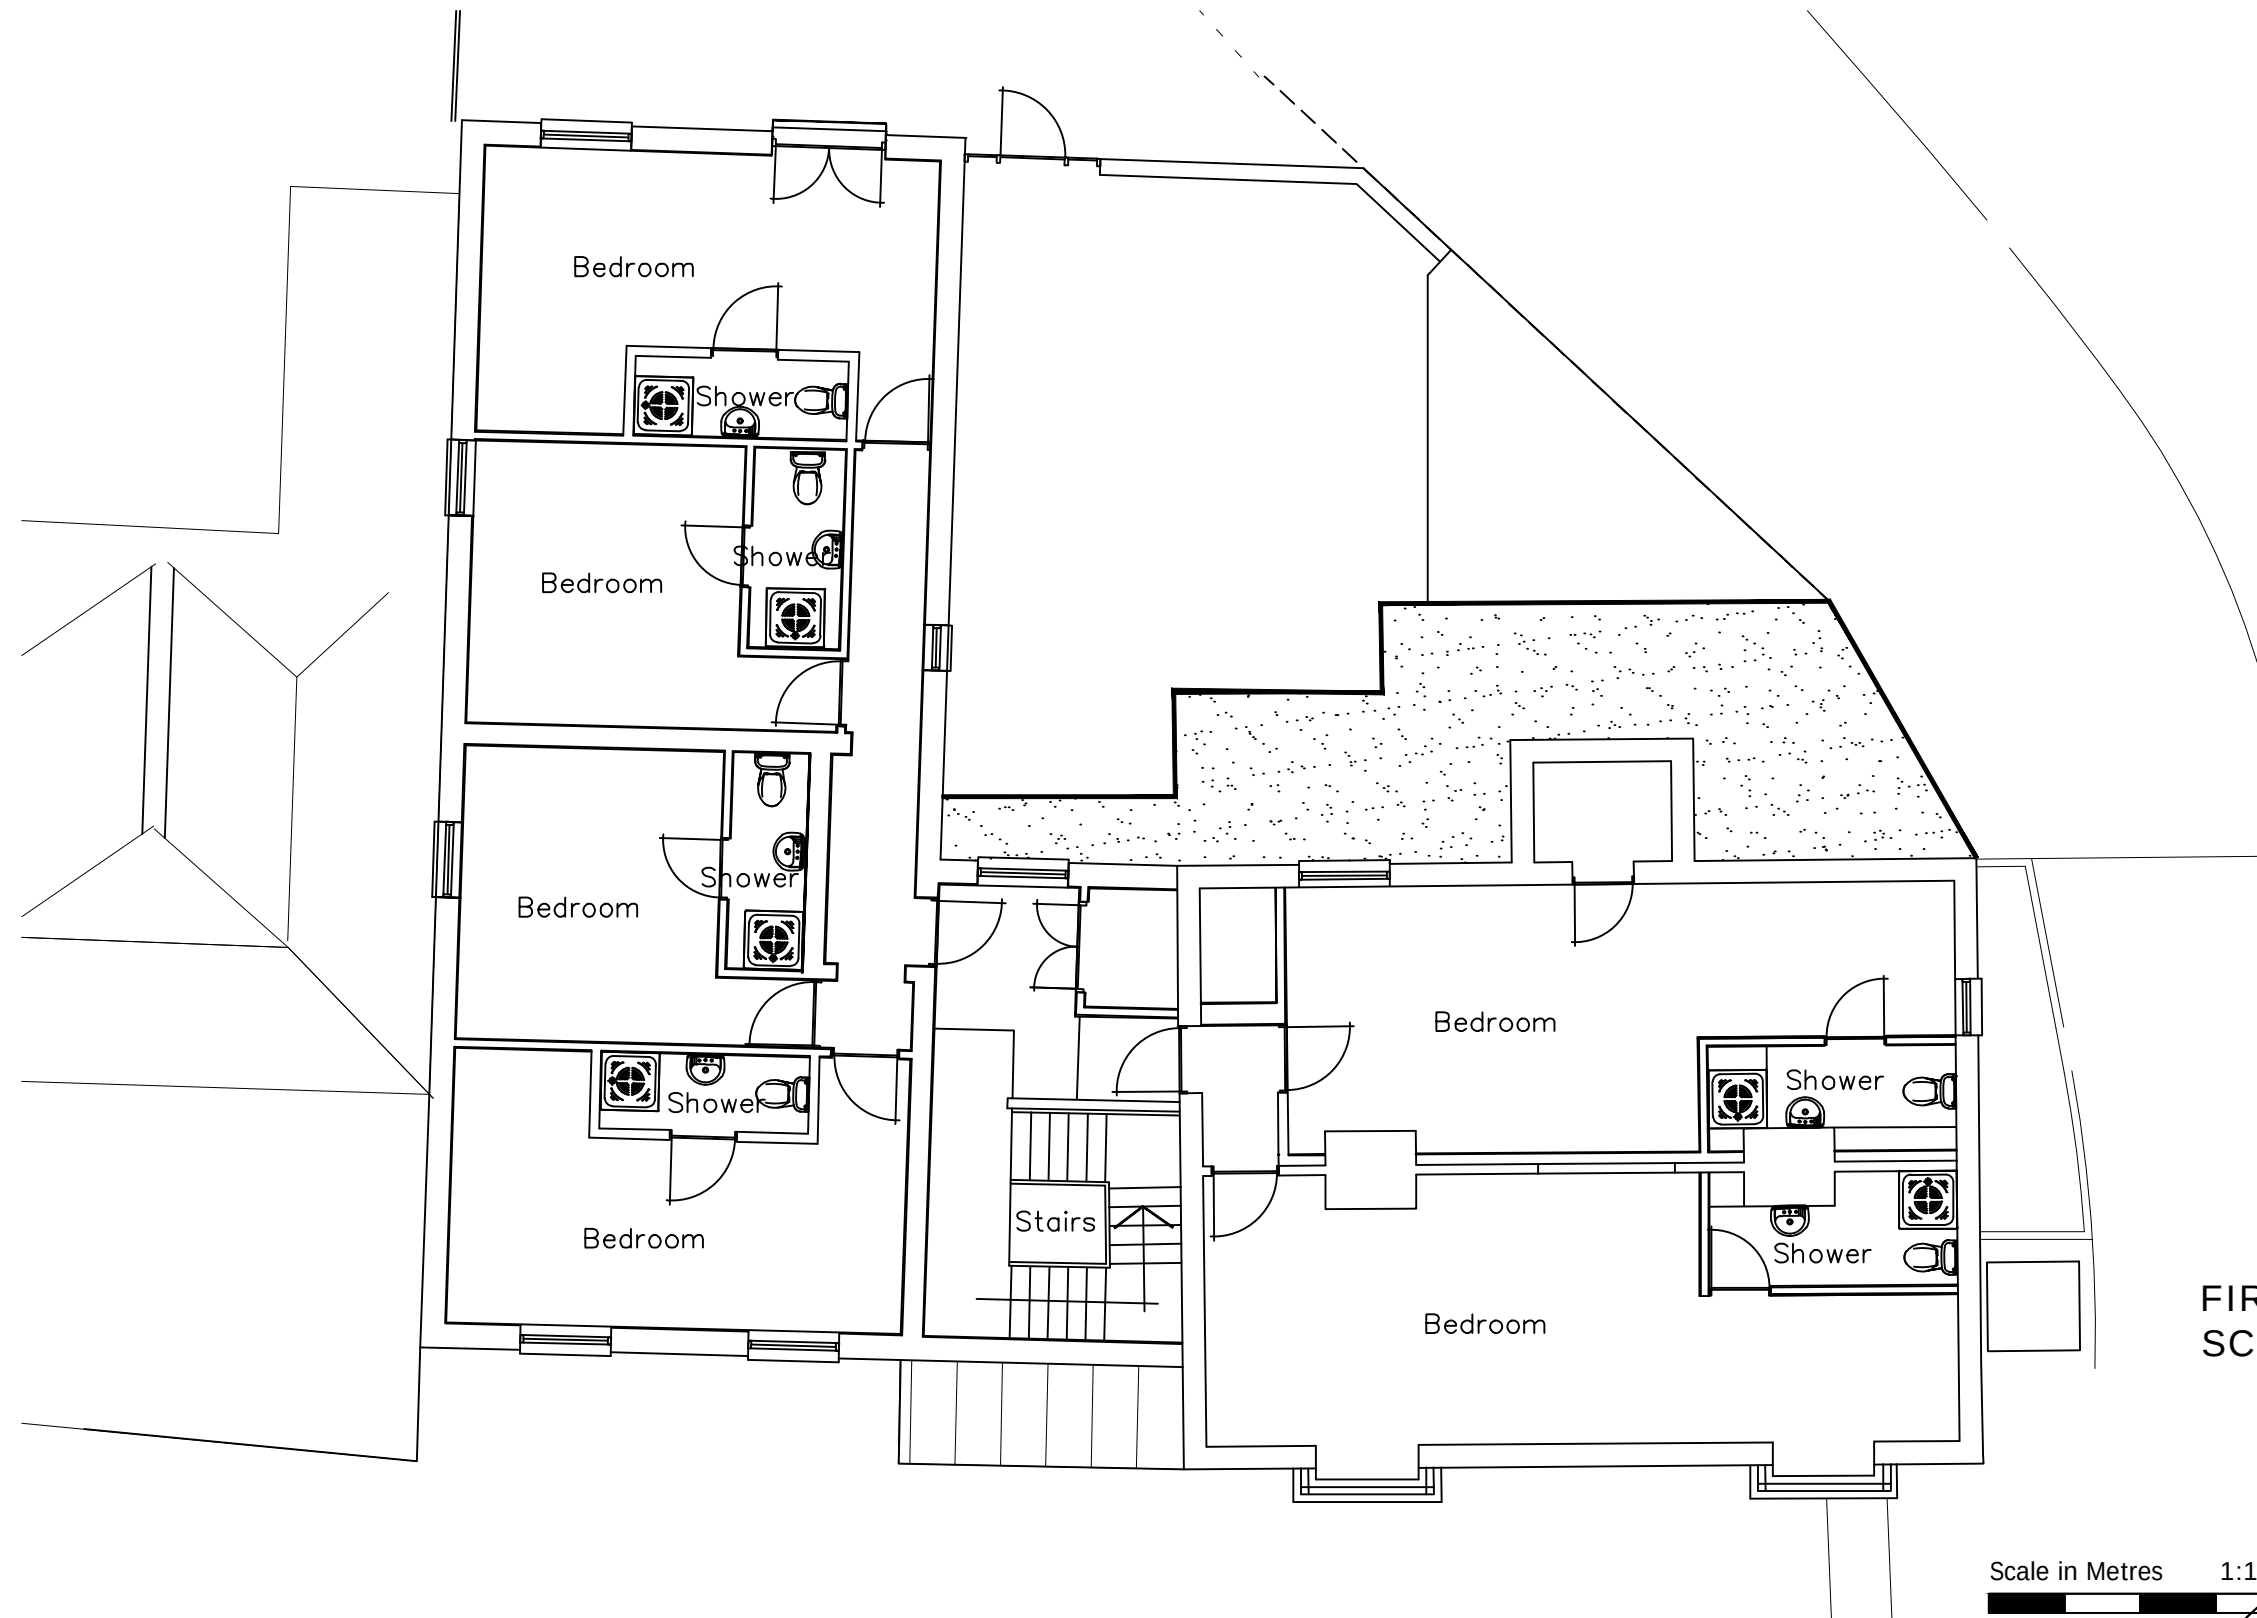

FIRST FLOOR LAYOUT
SCALE 1:100

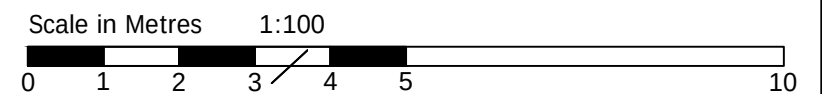

Notes: The design and construction of this project shall be in accordance with the current Building Regulations & NHBC Standards. These notes & drawings have been prepared solely for the purpose of Planning & Building Regulation approval. Do not scale from this drawing unless for Planning purposes. All dimensions to be checked on-site and any alterations to be approved by the Architect and/or client prior to any work commencing. Ordnance Survey Licence No: 100047591 This drawing to be copyright and to be read in conjunction with all other drawings	Revisions:	Key:	Drawing Details: AS BUILT DRAWING First Floor Layout <table><tr><td>Project No:</td><td>898</td><td>Drawing No:</td><td>19</td><td>Rev No:</td><td></td></tr><tr><td>Scale:</td><td>1:100 @ A3</td><td>Drawn:</td><td>BWH</td><td>Date:</td><td>20/06/19</td></tr></table>	Project No:	898	Drawing No:	19	Rev No:		Scale:	1:100 @ A3	Drawn:	BWH	Date:	20/06/19	Client Name: M Forfar Ltd	Project Address: The Wellington Public House 73 London Road Waterlooville PO7 7EX	 B H ARCHITECTURE Ltd Heath Cottage Newlands Lane Purbrook Waterlooville Hants PO7 5SQ Tel: 023 9223 2322 Mob: 07747 771808 E-mail:bernard@bernardharding.com
Project No:	898	Drawing No:	19	Rev No:														
Scale:	1:100 @ A3	Drawn:	BWH	Date:	20/06/19													