


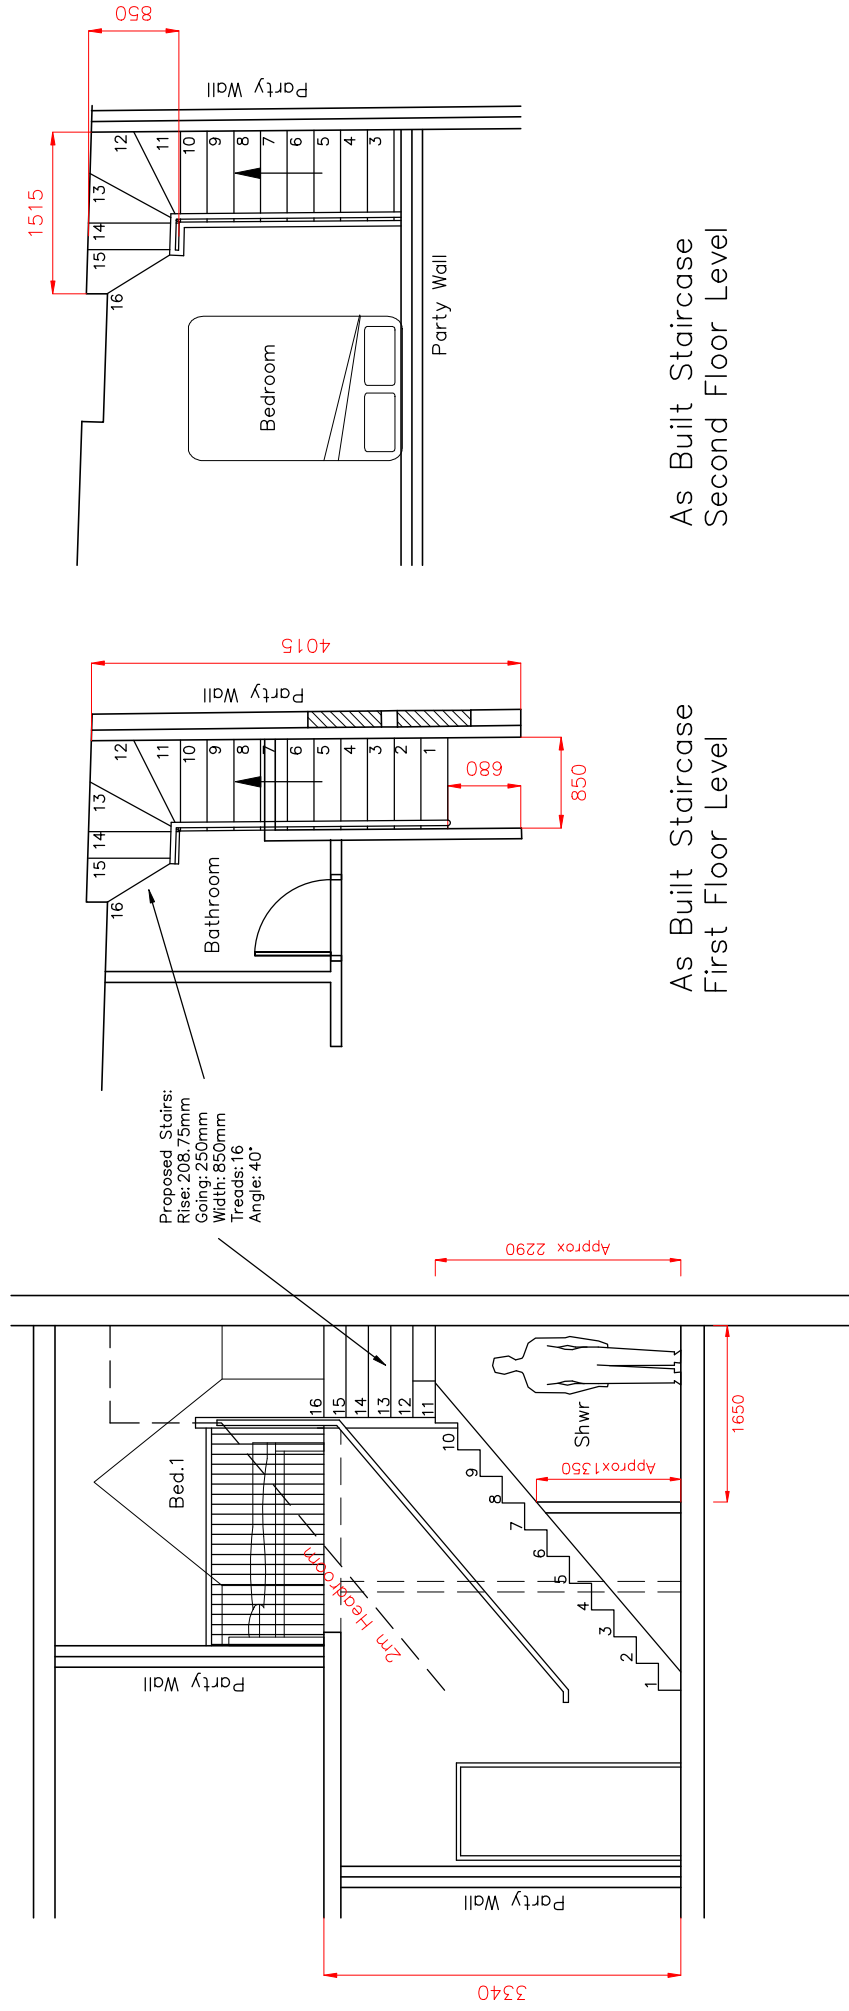

As Built Staircase
Second Floor Level

As Built Staircase
First Floor Level



Critchley Architecture And Design Ltd.
Contact: 03302 474 999 | info@cad.co.uk
The Old Brewery, 55 South Street, Havant, PO9 1BU



Flat 1 Staircase Details: As Built 2019

Revisions	Note/Date/Initial
a)	
b)	
c)	
d)	

Flats 1-5
White Hart Court
1 East Street
Havant
PO9 1AA

Scale A1=1:25, A3=1:50
Drawn SAR
Date 29/03/19

17094-661
0