

AS BUILT

NOTES:

Dimensions to be checked on site before commencing work.
Any discrepancies shall be reported to the architect
immediately.

Do not scale from these drawings except for planning purposes.

Use figured dimensions only.

Where applicable this drawing is to be read in conjunction with other consultants' drawings.

All drawings to be read in conjunction with specification and all other drawings including structural engineer and mechanical and electrical drawings / specification




GROUND FLOOR PLAN

1:100

ROOF PLAN

1:100

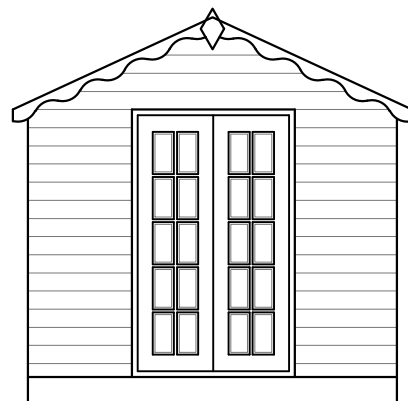


EAST ELEVATION (SHED)

1:100


SOUTH ELEVATION (SHED)

1:100

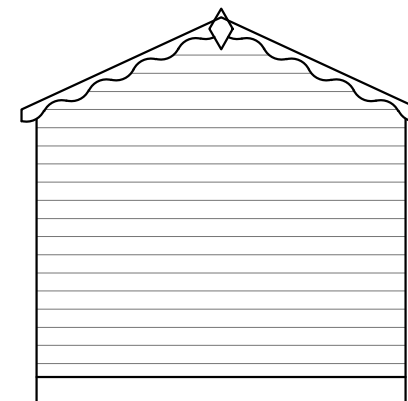


NORTH ELEVATION (SHED)

1:100

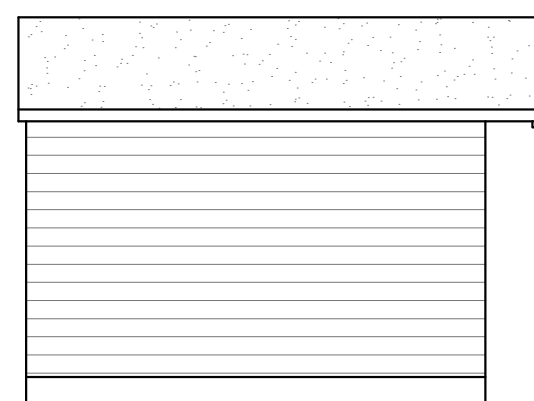


WEST ELEVATION (SHED)

1:100

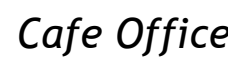


FLOOR PLAN (SHED)

1:100

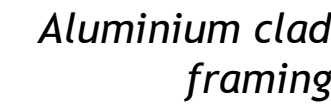

REAR ELEVATION

[east] 1:100

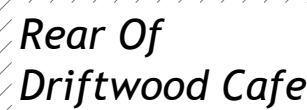

SIDE ELEVATION

[south] 1:100

hd
architects

Ellyer Davies Architects Ltd
The Old Flour Mill,
Ramsworth, PO10 7BT
1243 370 715

www.hdarchitects.co.uk mail@hdarchitects.co.uk

Driftwood Cafe
44 Highstreet
Emsworth
PO10 7AW

Driftwood Cafe
44 Highstreet
Emsworth
PO10 7AW

DRAWING
As Built Plans
As Built Elevations
Shed Elevations

noted @A1

DATE July 2018

AWN JF

DRAWING NUMBER	REVISION
18112-03	B