



Fit Point A



Replace timber support
using seasoned oak.
Insert brick to fill void.
Repoint brick
Refer to specs and method
statements.

Replace oak lintel with
lintel to match, seasoned oak
Repoint brickwork as per specs
and method statements.

First Floor Plan

Notes


1. The survey was carried out in December 2018.
2. Grid and levels based OS national grid. Obtained through GPS observation.
3. All values are displayed in metres.

Survey Key

BH	FLOOR TO BEAM HEIGHT
BL	UNDERSIDE OF BEAM LEVEL
C	CIL LEVEL
C-H	CILL TO HEAD HEIGHT
CL	COVER LEVEL
COL	COLUMN
CT	CEILING TYPE
CH	CHANGING OF HEIGHT
+FL	FLOOR LEVEL
FT	FLOOR TYPE
GV	GAS VALVE
GY	GULLY
H	HEAD LEVEL
HD	HANDHOLE COVER
RAD	RADIATOR
RS	ROLLER SHUTTER
RWP	RAIN WATER PIPE
S/C	SLOPED CEILING
SCL	SLOPED CEILING LEVEL
+SF	SOFFIT LEVEL
SP	SIGN POST
SV	STOP VALVE
TS	TACTILE PAVING
TW	TOWARD TAIL
TW	TOP OF WALL LEVEL
	CEILING HEIGHT
	FALSE CEILING HEIGHT
	SLIDING DOOR

ISSUE/ REVISION

	Rev	Date	Status/ Amendment	Drawn	Checked
---	-----	------	-------------------	-------	---------

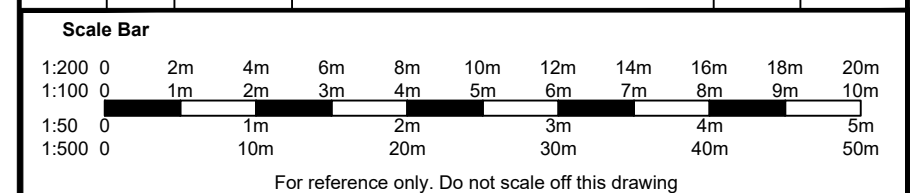

T: 01525 300721 E: info@besgeo.co.uk W: www.besgeo.co.uk

 Client:

Project: **The Manor House,
Bedhampton.**

Title: **Basement & First Floor Plans**

Sheet Number:

Status: **Draft**

Checked: **BS**

Drawn: **CE**

Date: 23/01/2019 Scale: 1:50 @ A1

Project No: **BES18190** Drg No: **3** Rev: **B**

TOPOGRAPHICAL SURVEYS GPS MEASURED BUILDING SURVEYS
3D LASER SCANNING AS-BUILT SURVEYS AREA MEASUREMENTS