



NOTE
1. Refer to following drawings
Dwg No 10 Foundations
" " 12 First Floor
" " 13 Roof Plan

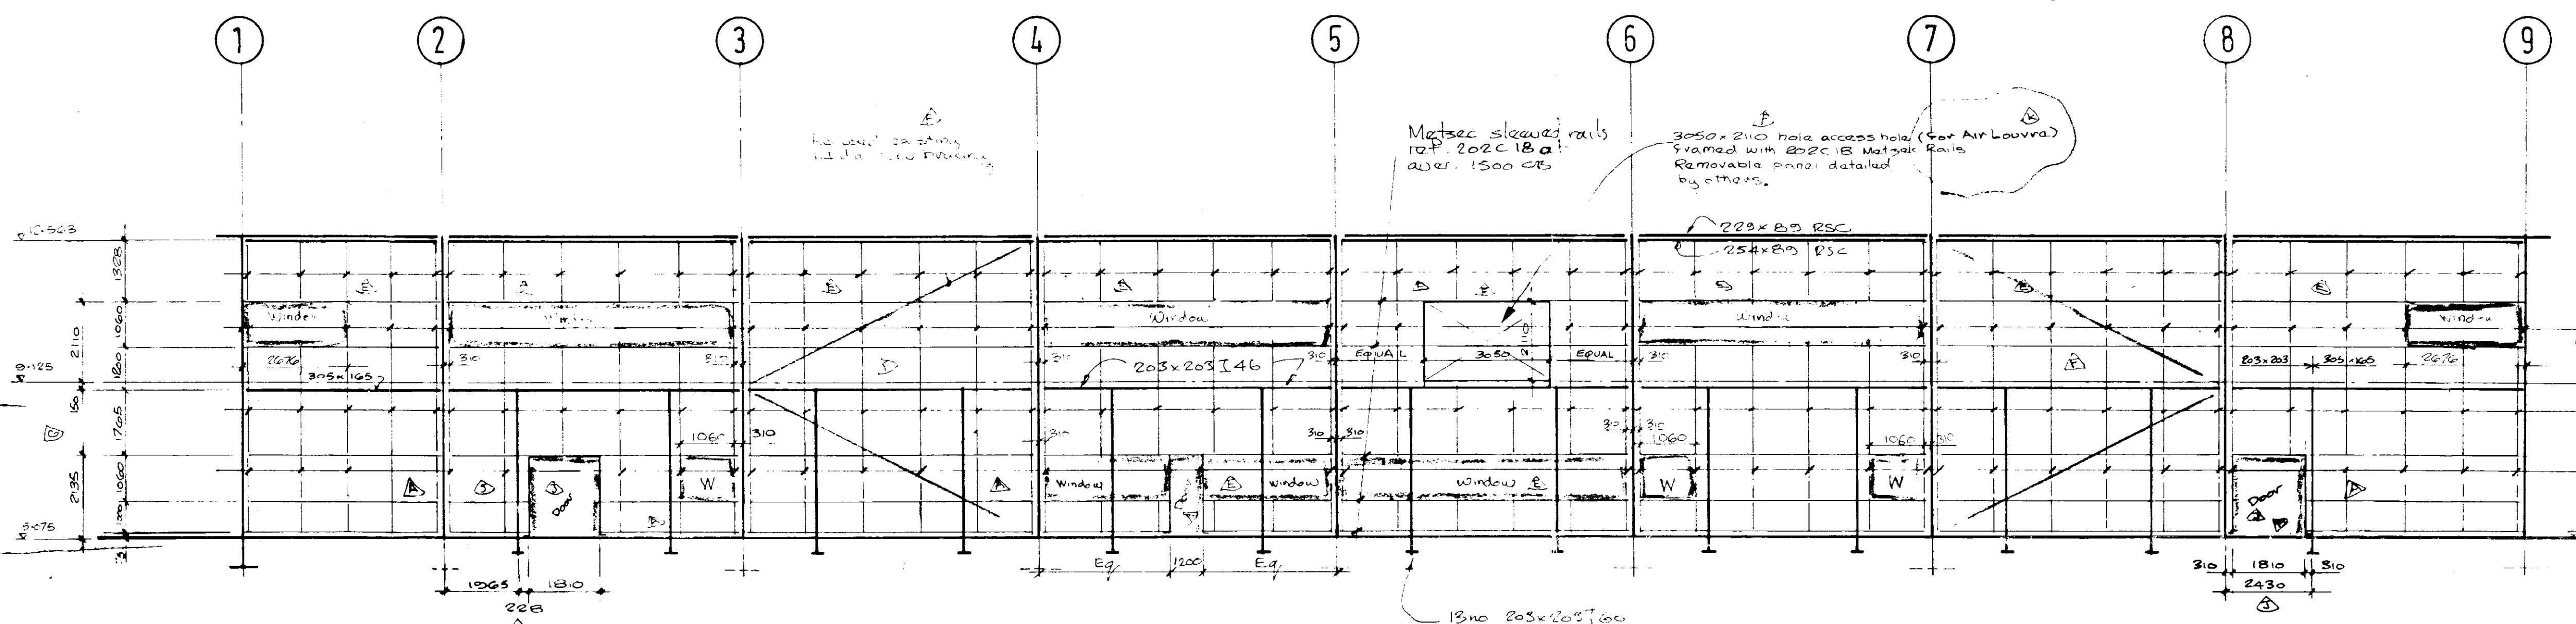


(GRID-A): WEST ELEVATION

Metsac sleeved 'C' section rails complete with vertical zed rails at 1500c/c appear. Provide all necessary proping wire ties etc. to manufacturers requirements.

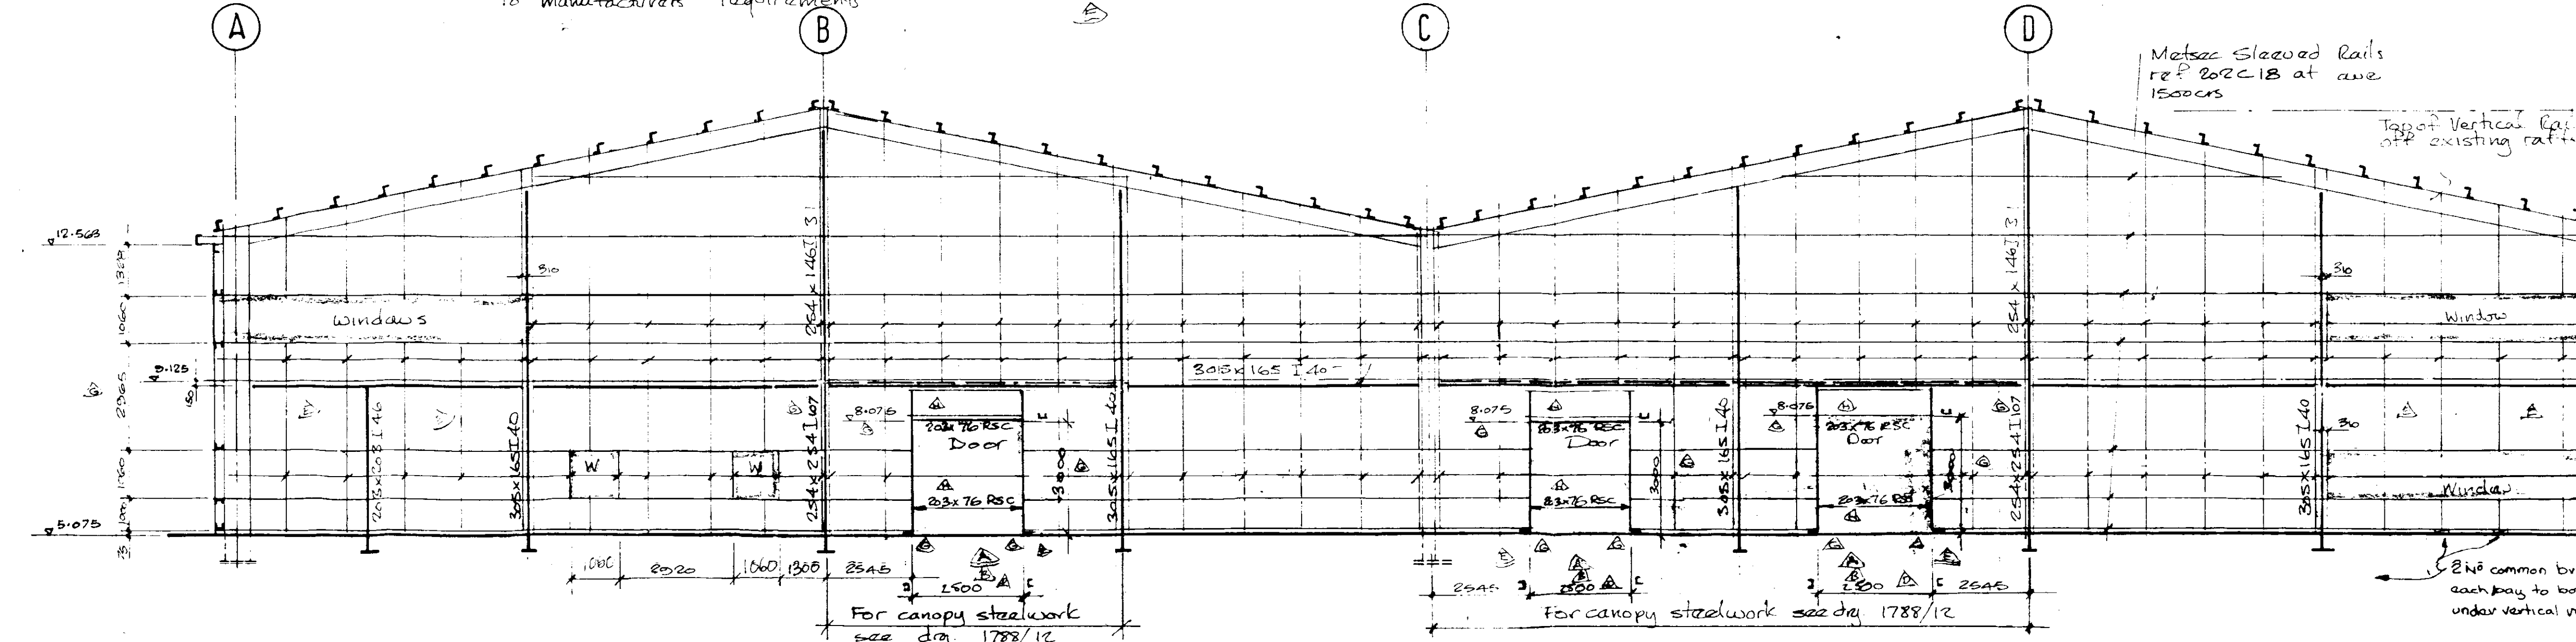


(GRID-9): SOUTH ELEVATION

Vertical mini-zed rail positioned to suit architects requirement.

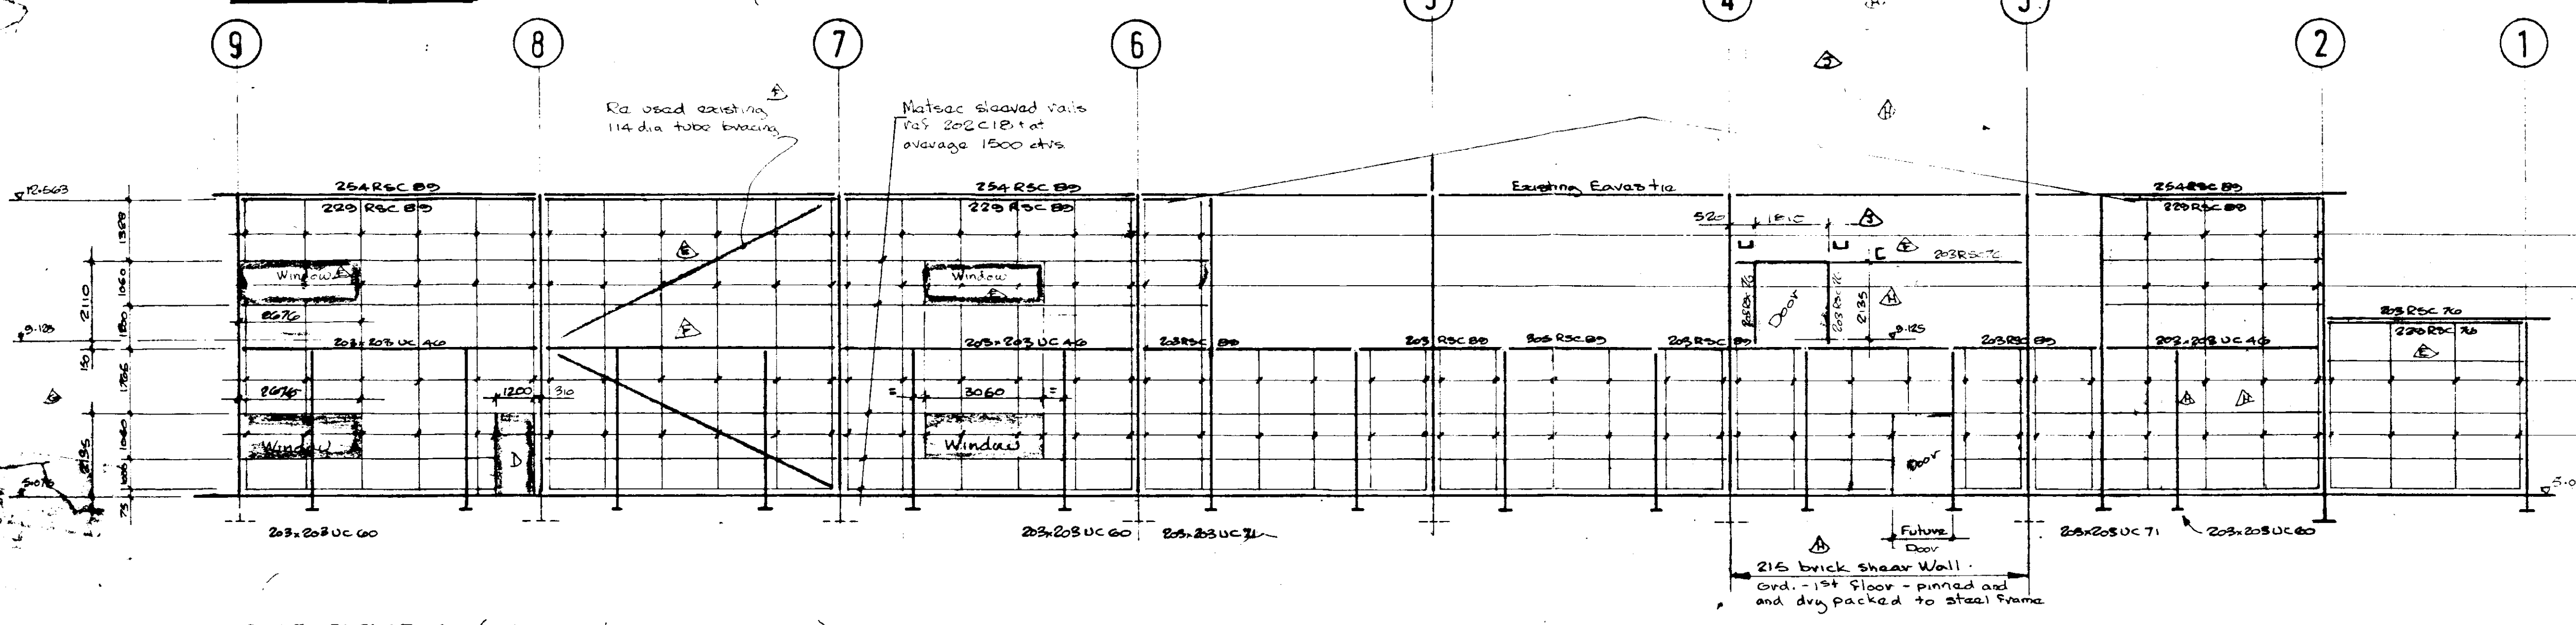


(GRID-E): EAST ELEVATION

(Note as West Elevation above)

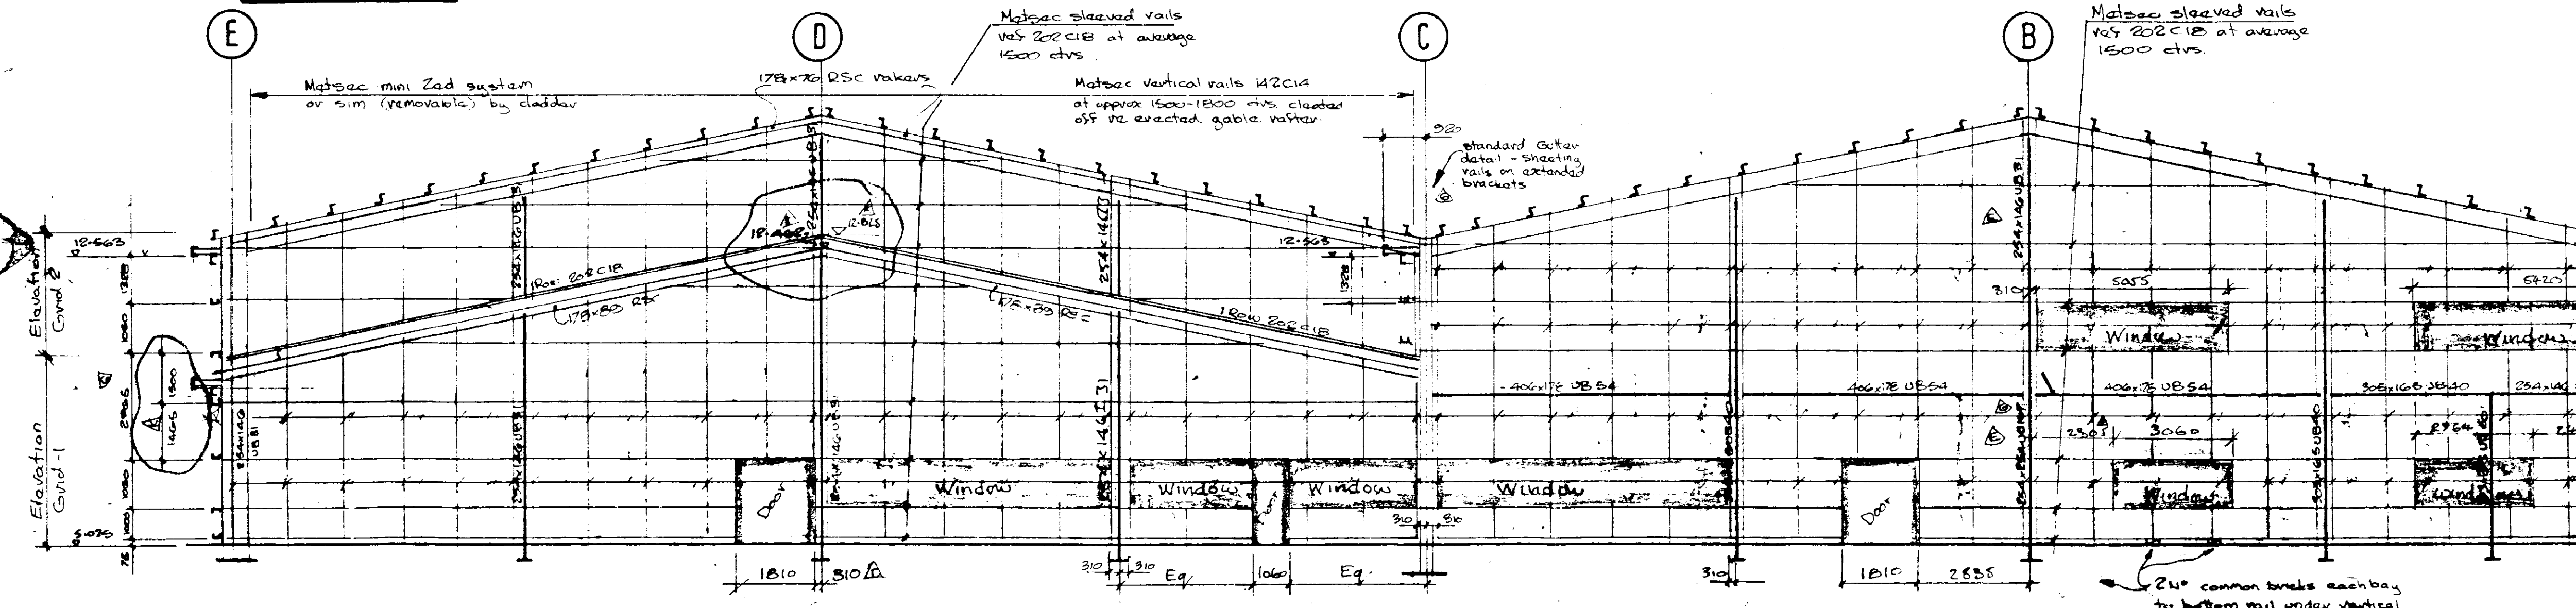

(GRID-1): NORTH ELEVATION

Vertical mini-zed rails positioned to suit architects requirements.

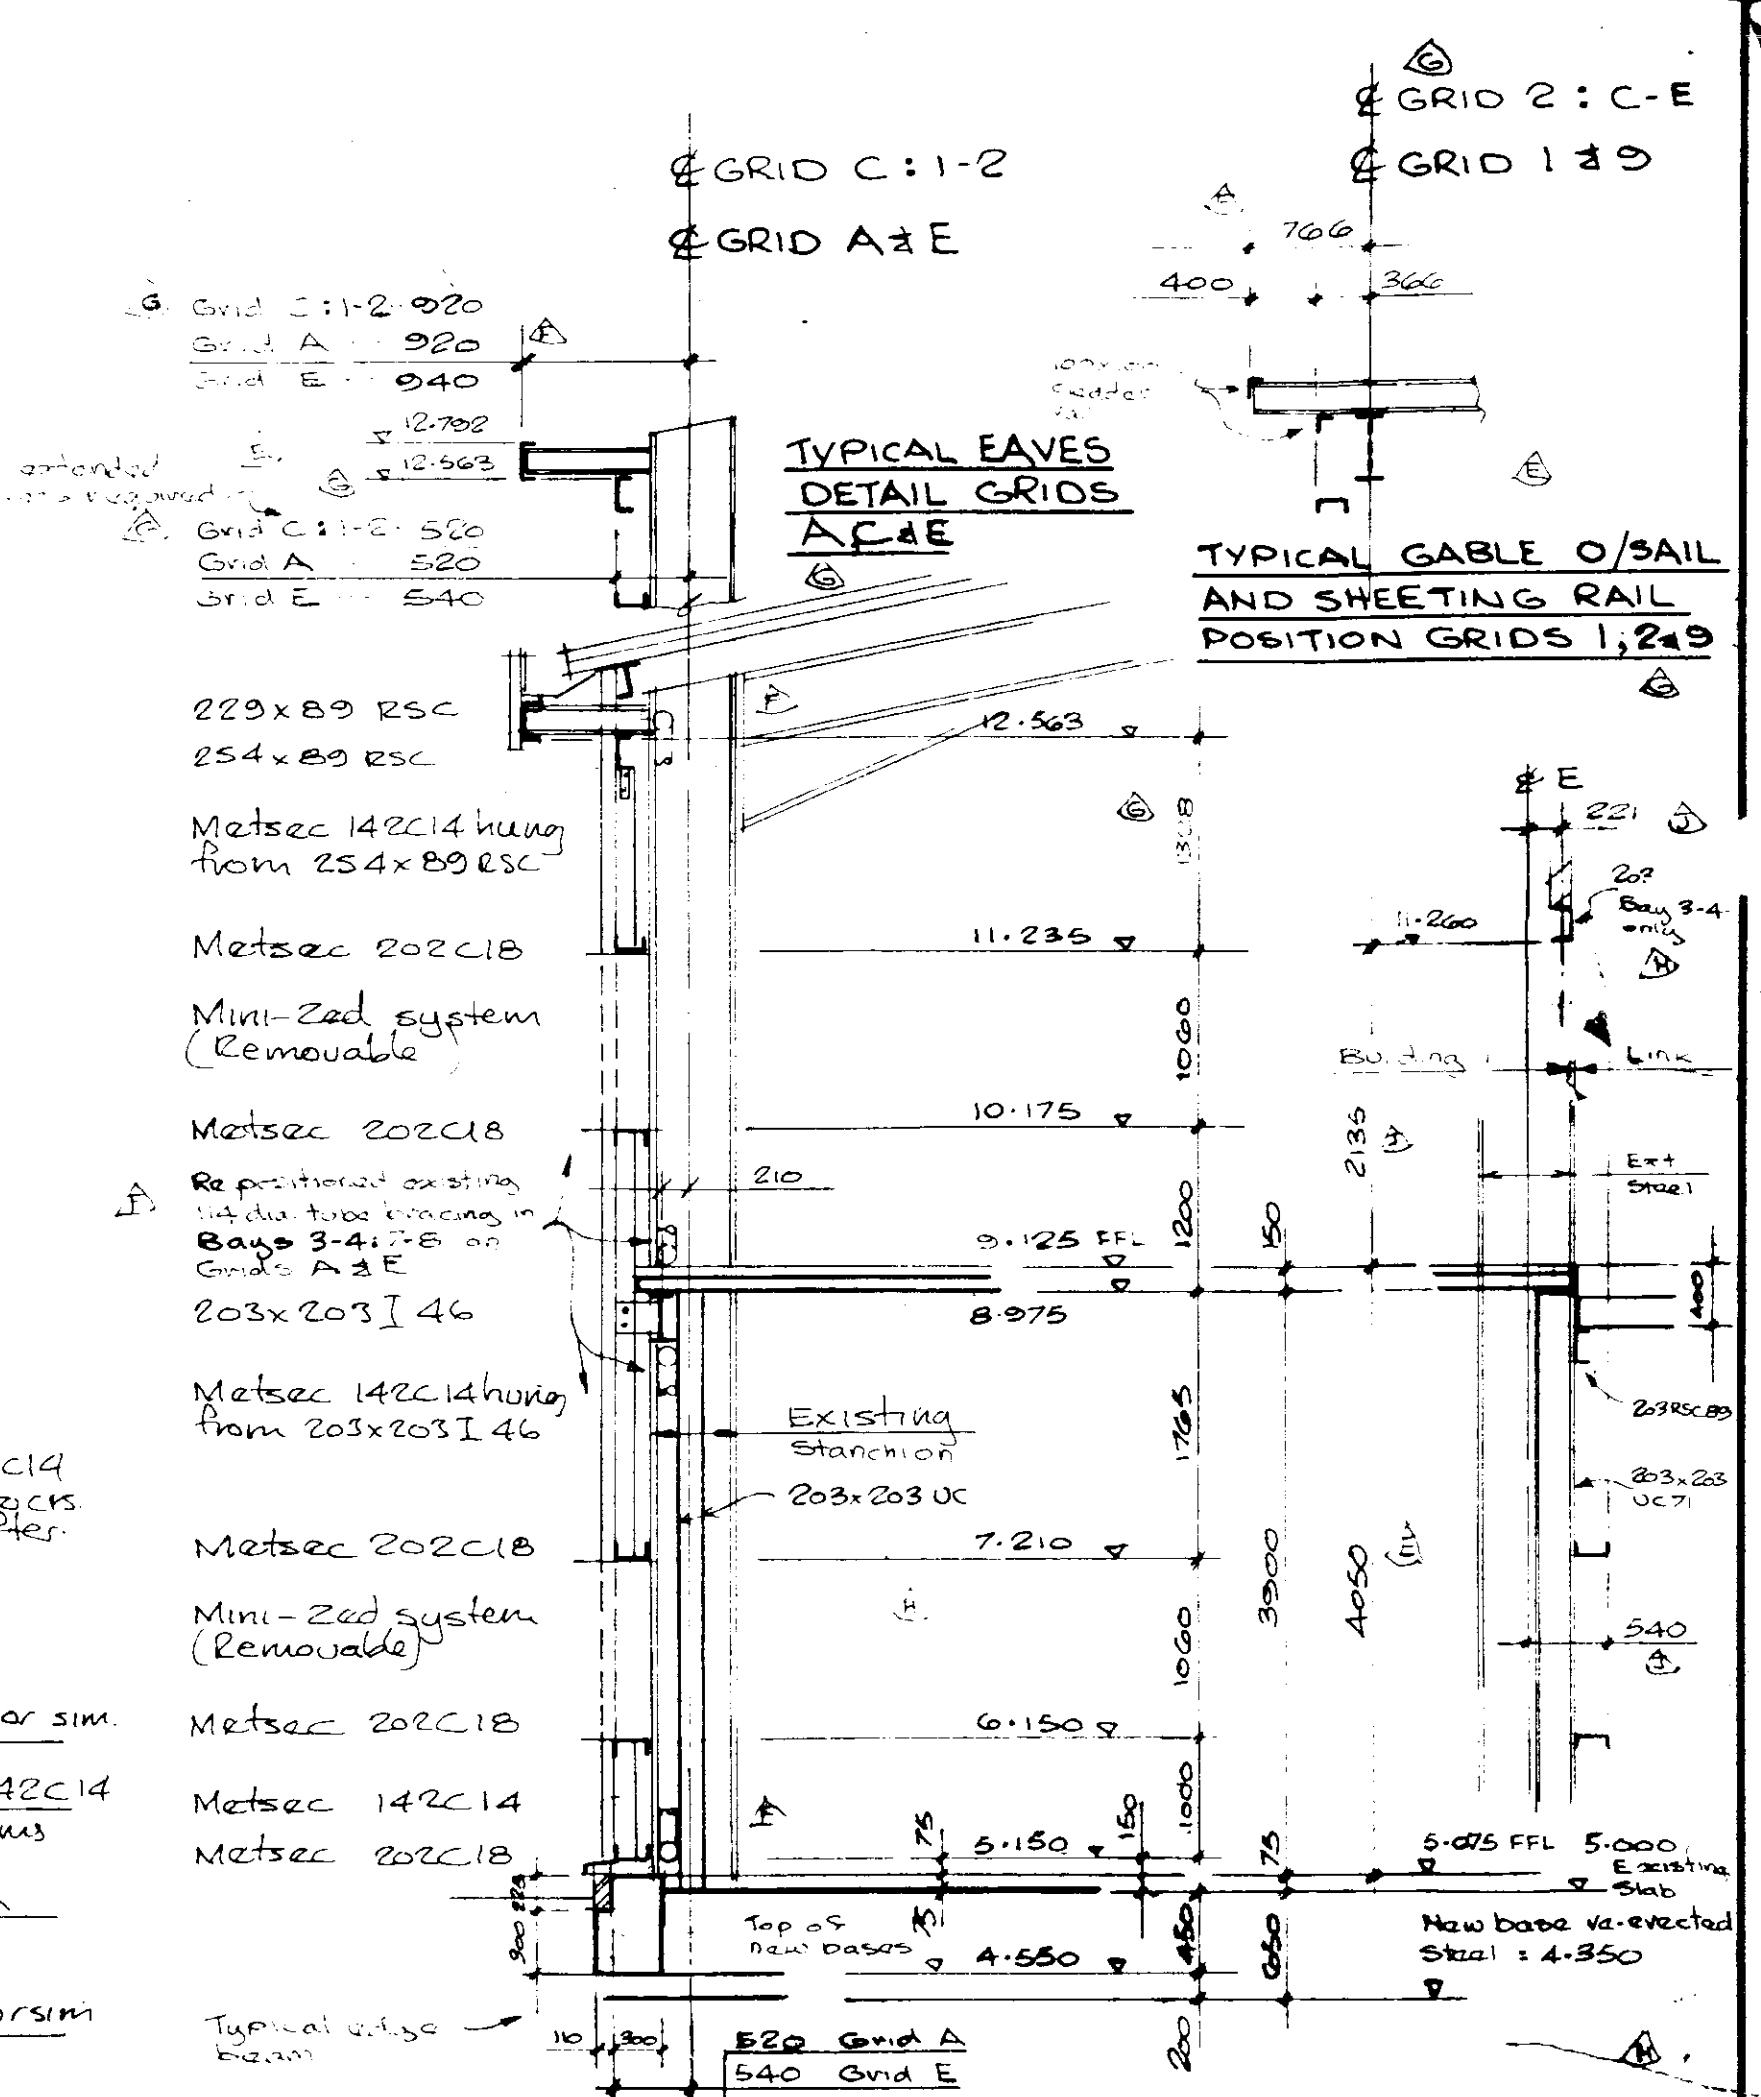

SECTION - WEST ELEVATION
(EAST ELEVATION SIMILAR)

SECTION LINE E (LINK)

- REV K. NORTH ELEV./LEVELS CORRECTED 18/1/95
- REV J. West Elev. door openings revised 18/1/95
- REV I. Section Line E. Revised 18/1/95
- REV H. Section Line E. added - door first section heights amended 18/1/95
- REV G. Dimensions & levels added to Elev. 18/1/95
- REV F. Diagonal bracing added to south wall 18/1/95
- REV E. Additional windows added Grids A/E 18/1/95
- REV D. Comments added to Section 18/1/95
- REV C. Door/windows openings 18/1/95
- REV B. North Elevation Amended 18/1/95
- REV A. General Amended 18/1/95
- REV A. East & North Elevations added 18/1/95
- South Elev. openings reduced

W.D. STONE ASSOCIATES LTD
Consulting Civil Structural and Service Engineers

Anglo City House, 2-6 Shirley Road
Southampton, Hants. SO5 3BL

WARINGS CONTRACTORS LTD.

APOLLO FIRE DETECTORS
BROOKSIDE ROAD
HAVANT.
BUILDING 1-ELEVATIONS

PAUL JONES ARCHITECTS, HAVANT, HANTS

Scale 1:100 Date JULY 95

Author 1788 17
Revision J K

RECEIVED
12 SEP 1996
DRAWING & PRINTING
REGISTRAR

RECORD COPY
DO NOT DESTROY