


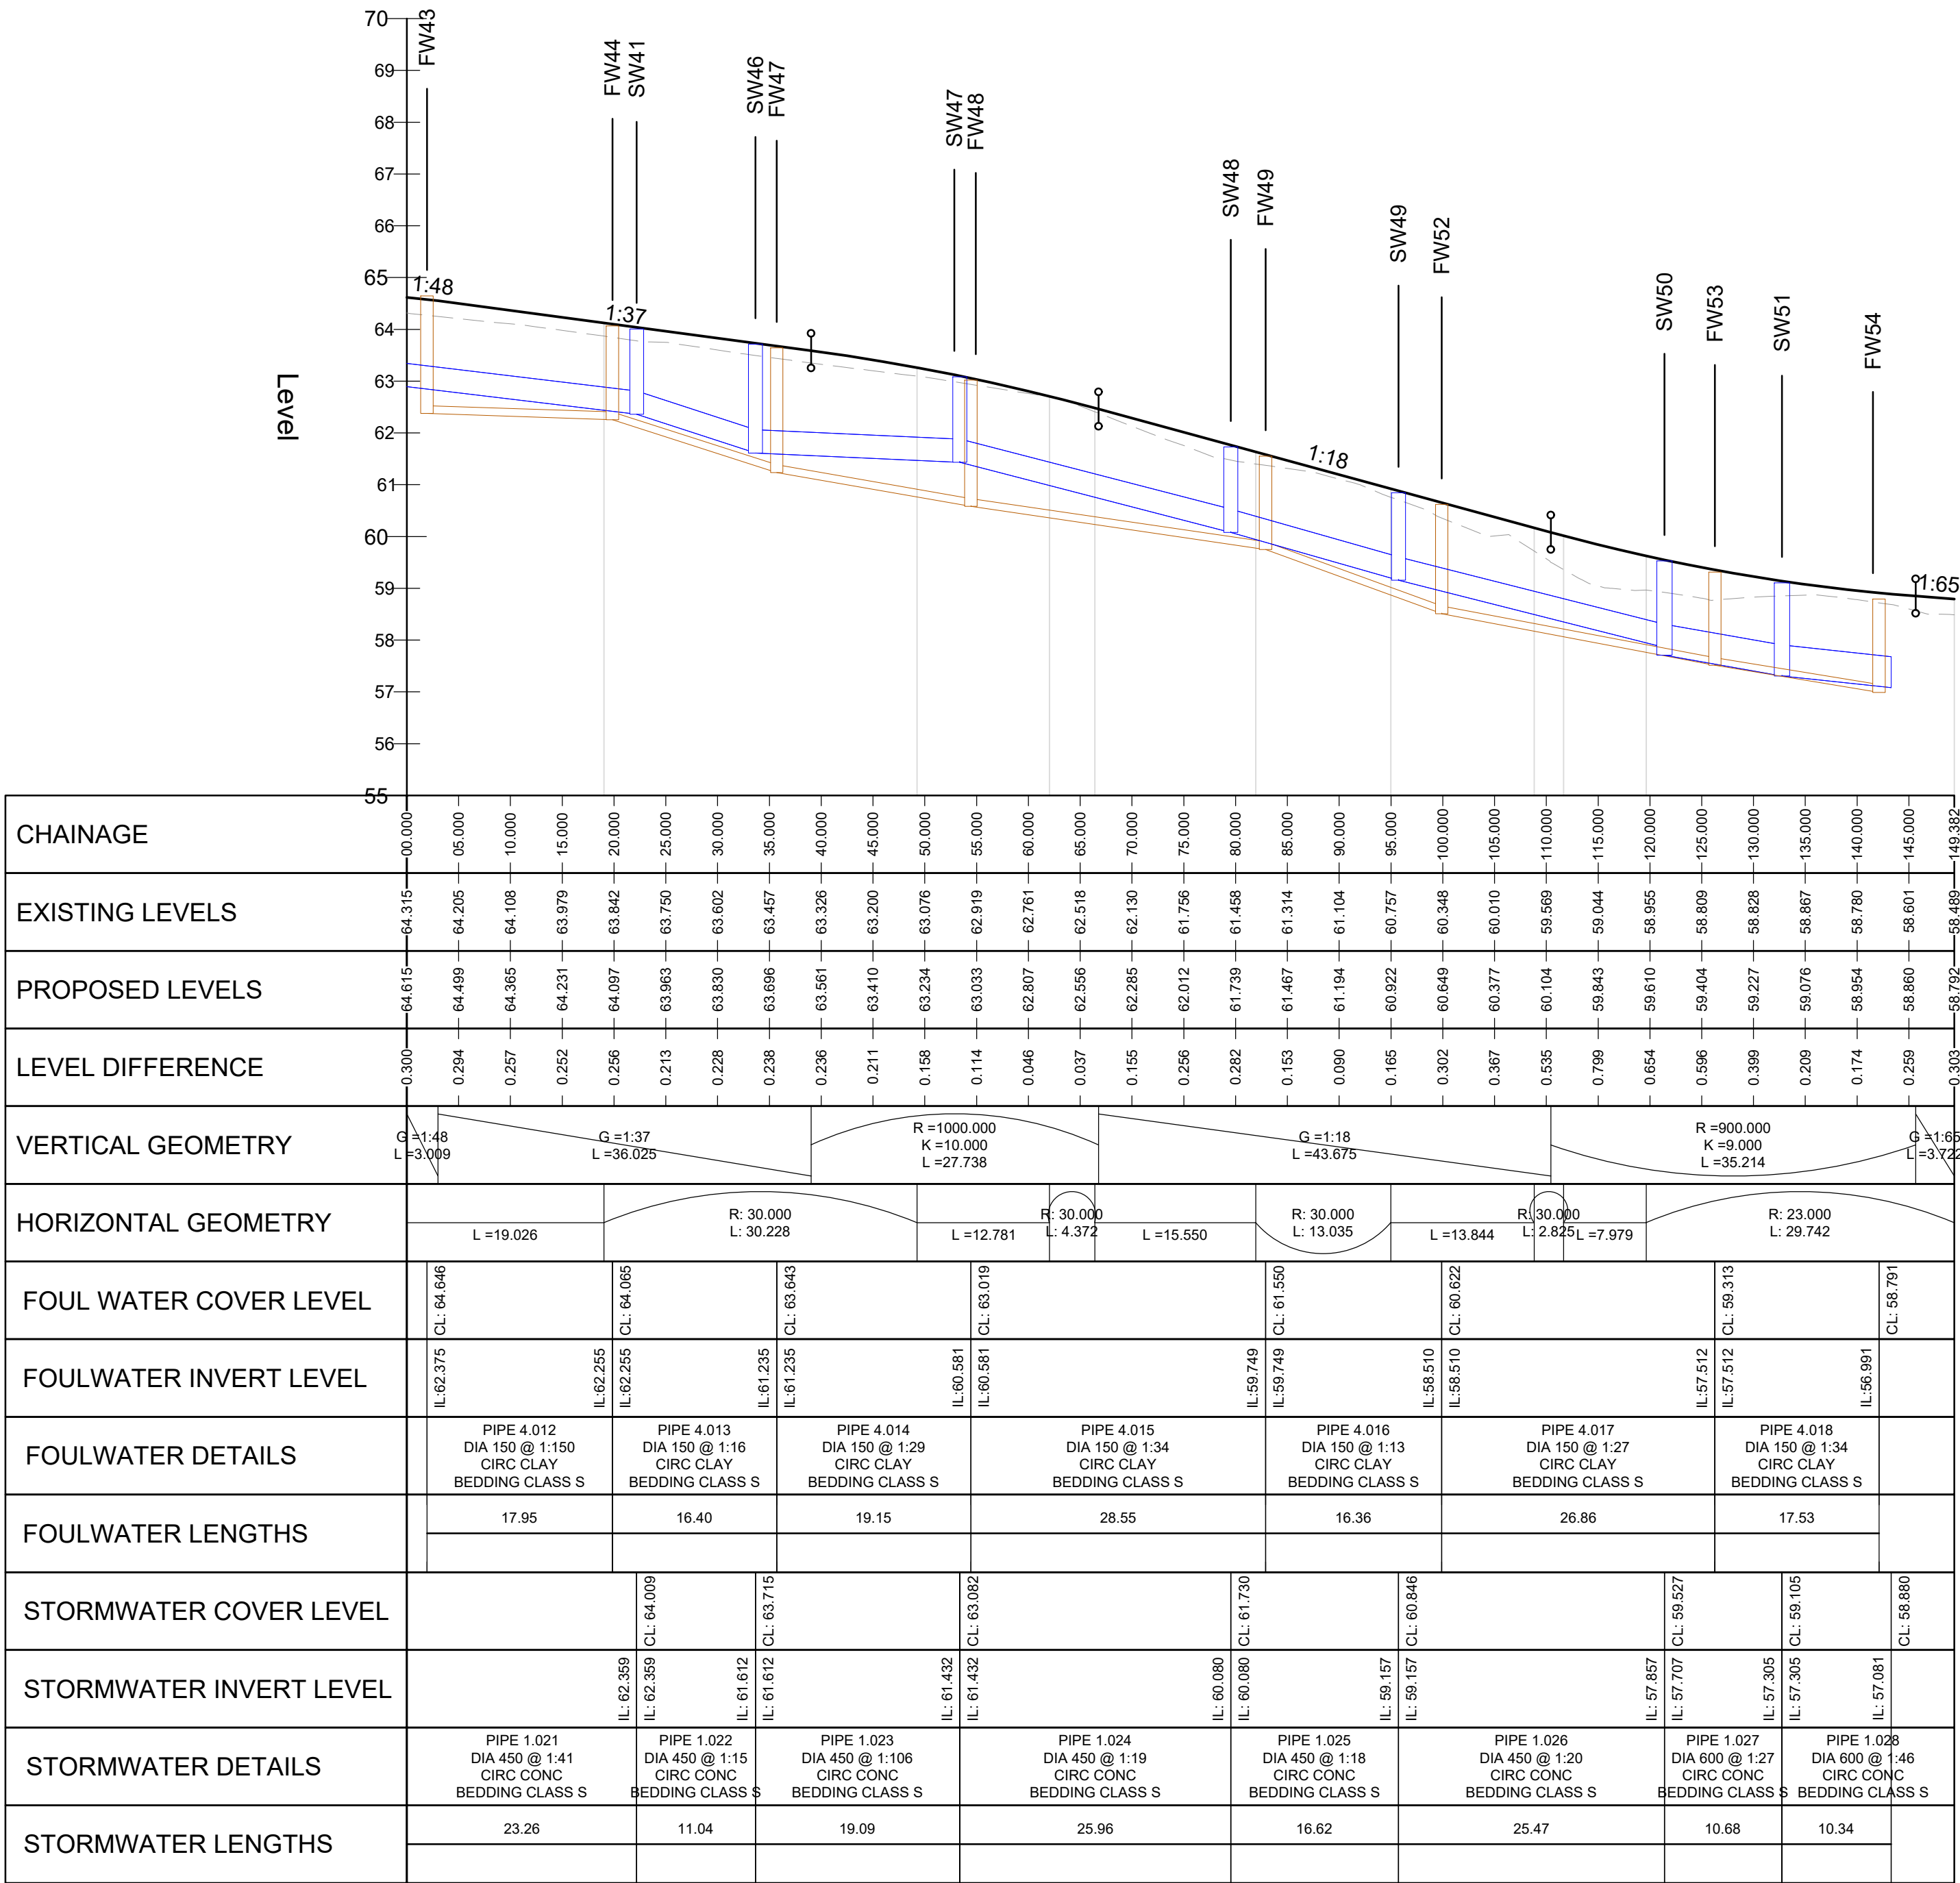

1BRD02

SCALE: H 1:500,V 1:100. DATUM: 55.000

- NOTES**
- THIS DRAWING IS TO BE READ IN CONJUNCTION WITH "SEWERS FOR ADOPTION 7th EDITION - A DESIGN AND CONSTRUCTION GUIDE FOR DEVELOPERS" PLUS ALL OTHER RELATED DOCUMENTS ISSUED BY THE ENGINEER.
 - IF THERE IS ANY AMBIGUITY BETWEEN THE DRAWINGS, THE CONTRACTOR SHALL IMMEDIATELY INFORM THE ENGINEER.
 - DO NOT SCALE FROM THIS DRAWING. WORK FROM FIGURED DIMENSIONS ONLY.
 - ALL DIMENSIONS SHOWN ON THIS DRAWING ARE IN METRES.
 - ALL DIMENSIONS, LEVELS AND SURVEY GRID CO-ORDINATES ARE TO BE CHECKED ON SITE AND THE ENGINEER NOTIFIED IMMEDIATELY OF ANY DISCREPANCIES PRIOR TO THE COMMENCEMENT OF THE WORKS.
 - NO DEVIATION FROM THE DETAILS SHOWN ON THIS DRAWING IS PERMITTED WITHOUT PERMISSION FROM THE ENGINEER.
 - CONTRACTOR TO ENSURE SMOOTH TRANSITION IN FINISHED SURFACE LEVELS BETWEEN EXISTING AND PROPOSED LEVELS.
 - FOR ADAPTABLE DRAINAGE CONSTRUCTION DETAILS REFER TO DRAWING 17-110/2012.
 - FOR HIGHWAY CONSTRUCTION DETAILS REFER TO DRAWING NUMBER 17-110/2014.
 - LATERALS TO PRIVATE AREAS NOT SHOWN ON THIS DRAWING. REFER TO ENGINEERING LAYOUTS FOR LOCATIONS AND DETAILS.

- LEGEND**
- EXISTING GROUND PROFILE
 - PROPOSED ALIGNMENT PROFILE
 - FOUL WATER SEWER AND MANHOLE
 - SURFACE WATER SEWER AND MANHOLE
 - PROPOSED ROAD GRADIENT
 - EXTRA STRENGTH VITRIFIED CLAY WITH SPIGOT AND SOCKET FLEXIBLE JOINTS TO BS EN 295.
 - FLEXIBLE JOINTED CONCRETE PIPES TO BS EN 1916:2002/BS 5911, 1:2002 CLASS 120

CAUTION TO BE TAKEN WHEN WORKING WITHIN CONFINED SPACES. REFER TO ODYSSEY'S DESIGNERS HEALTH AND SAFETY REPORT. CONTRACTOR TO UNDERTAKE RISK ASSESSMENT

CAUTION WHEN MANEUVERING DUE TO WEIGHT AND SIZE

TENDER
ISSUE

Rev	Amendments	Thr	Rm	Lh	Date
A	UPDATES TO SUIT AS BUILT INFORMATION	Thr	Rm	Lh	25.06.19

ODYSSEY

Tuscany House
White Hart Lane
Basingstoke
Hampshire RG21 4AF

Telephone: 01256 331144
Fax: 01256 331134
E: info@odysseyconsult.co.uk
W: www.odysseyconsult.co.uk

Job Title
**WOODCROFT FARM, HAVANT
PHASE 1B**

Drawing Title
**LONGITUDINAL SECTION
SHEET 3 OF 8**

Client
**Linden
HOMES**

Scale AS SHOWN	Date MAR 2019	Designed RM
Drawn THR	Checked RM	Approved LH
Job No 17-110	Drawing No 17-110/2216	Rev A