
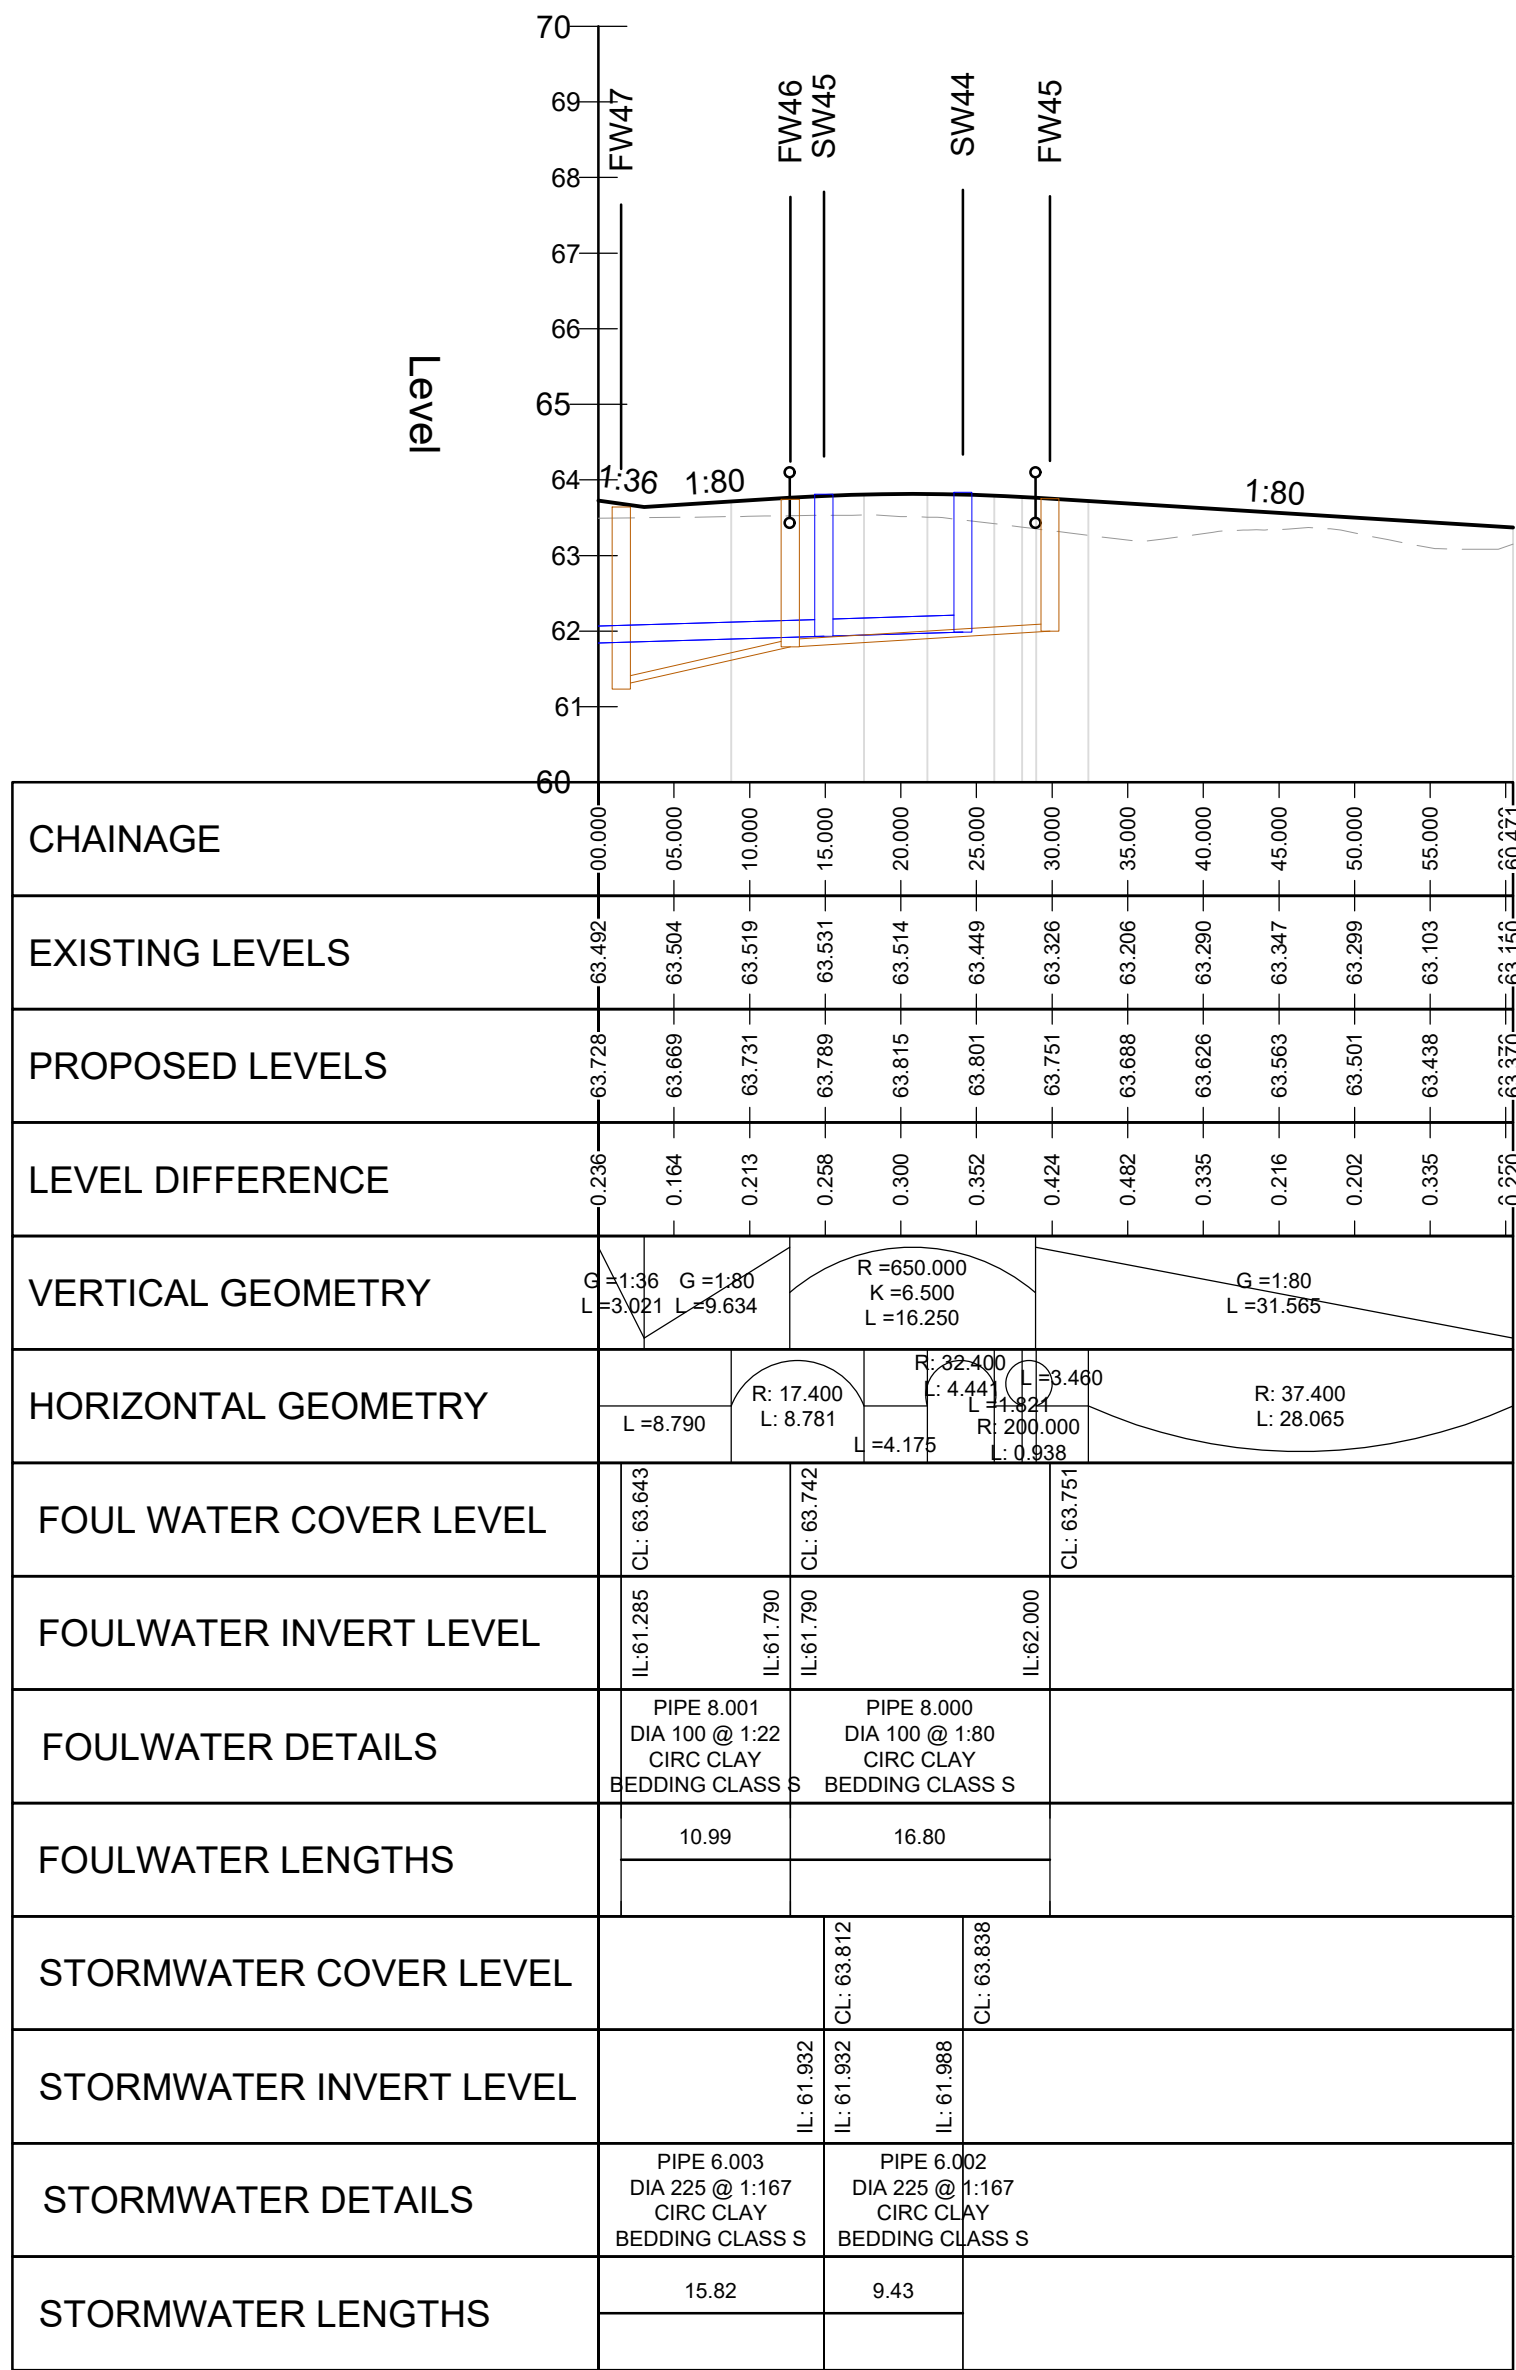
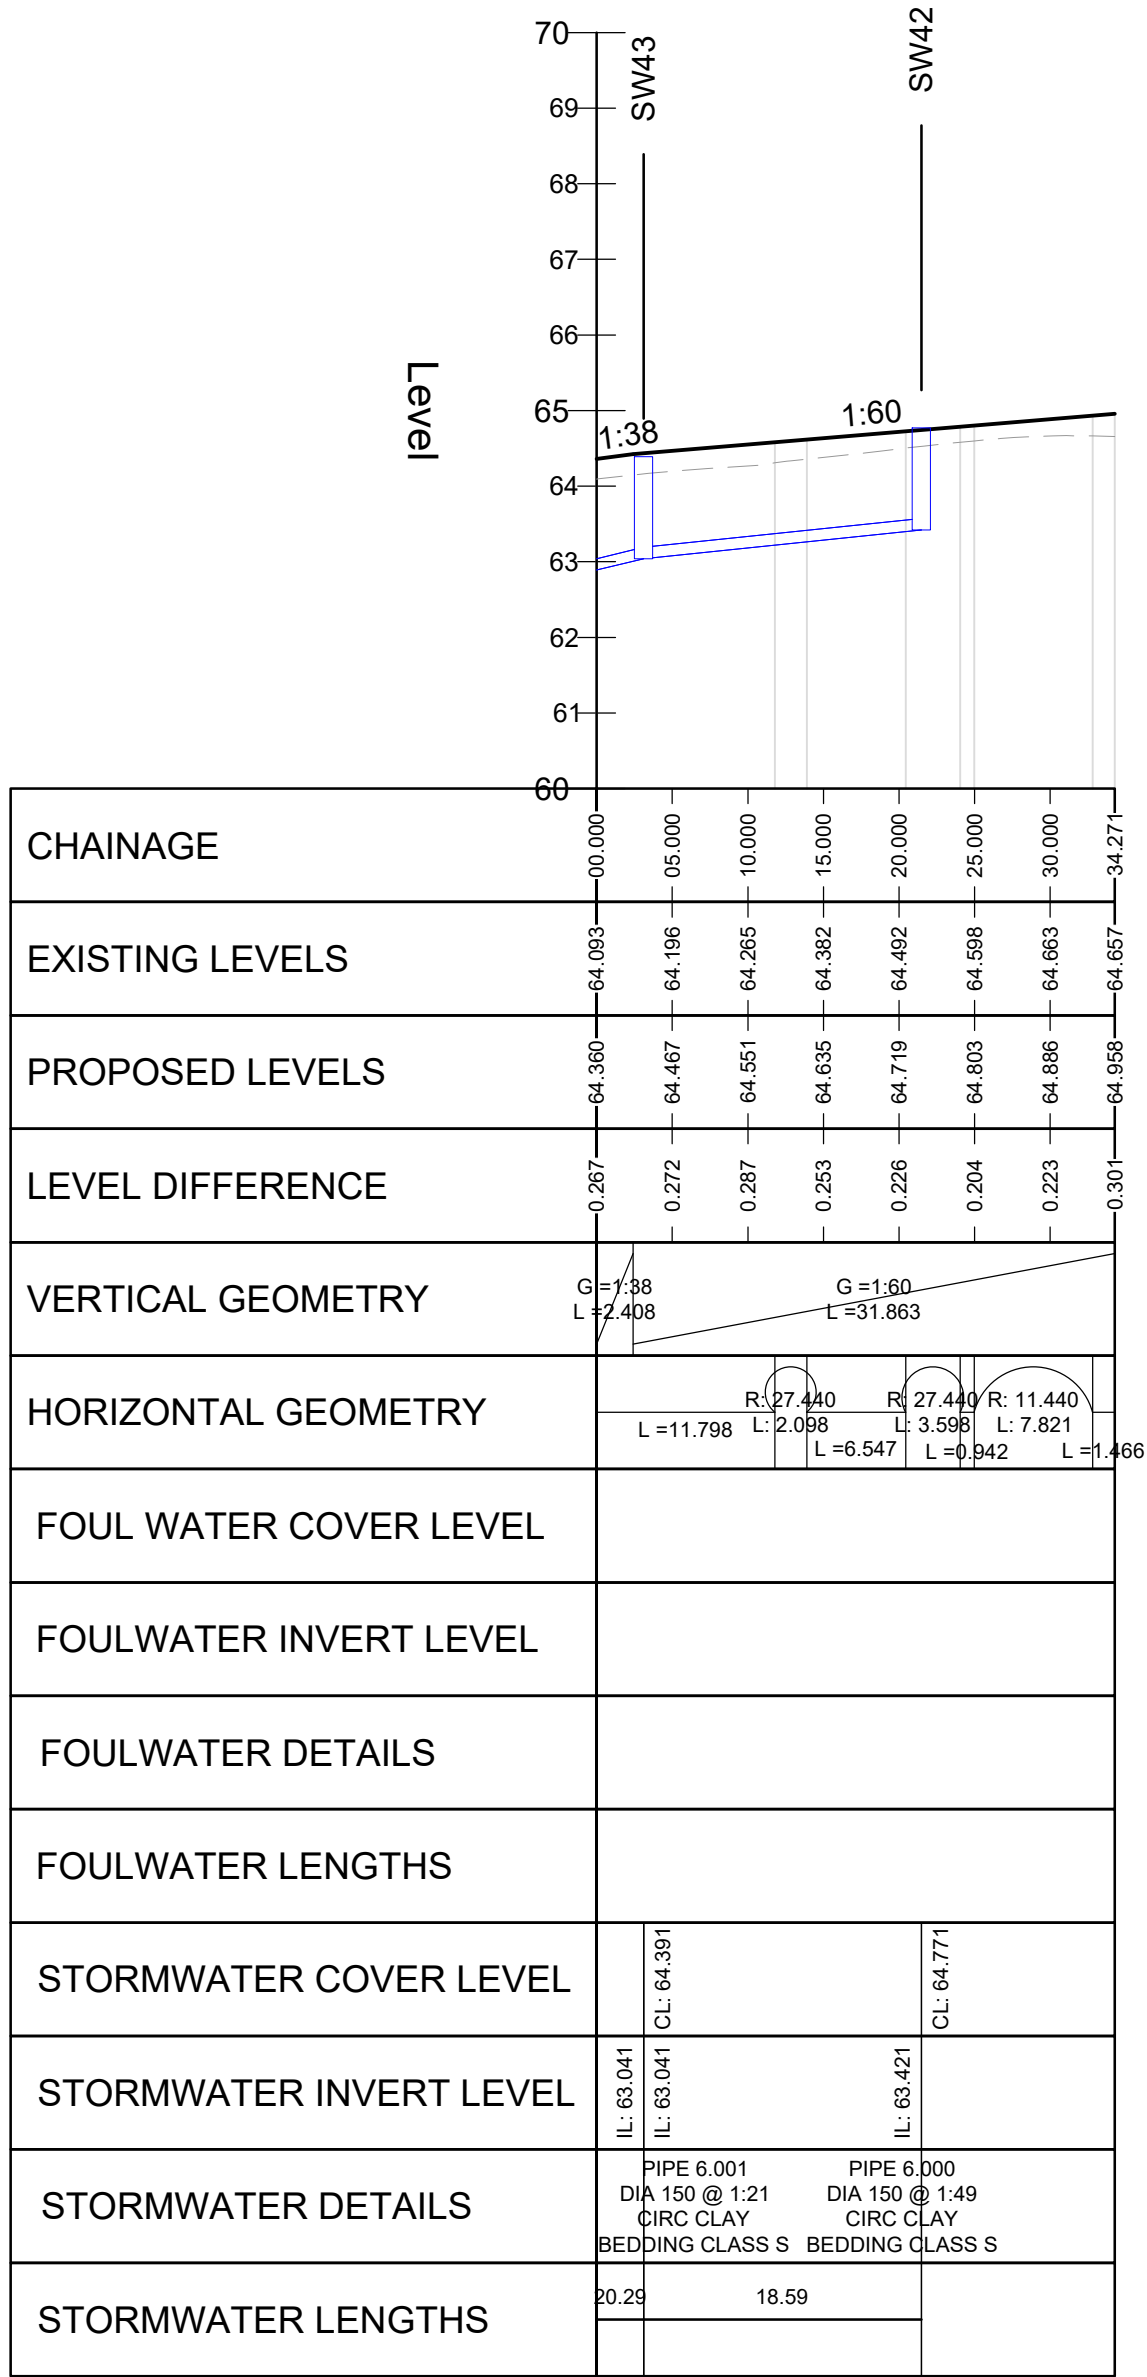


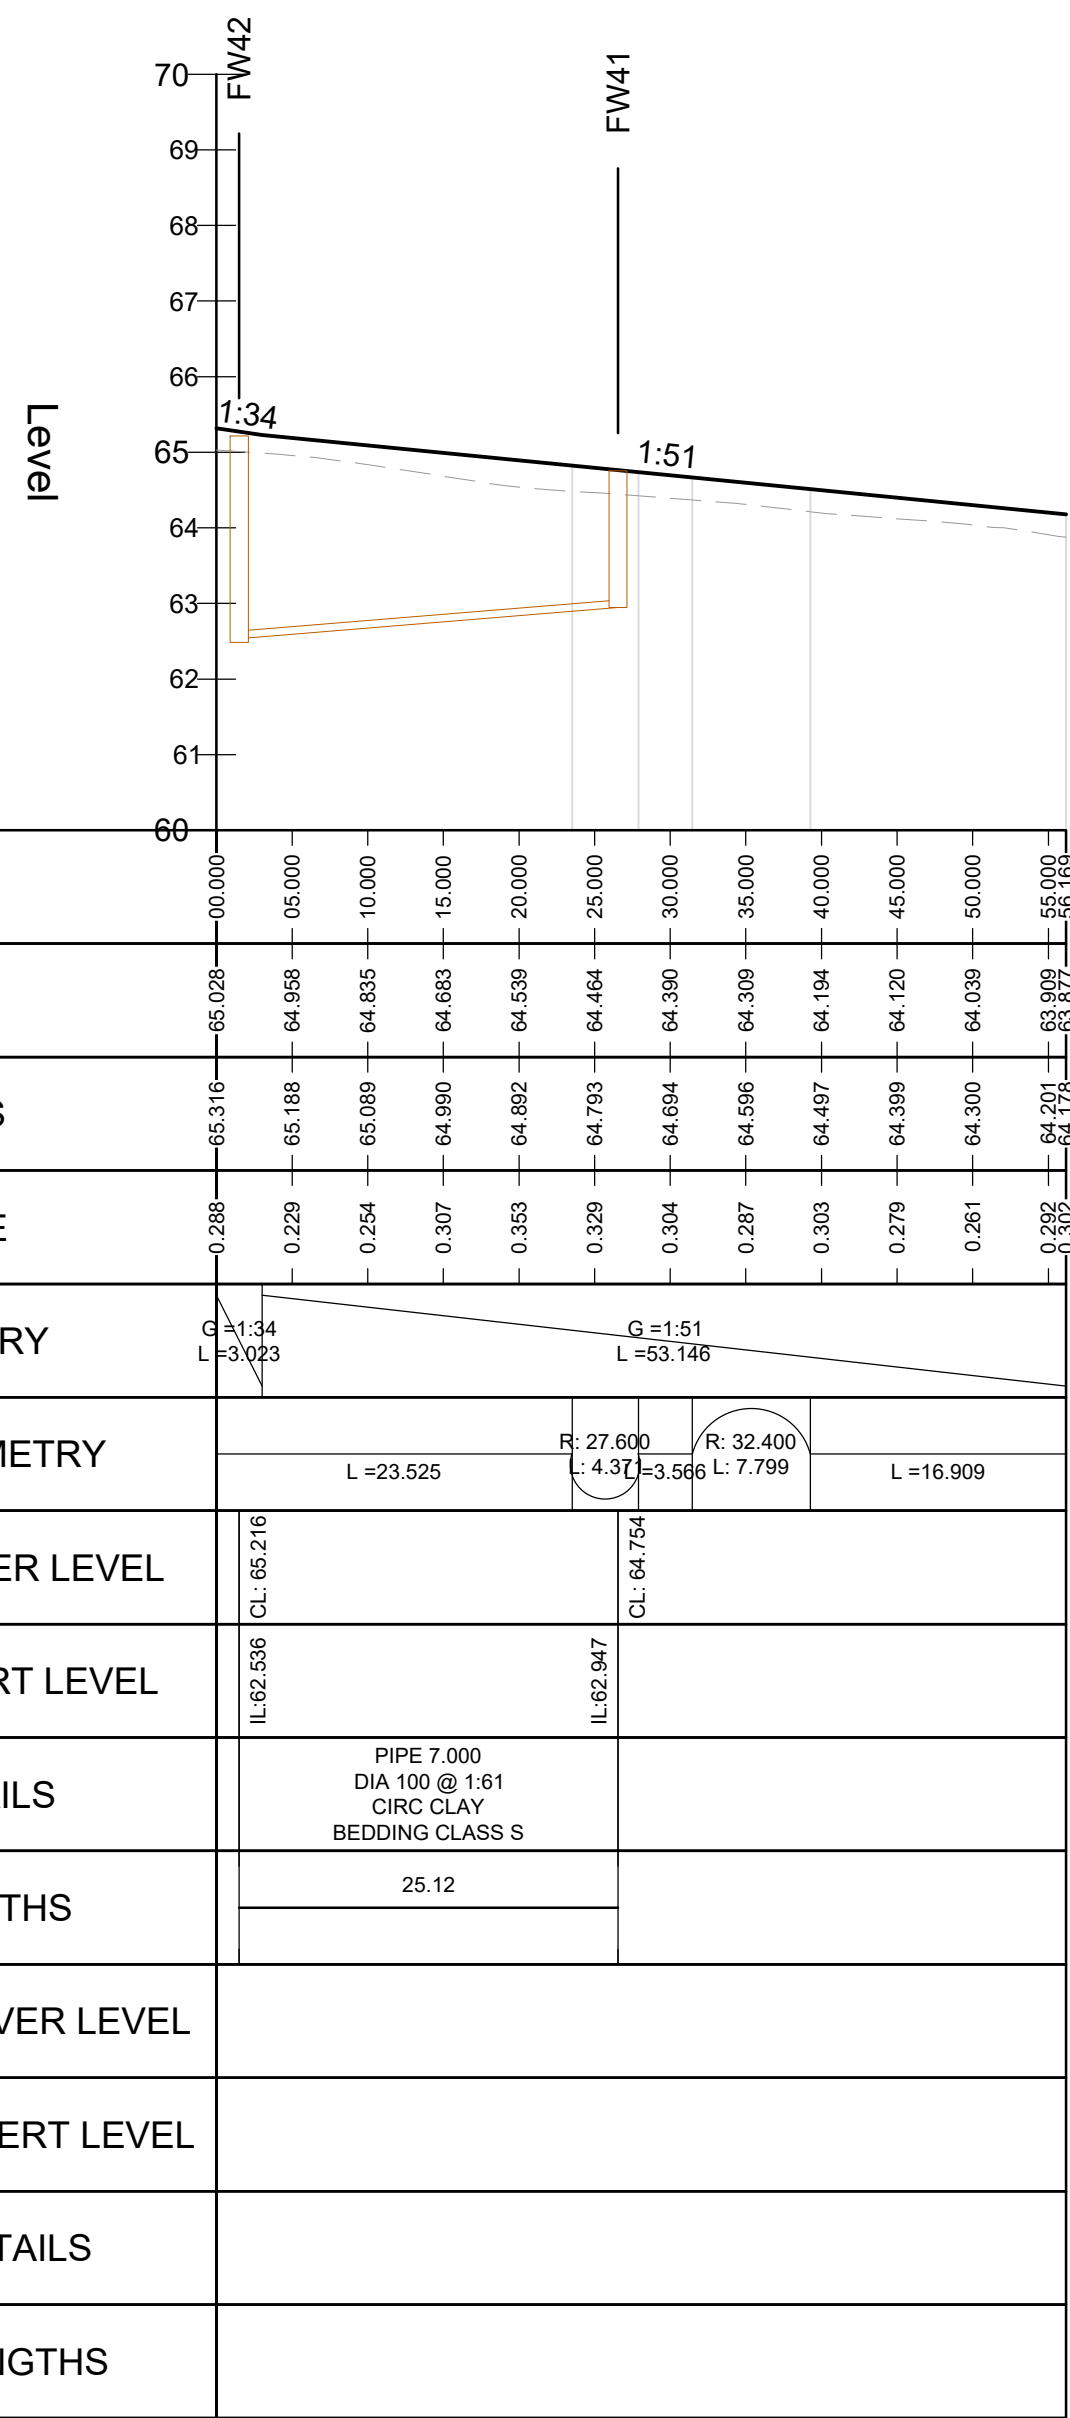

- NOTES
- THIS DRAWING IS TO BE READ IN CONJUNCTION WITH "SEWERS FOR ADOPTION 7th EDITION - A DESIGN AND CONSTRUCTION GUIDE FOR DEVELOPERS" PLUS ALL OTHER RELATED DOCUMENTS ISSUED BY THE ENGINEER.
 - IF THERE IS ANY AMBIGUITY BETWEEN THE DRAWINGS, THE CONTRACTOR SHALL IMMEDIATELY INFORM THE ENGINEER.
 - DO NOT SCALE FROM THIS DRAWING. WORK FROM FIGURED DIMENSIONS ONLY.
 - ALL DIMENSIONS SHOWN ON THIS DRAWING ARE IN METRES.
 - ALL DIMENSIONS, LEVELS AND SURVEY GRID CO-ORDINATES ARE TO BE CHECKED ON SITE AND THE ENGINEER NOTIFIED IMMEDIATELY OF ANY DISCREPANCIES PRIOR TO THE COMMENCEMENT OF THE WORKS.
 - NO DEVIATION FROM THE DETAILS SHOWN ON THIS DRAWING IS PERMITTED WITHOUT PERMISSION FROM THE ENGINEER.
 - CONTRACTOR TO ENSURE SMOOTH TRANSITION IN FINISHED SURFACE LEVELS BETWEEN EXISTING AND PROPOSED LEVELS.
 - FOR ADAPTABLE DRAINAGE CONSTRUCTION DETAILS REFER TO DRAWING 17-110/2012.
 - FOR HIGHWAY CONSTRUCTION DETAILS REFER TO DRAWING NUMBER 17-110/2014.
 - LATERALS TO PRIVATE AREAS NOT SHOWN ON THIS DRAWING. REFER TO ENGINEERING LAYOUTS FOR LOCATIONS AND DETAILS.

- LEGEND
- EXISTING GROUND PROFILE
 - PROPOSED ALIGNMENT PROFILE
 - FOUL WATER SEWER AND MANHOLE
 - SURFACE WATER SEWER AND MANHOLE
 - PROPOSED ROAD GRADIENT
 - EXTRA STRENGTH VITRIFIED CLAY WITH SPIGOT AND SOCKET FLEXIBLE JOINTS TO BS EN 295.
 - FLEXIBLE JOINTED CONCRETE PIPES TO BS EN 1916:2002/BS 5911, 1,2002 CLASS 120

- CAUTION TO BE TAKEN WHEN WORKING WITHIN CONFINED SPACES. REFER TO ODYSSEY'S DESIGNERS HEALTH AND SAFETY REPORT. CONTRACTOR TO UNDERTAKE RISK ASSESSMENT
- CAUTION WHEN MANEUVERING DUE TO WEIGHT AND SIZE

TENDER
ISSUE

A	UPDATES TO SUIT AS BUILT INFORMATION	THR	RM	LH	25.06.19
Rev	Amendments				Date

ODYSSEY

Tuscany House
White Hart Lane
Basingstoke
Hampshire RG21 4AF

Telephone: 01256 331144
Fax: 01256 331134
E: info@odysseyconsult.co.uk
W: www.odysseyconsult.co.uk

Job Title
WOODCROFT FARM, HAVANT
PHASE 1B

Drawing Title
LONGITUDINAL SECTION
SHEET 5 OF 8

Client
**Linden
HOMES**

Scale AS SHOWN	Date MAR 2019	Designed RM
Drawn THR	Checked RM	Approved LH
Job No 17-110	Drawing No 17-110/2218	Rev A