

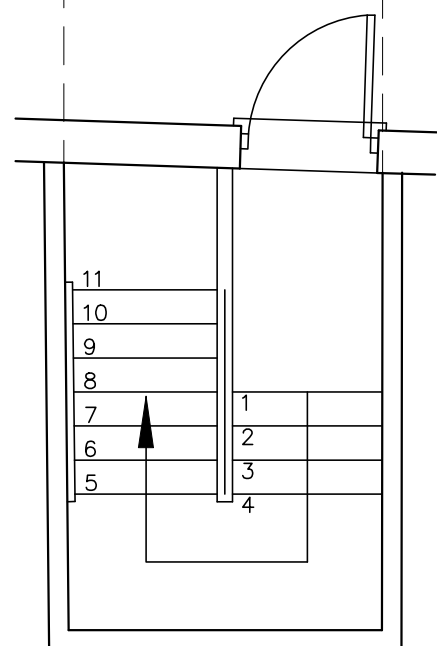


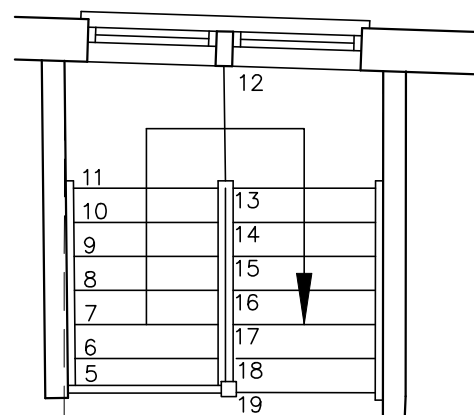


Existing Staircase
Ground to First

Existing Hallway Survey

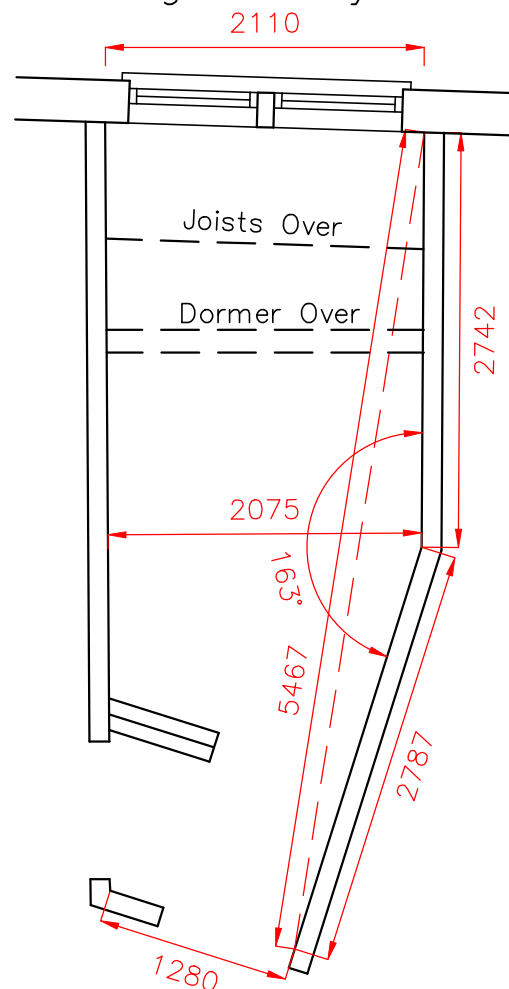


Ad Built Staircase FF

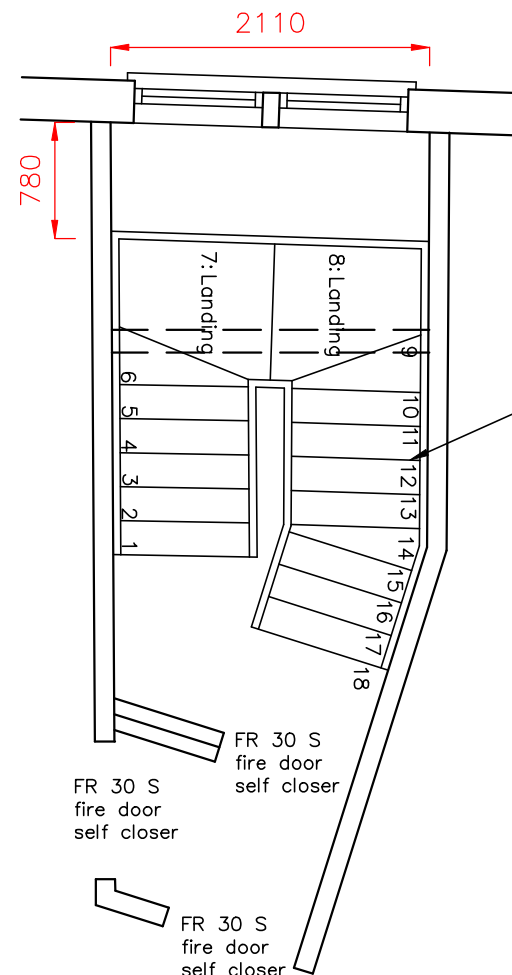


Proposed Staircase:
18 Treads
950 Width
225 Going

Tread 1-6:
185 Rise

Tread 8-19
184.1 Rise

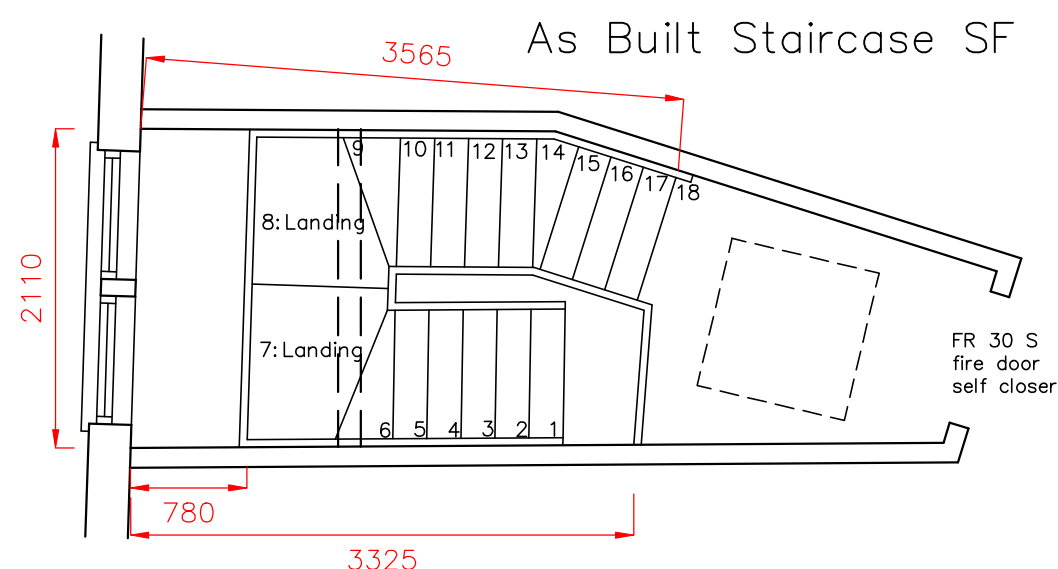

As Built Section

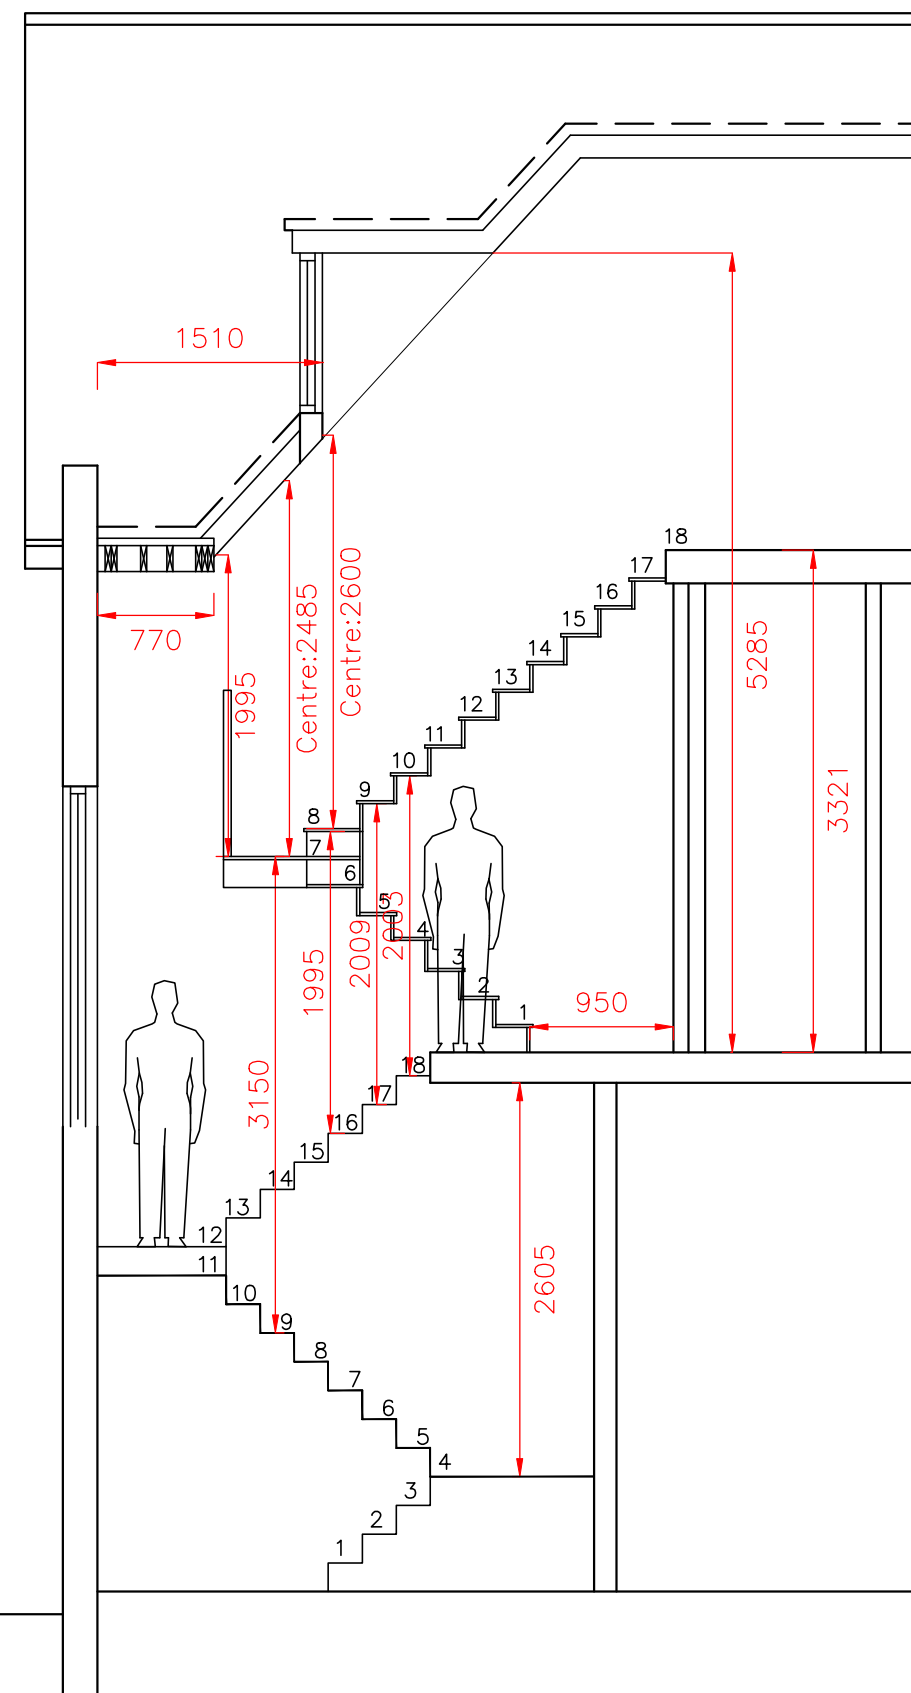

CAD

Critchley Architecture And Design Ltd.
Contact: 02392 474 919 | info@caad.online

The Old Brewery, 15E South Street, Havant, PO9 1BU



Main Staircase Details: As Built 2019

Revisions	a) Note/Date/Initial
b)	
c)	
d)	

Flats 1-5
White Hart Court
1 East Street
Havant
PO9 1AA

Scale A1=1:25, A3=1:50
Drawn SAR
Date 29/03/19

17094-660⁰

5m

10m

15m

20m