


0 1m 2m 3m

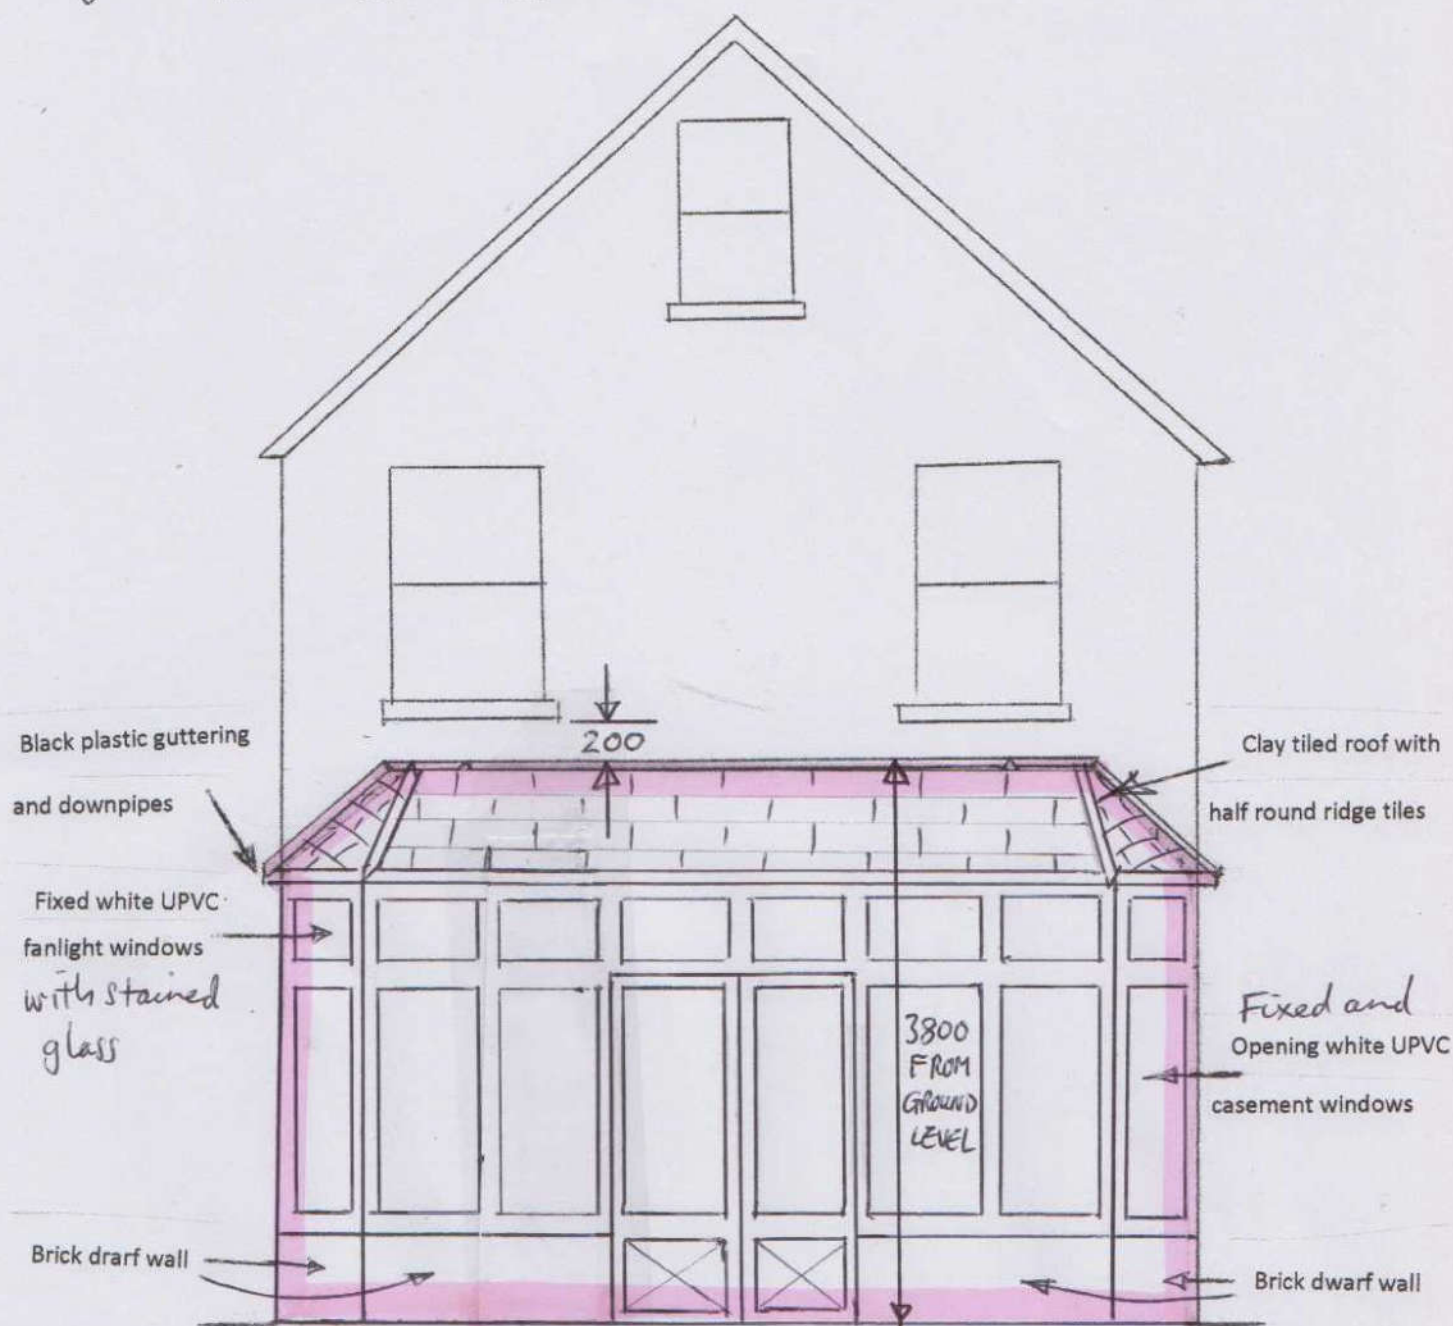

NOTES

All windows and doors to have a nominal width of 850mm

Glazed UPVC French Windows with solid lower panels.

24 Grove Road, proposed rear extension

Drawing no: ~~7A~~ 7B Proposed rear elevation

1ST MAY

Scale 1 in 50 at A4 size. ~~16th~~ February 2018.