

DRIFTWOOD CAFE, 44 HIGH STREET, EMSWORTH
AS BUILT

NOTES:


Dimensions to be checked on site before commencing work.
Any discrepancies shall be reported to the architect immediately.

Do not scale from these drawings except for planning purposes.


Use figured dimensions only.

Where applicable this drawing is to be read in conjunction with other consultants' drawings.


All drawings to be read in conjunction with specification and all other drawings including structural engineer and mechanical and electrical drawings / specification

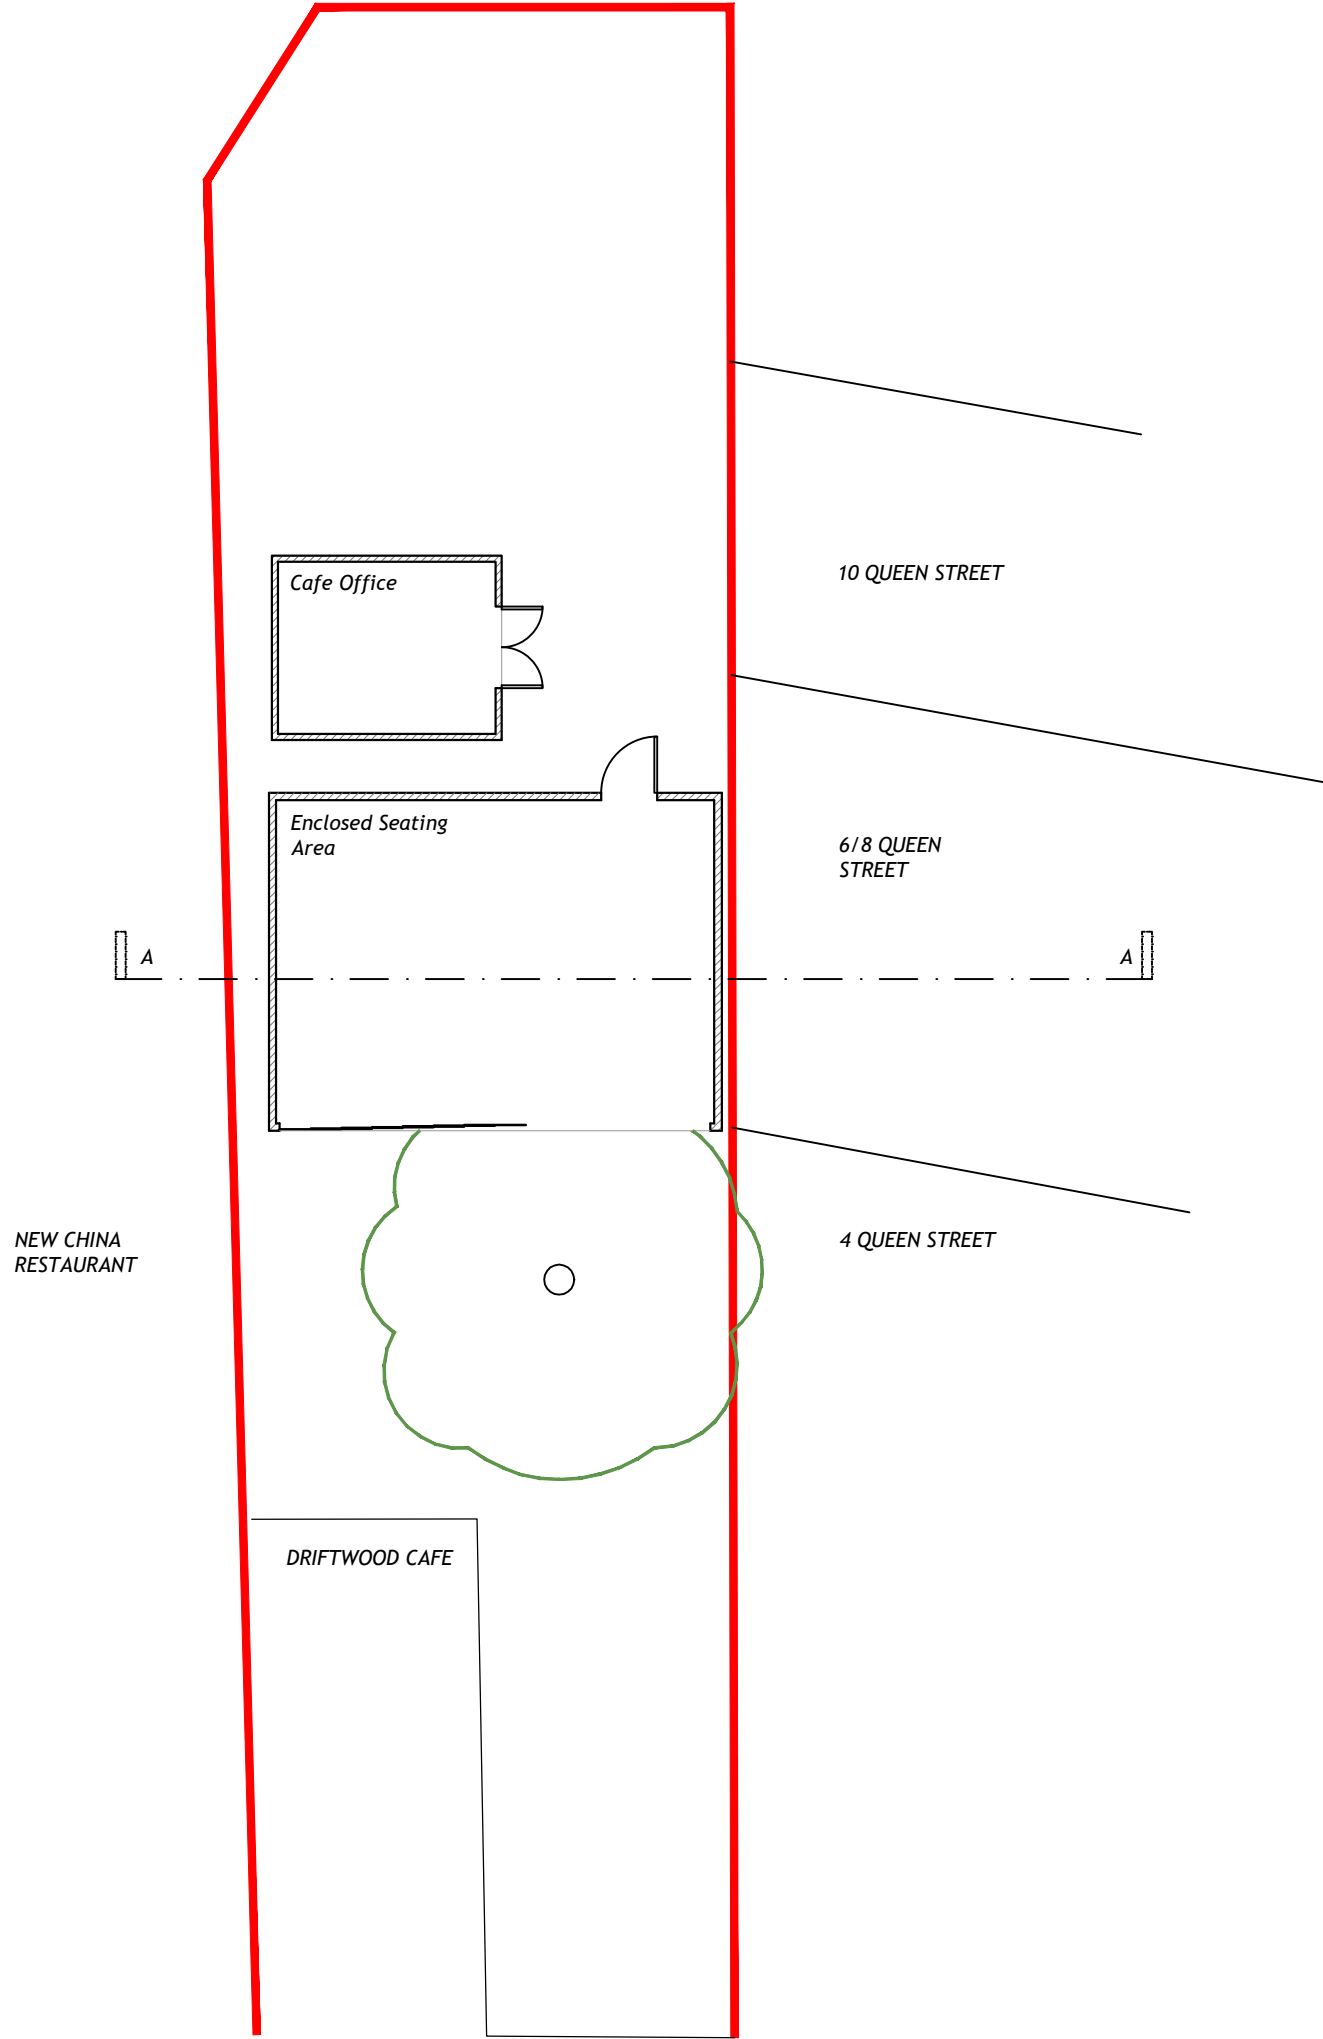


GROUND FLOOR PLAN
1:100

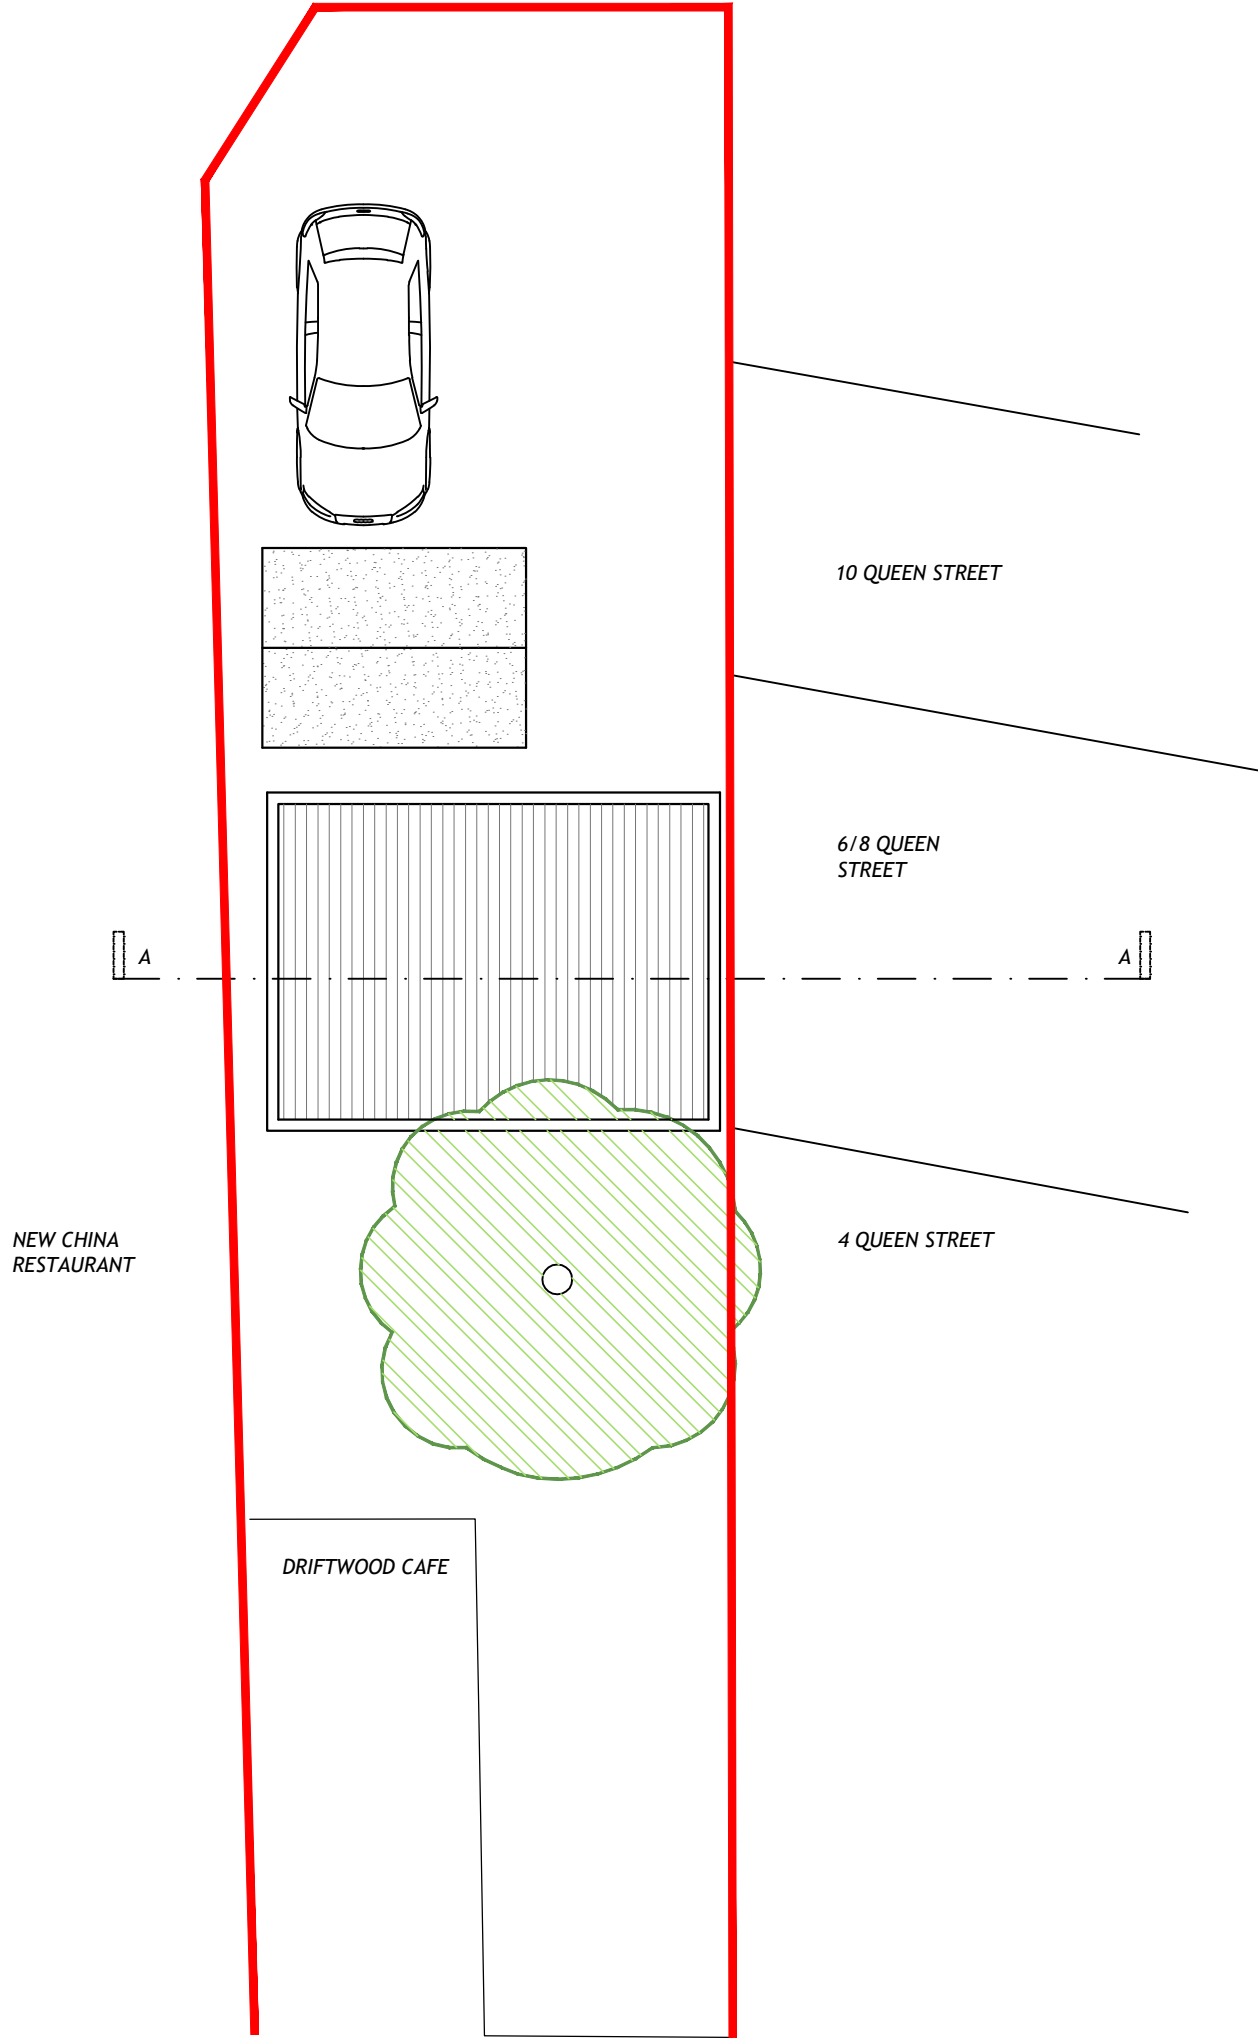


ROOF PLAN
1:100

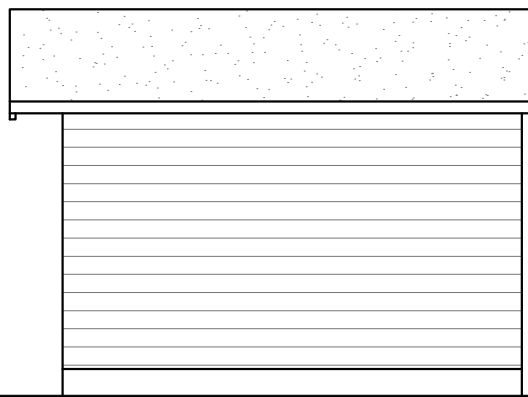


EAST ELEVATION (SHED)
1:100

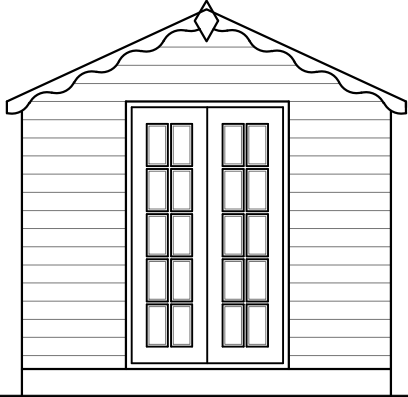


SOUTH ELEVATION (SHED)
1:100

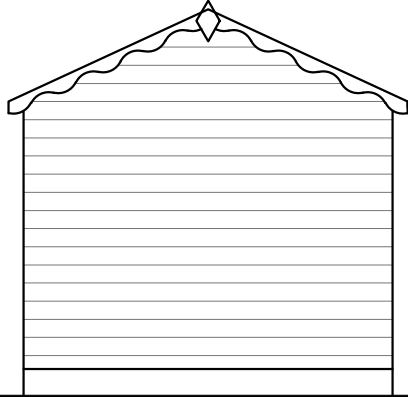


NORTH ELEVATION (SHED)
1:100

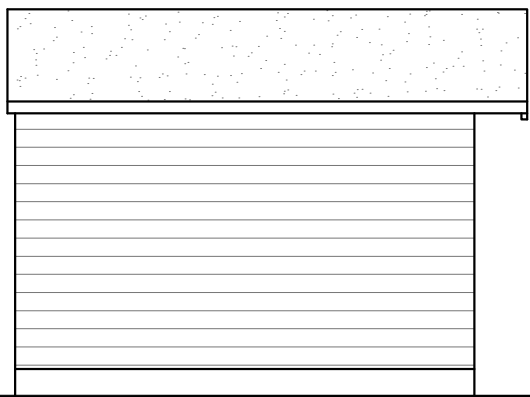


WEST ELEVATION (SHED)
1:100

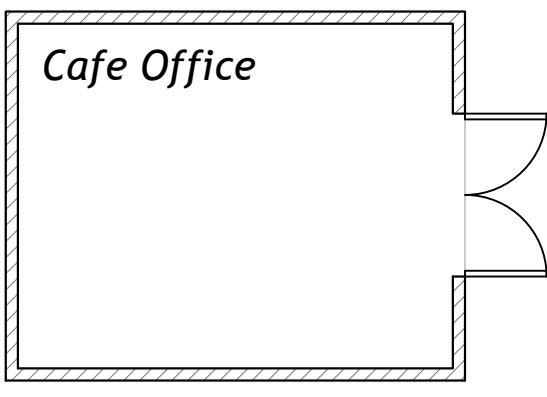

FLOOR PLAN (SHED)
1:100

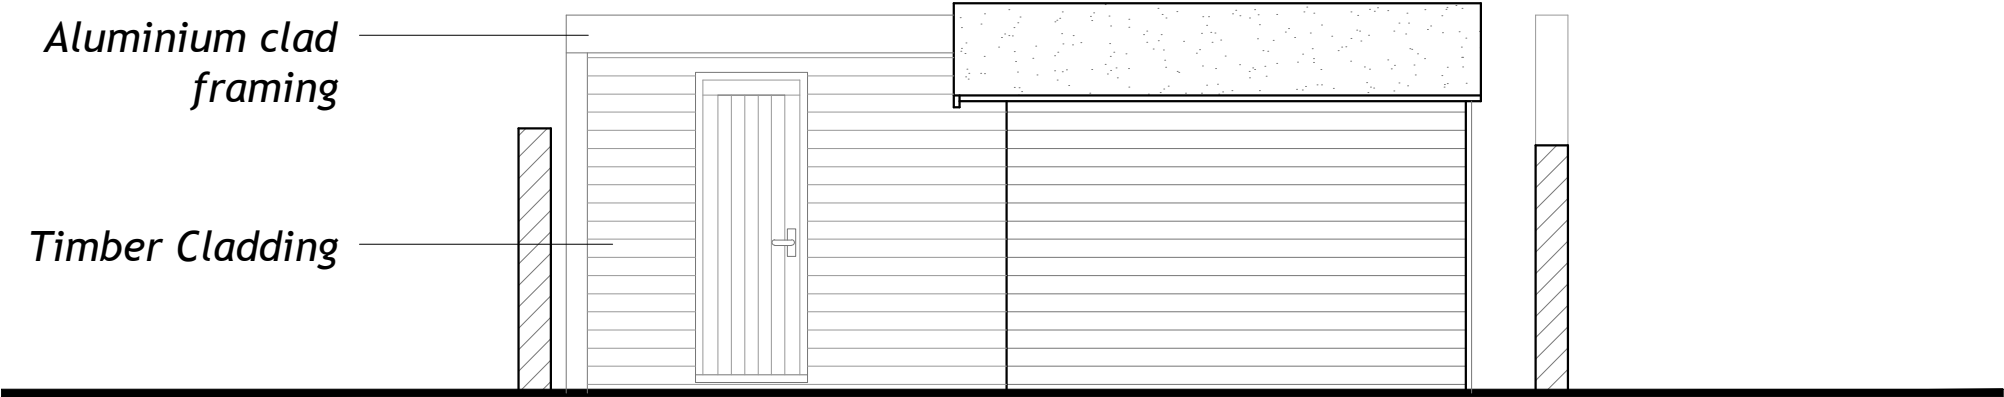

REAR ELEVATION
[east] 1:100

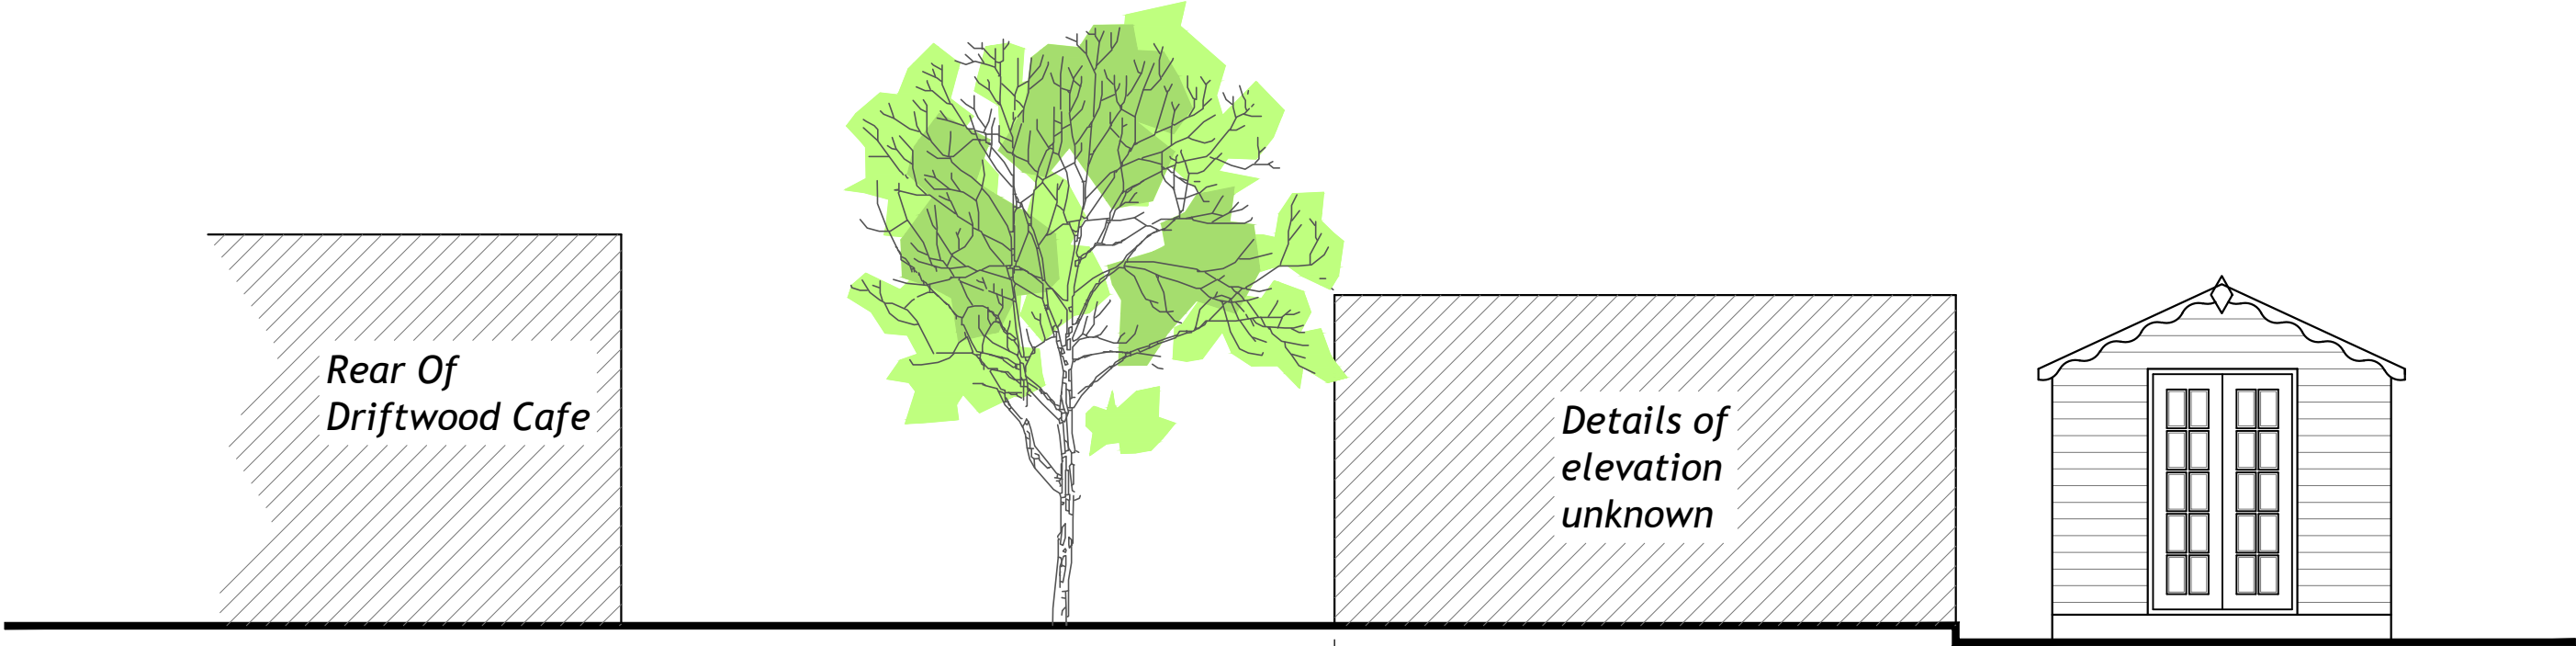

SIDE ELEVATION
[south] 1:100

REV	DATE	AMENDMENT	DRAWN

hd
architects

Helyer Davies Architects Ltd
1 The Old Flour Mill,
Emsworth, PO10 7BT
01243 370 715
www.hdarchitects.co.uk mail@hdarchitects.co.uk

PROJECT
Driftwood Cafe
44 Highstreet
Emsworth
PO10 7AW

DRAWING
As Built Plans
As Built Elevations
Shed Elevations

SCALE
as noted @A1

DATE	July 2018	DRAWN	JF
DRAWING NUMBER	18112-03	REVISION	*