
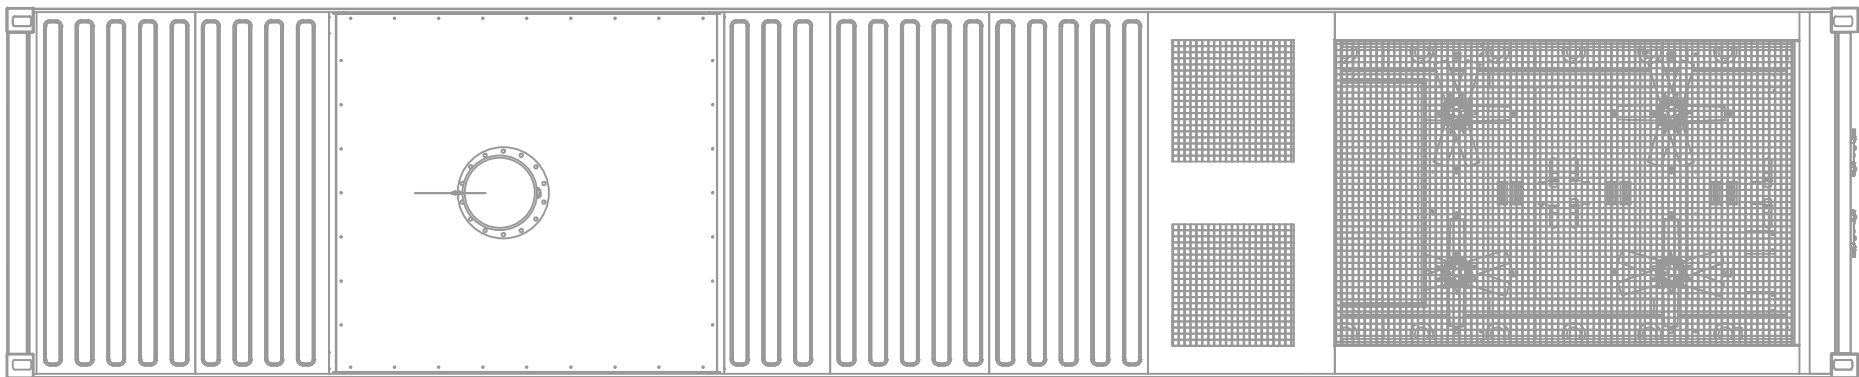
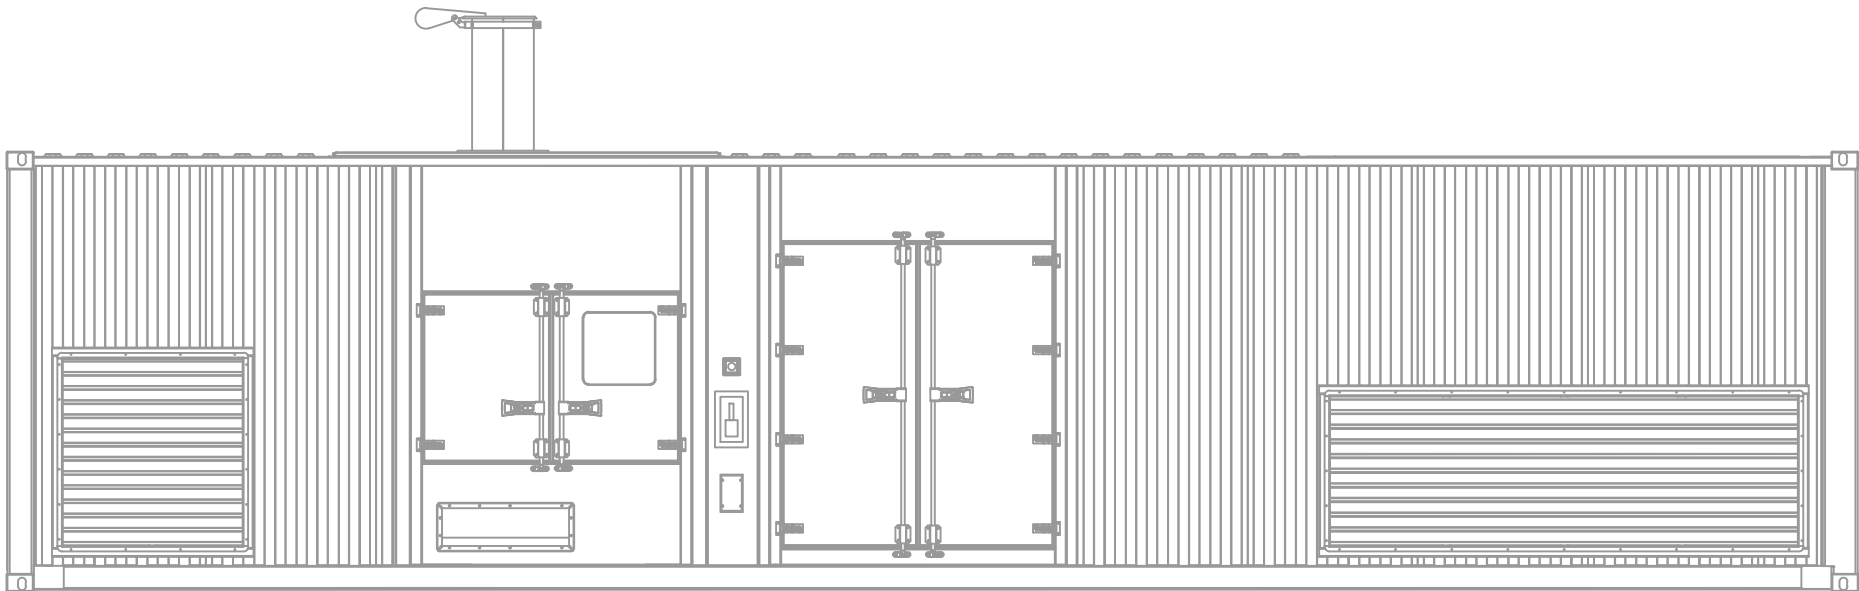
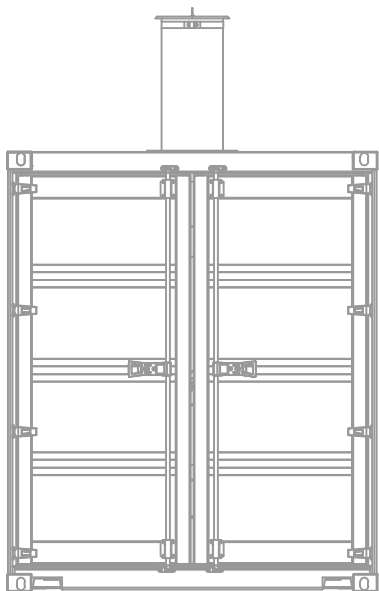


General Arrangement

Specification

Notes :-

Rev	Date	Description

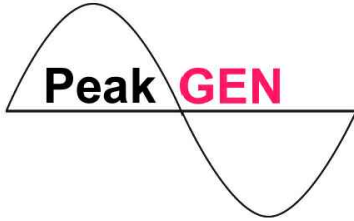

Peak Gen Power Ltd
Gables Lodge, 62 Kenilworth Road
Leamington Spa
CV32 6JX

Project
SCR Installation

Drawing Title
Container Without
SCR_ As Built

Client

Drawn By DL	Date 01/05/18	Scale 1:50
Checked By DL	Date 01/05/18	Ref
Drawing Number PG-GA-01		Rev A