



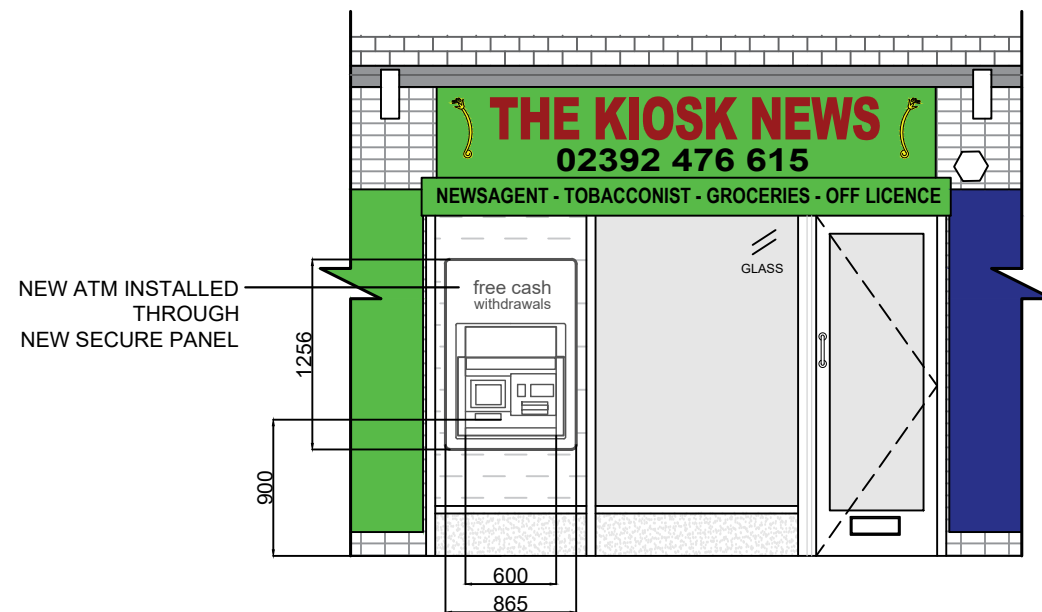

AS INSTALLED FRONT ELEVATION

Scale 1:50

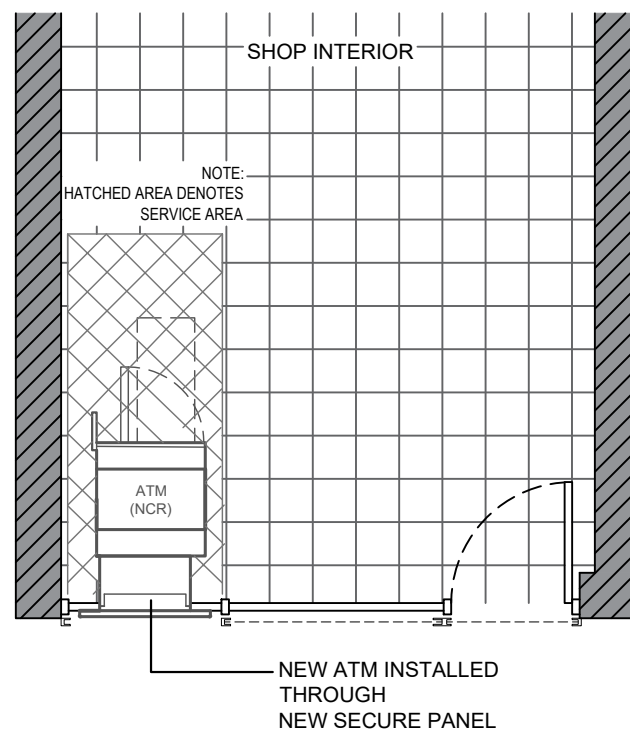

AS INSTALLED PART PLAN

Scale 1:50

Date:	Comments:	By:
-------	-----------	-----

GENERAL NOTES:
1) All dimensions in millimeters unless otherwise stated.

Site:
Kiosk News
43 Greywell Road
Havant
PO9 5AH

Drawing Title:
As Installed Plan and Elevation

Ref:	Date: 04/09/2017	Rev:
Scale: 1:50	Paper: A3	Date Rev: